

LEGEND

□

INLET

□

CATCH BASIN

○

MANHOLE

== == ==

STORM SEWER

■


ASPHALT

▨

CONCRETE

▩


RIP RAP

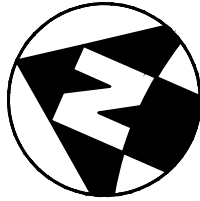

CENTRE PARK, LLC
O.R. 8765 PG 1212

UNION CENTRE INNKEEPERS, LLC
O.R. 8618 PG. 520
5.210 AC.
S.R. 45-116

DESIGNATION	HIGHWATER ELEVATION (FT. ABOVE MSL)	PRE-DEV Q1 (CFS)	PRE-DEV Q10 (CFS)	POST-DEV Q100 (CFS)	REQUIRED STORAGE VOLUME (CF)	AS-BUILT STORAGE VOLUME (CF)
DETENTION BASIN	599.60	2.91	8.37	3.57	76,965	57,923

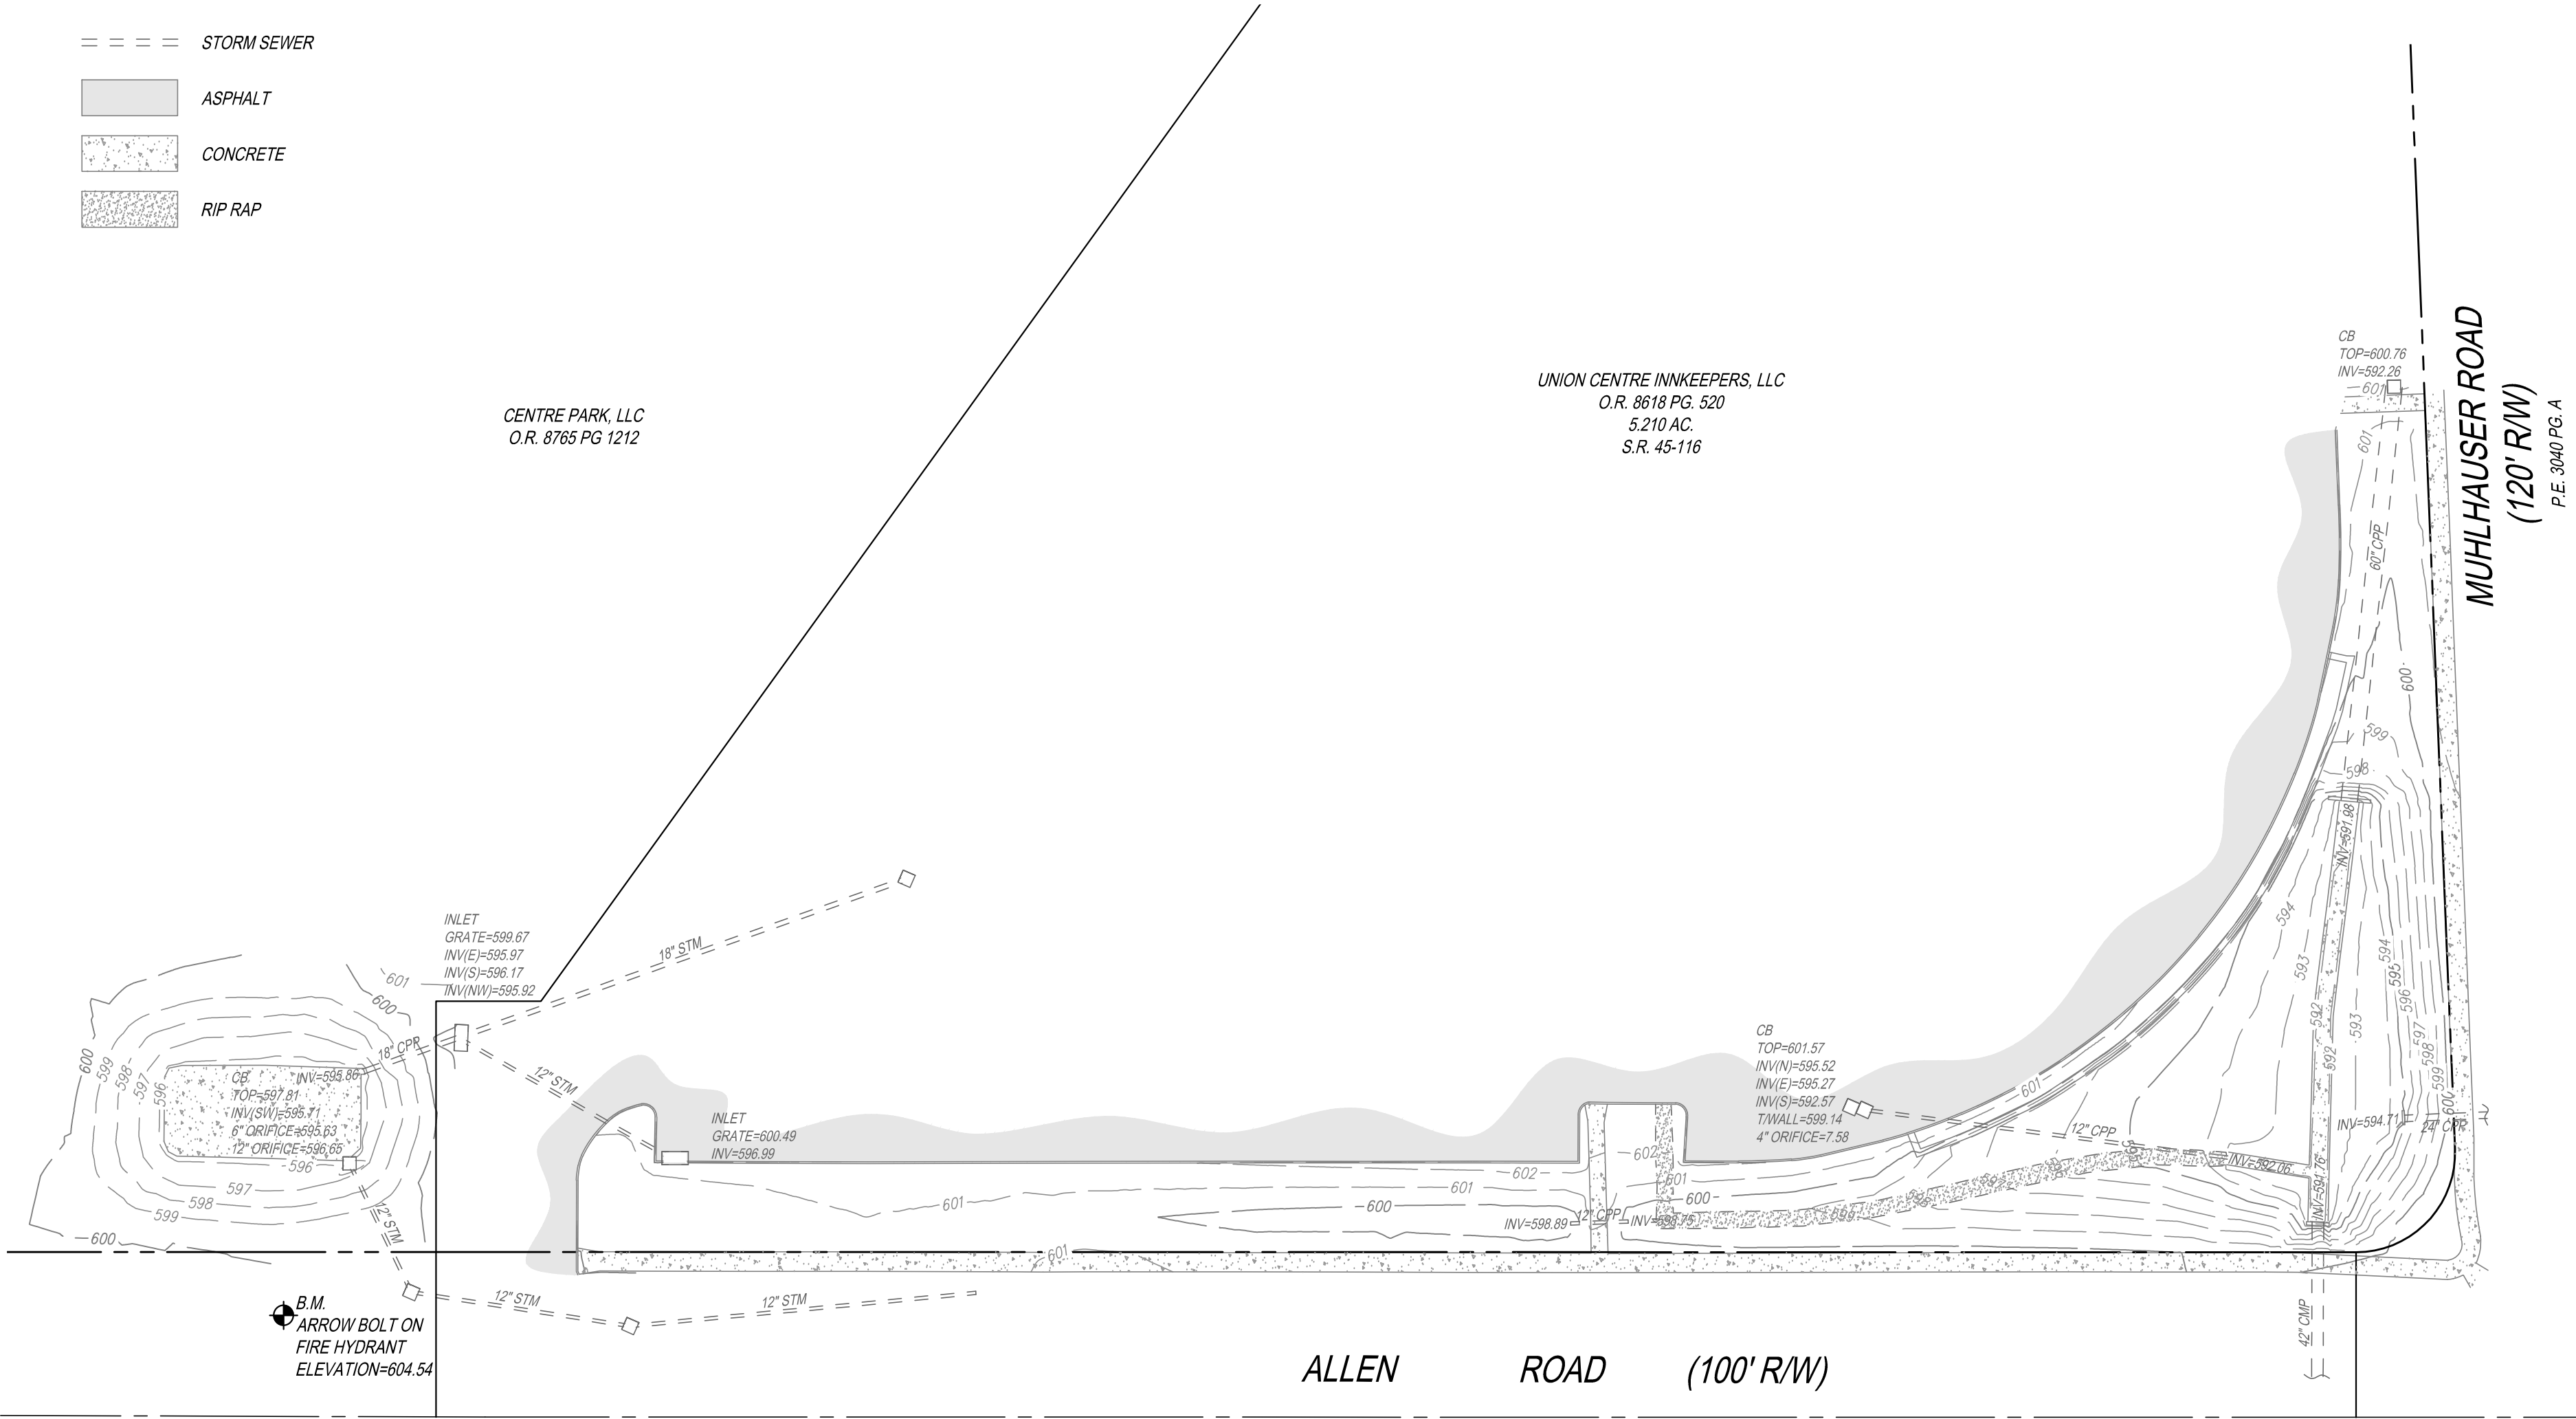

NOTE:
UNDERGROUND UTILITIES ARE PLOTTED FROM A COMPILATION OF AVAILABLE RECORD INFORMATION AND SURFACE INDICATIONS OF UNDERGROUND STRUCTURES AND MAY NOT BE INCLUSIVE. PRECISE LOCATIONS AND THE EXISTENCE OR NON EXISTENCE OF UNDERGROUND UTILITIES CANNOT BE VERIFIED. PLEASE NOTIFY THE OHIO UTILITY PROTECTION SERVICE AT 1-800-362-2764 BEFORE ANY PERIOD OF EXCAVATION OR CONSTRUCTION ACTIVITY.



- NOTES:**
- BEARINGS ARE BASED ON BUTLER COUNTY ENGINEERS RECORD OF LAND SURVEYS VOLUME 44 PAGE 122.
 - VERTICAL DATUM IS BASED ON THE OHIO DEPARTMENT OF TRANSPORTATION'S VIRTUAL REFERENCE STATIONING SYSTEM. (VRS)(NAVD 88)
 - SITE BENCHMARK AS SHOWN HEREON.



CIVIL ENGINEERING | www.kleingers.com
SURVEYING
LANDSCAPE ARCHITECTURE
6305 Centre Park Dr.
West Chester, OH 45069
513.779.7851

SEAL:




NO.	DATE	DESCRIPTION
1	9/22/2015	BASEMAP - MDH

DETENTION AS-BUILT
SECTION 33, TOWN 3, RANGE 2
WEST CHESTER TOWNSHIP
BUTLER COUNTY, OHIO
FOR: HIFIVE DEVELOPMENT SERVICES

PROJECT NO: 110590VAB006

DATE: 9/22/2015

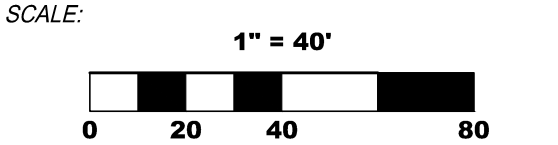

SHEET NAME:

CENTRE PARK HOTEL

SHEET NO.