


Layout Tab Name: Layout1; Images: ; Xrefs: ;
Last Saved By: schneiderc, 7/7/2017 1:51:09 PM
C:\Users\lwaniuk\AppData\Local\Microsoft\Windows\Temporary Internet Files\Content.Outlook\UJBCJZQ\75566_asbuilt_20170707.dwg Plotted By: lwaniuk, Brian Plotted July 7, 2017, 2:07:34 PM

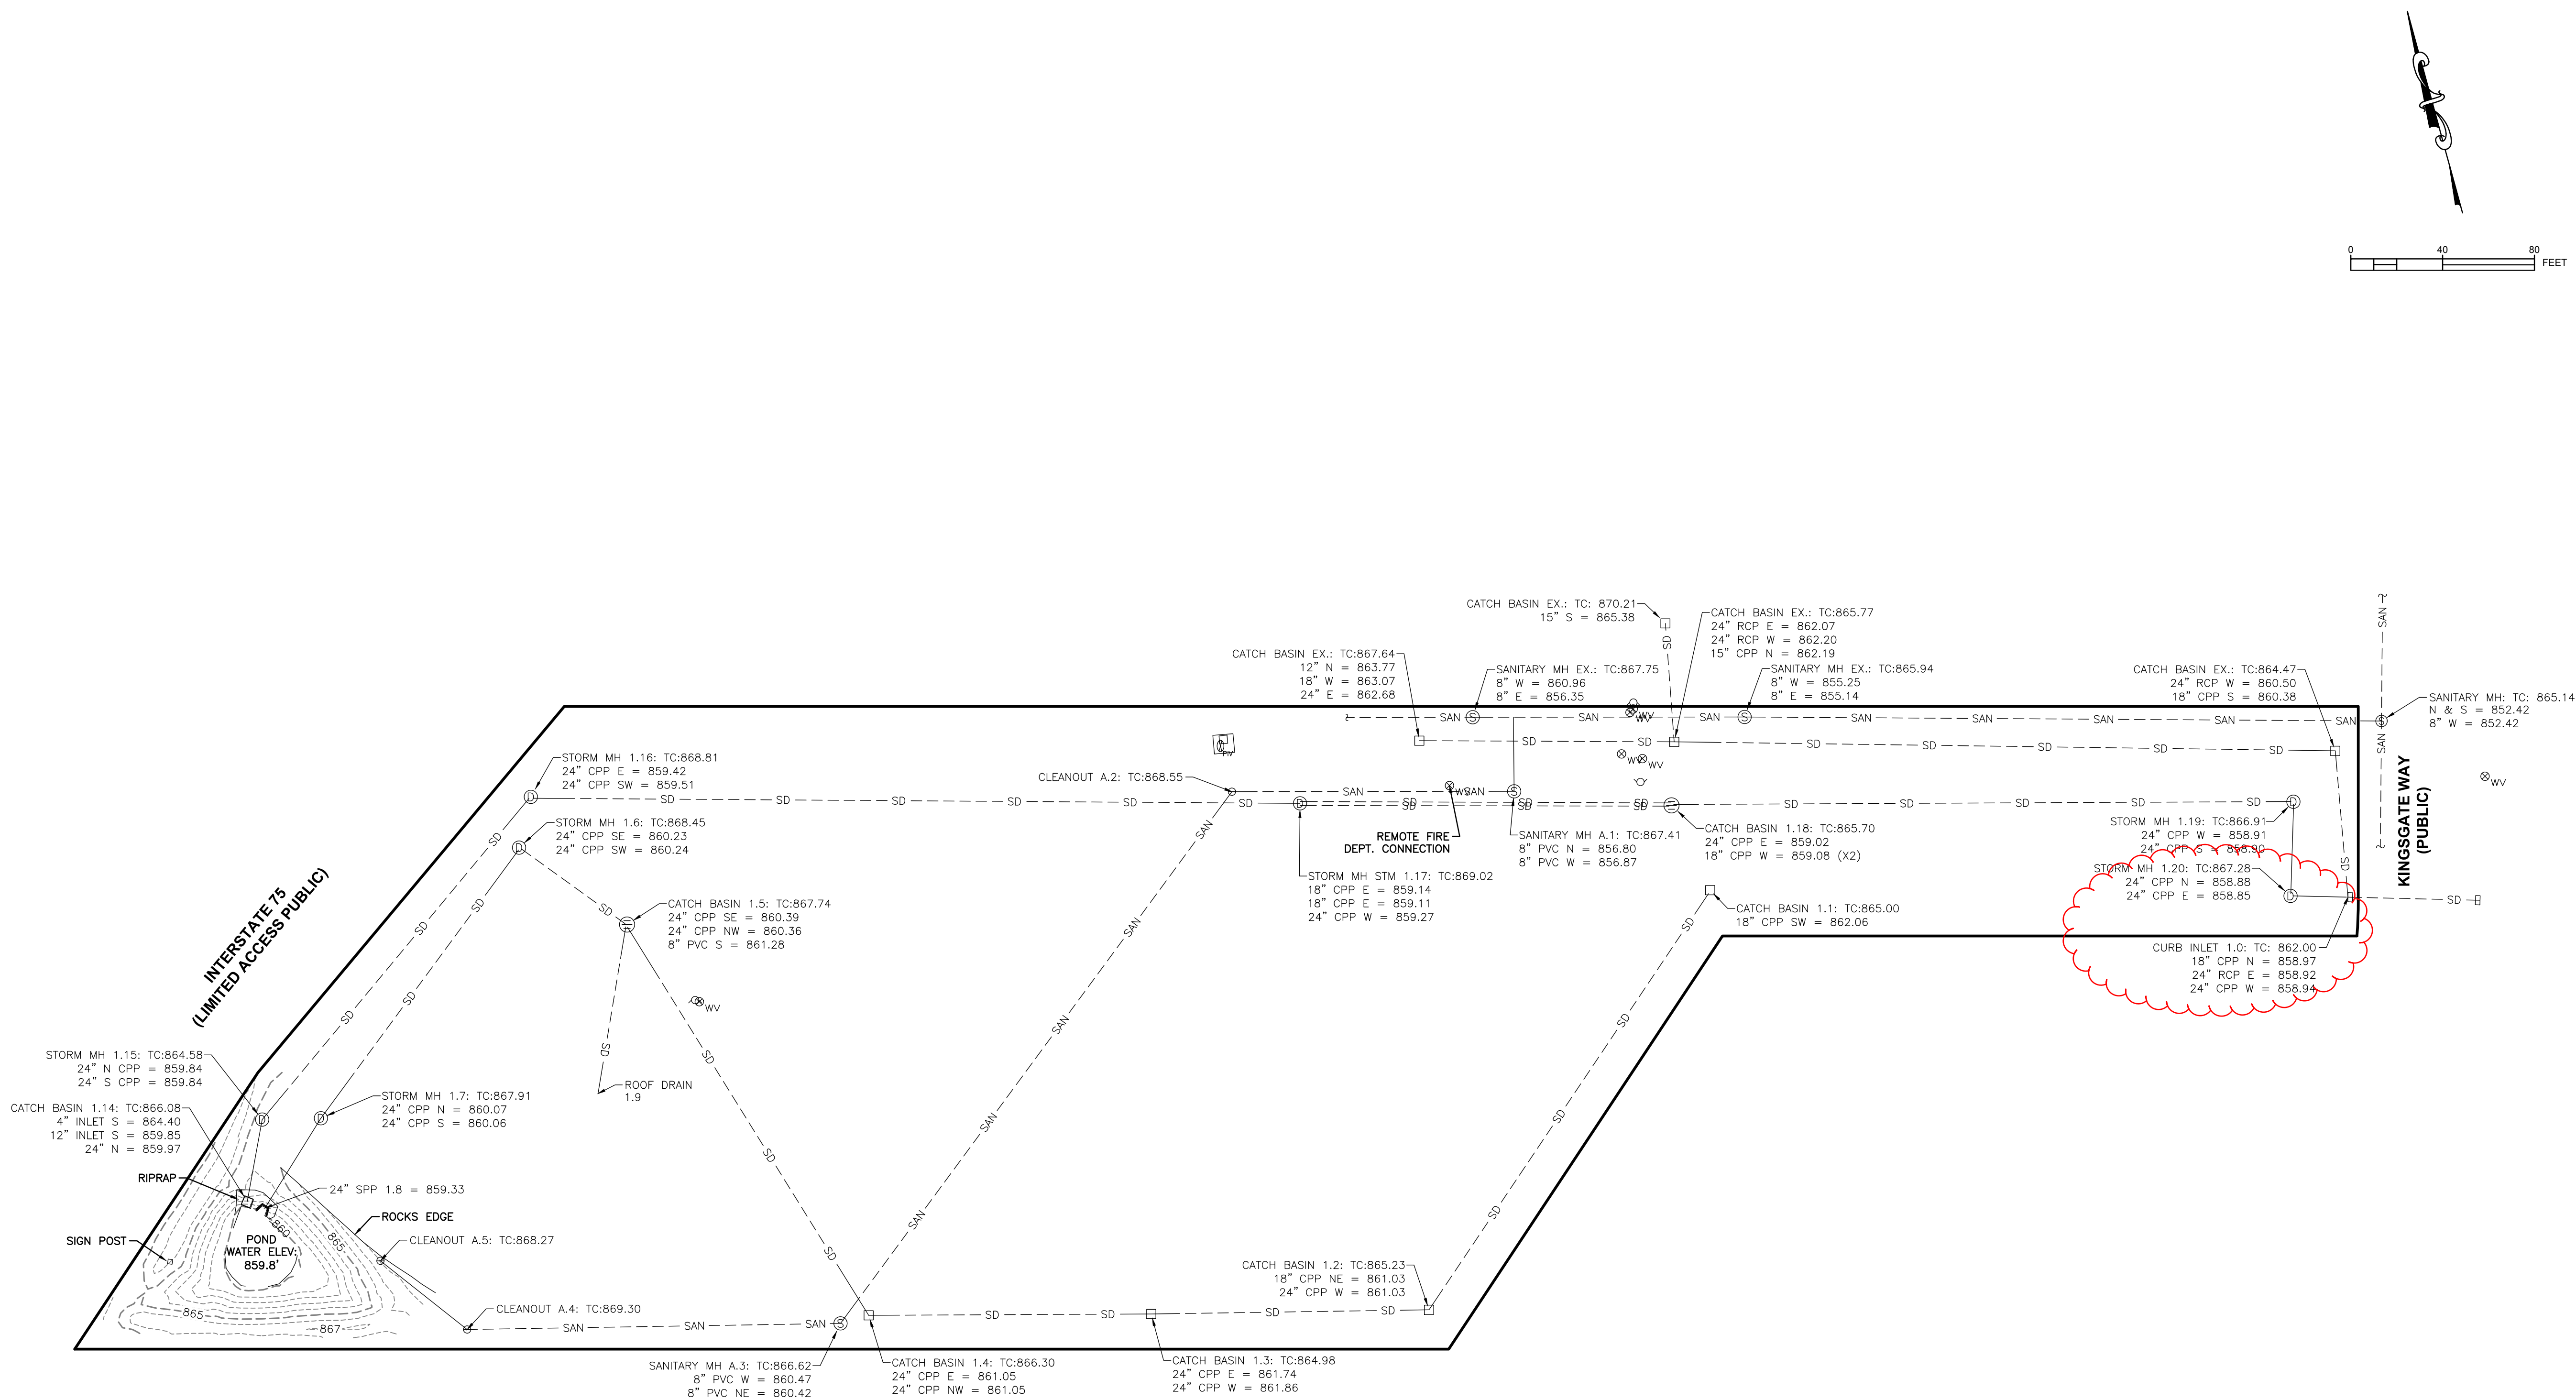

TEXAS ROADHOUSE

7309 KINGSGATE WAY
TOWNSHIP OF WEST CHESTER, BUTLER COUNTY, OHIO

AS-BUILT SURVEY

4454 Idea Center Blvd
Dayton, OH

45430-1500
937.461.5660
FAX: 937.461.0743



PROJECT No: 75566

DATE 07/07/2017

DES. TC

DR. CS

CKD. CS

REVISION

No. DATE

SHEET NO.

1 OF 1