


Layout Tab Name: Layout1; Images: ; Xref's:  
Last Saved By: kczmarzyk, 7/14/2017 4:38:26 PM  
G:\OS\Projects\Various\75566 - Texas Roadhouse West Chester OH\Drawings\75566 - AsBuilt Survey 20170714.dwg Plotted By: kczmarzyk, Pavel Plotted: July 14, 2017, 4:39:05 PM

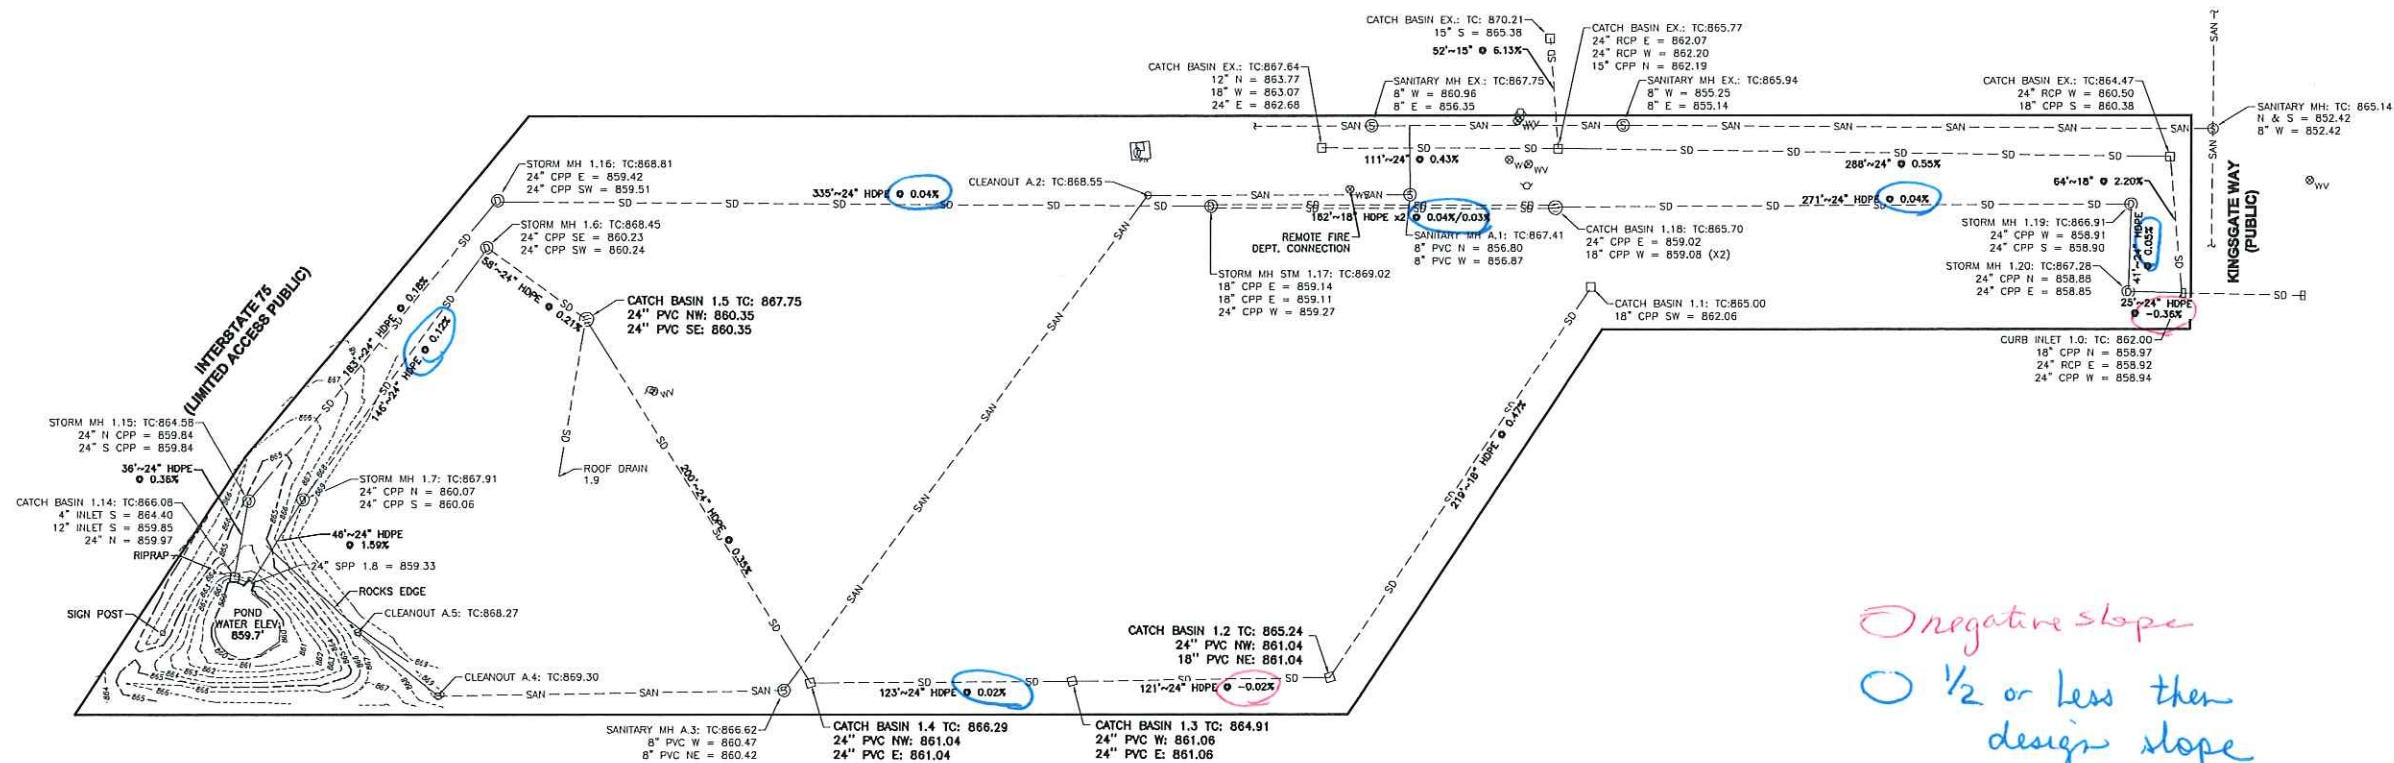

#### SURVEYOR'S CERTIFICATE

I HEREBY CERTIFY THAT THIS ASBUILT SURVEY IS A CORRECT REPRESENTATION OF A FIELD SURVEY PERFORMED BY WOOLPERT INC. ON JULY 14, 2017.  
SITE CONDITIONS MAY VARY BEYOND THIS DATE.



CODY J. SCHNEIDER  
OHIO REGISTERED SURVEYOR NO. 8670  
LICENSE EXPIRES 12/31/17  
DATE: 07/14/2017  
WOOLPERT, INC.

TEXAS ROADHOUSE

7309 KINGSGATE WAY  
TOWNSHIP OF WEST CHESTER, BUTLER COUNTY, OHIO

STORM AND SANITARY AS-BUILT SURVEY

SHEET NO.

1 OF 1

4454 Idea Center Blvd  
Dayton, OH  
45430-1500  
937.461.5660  
FAX: 937.461.0743



PROJECT No:  
75566

DATE  
07/07/2017

DES.  
TC

CKD.  
CS

No. DATE

REVISION

1. 07/14/17 UPDATED PER FIELDWORK

5/4