

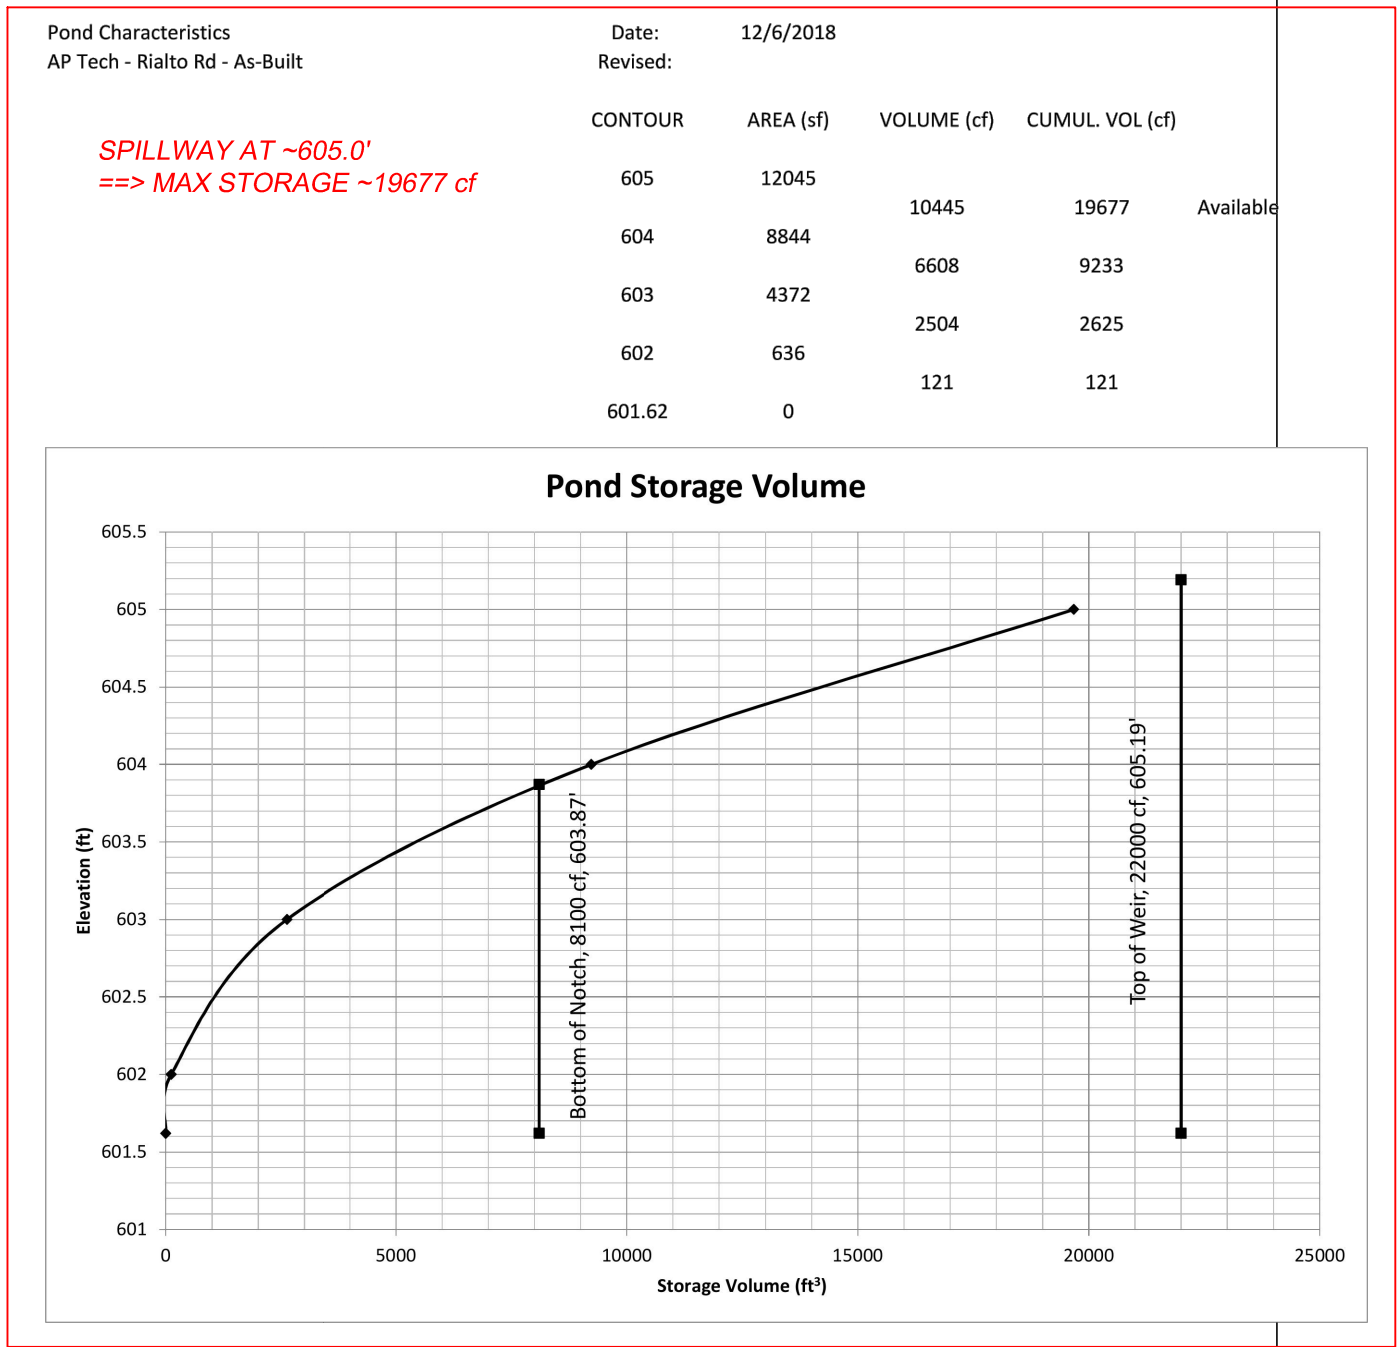
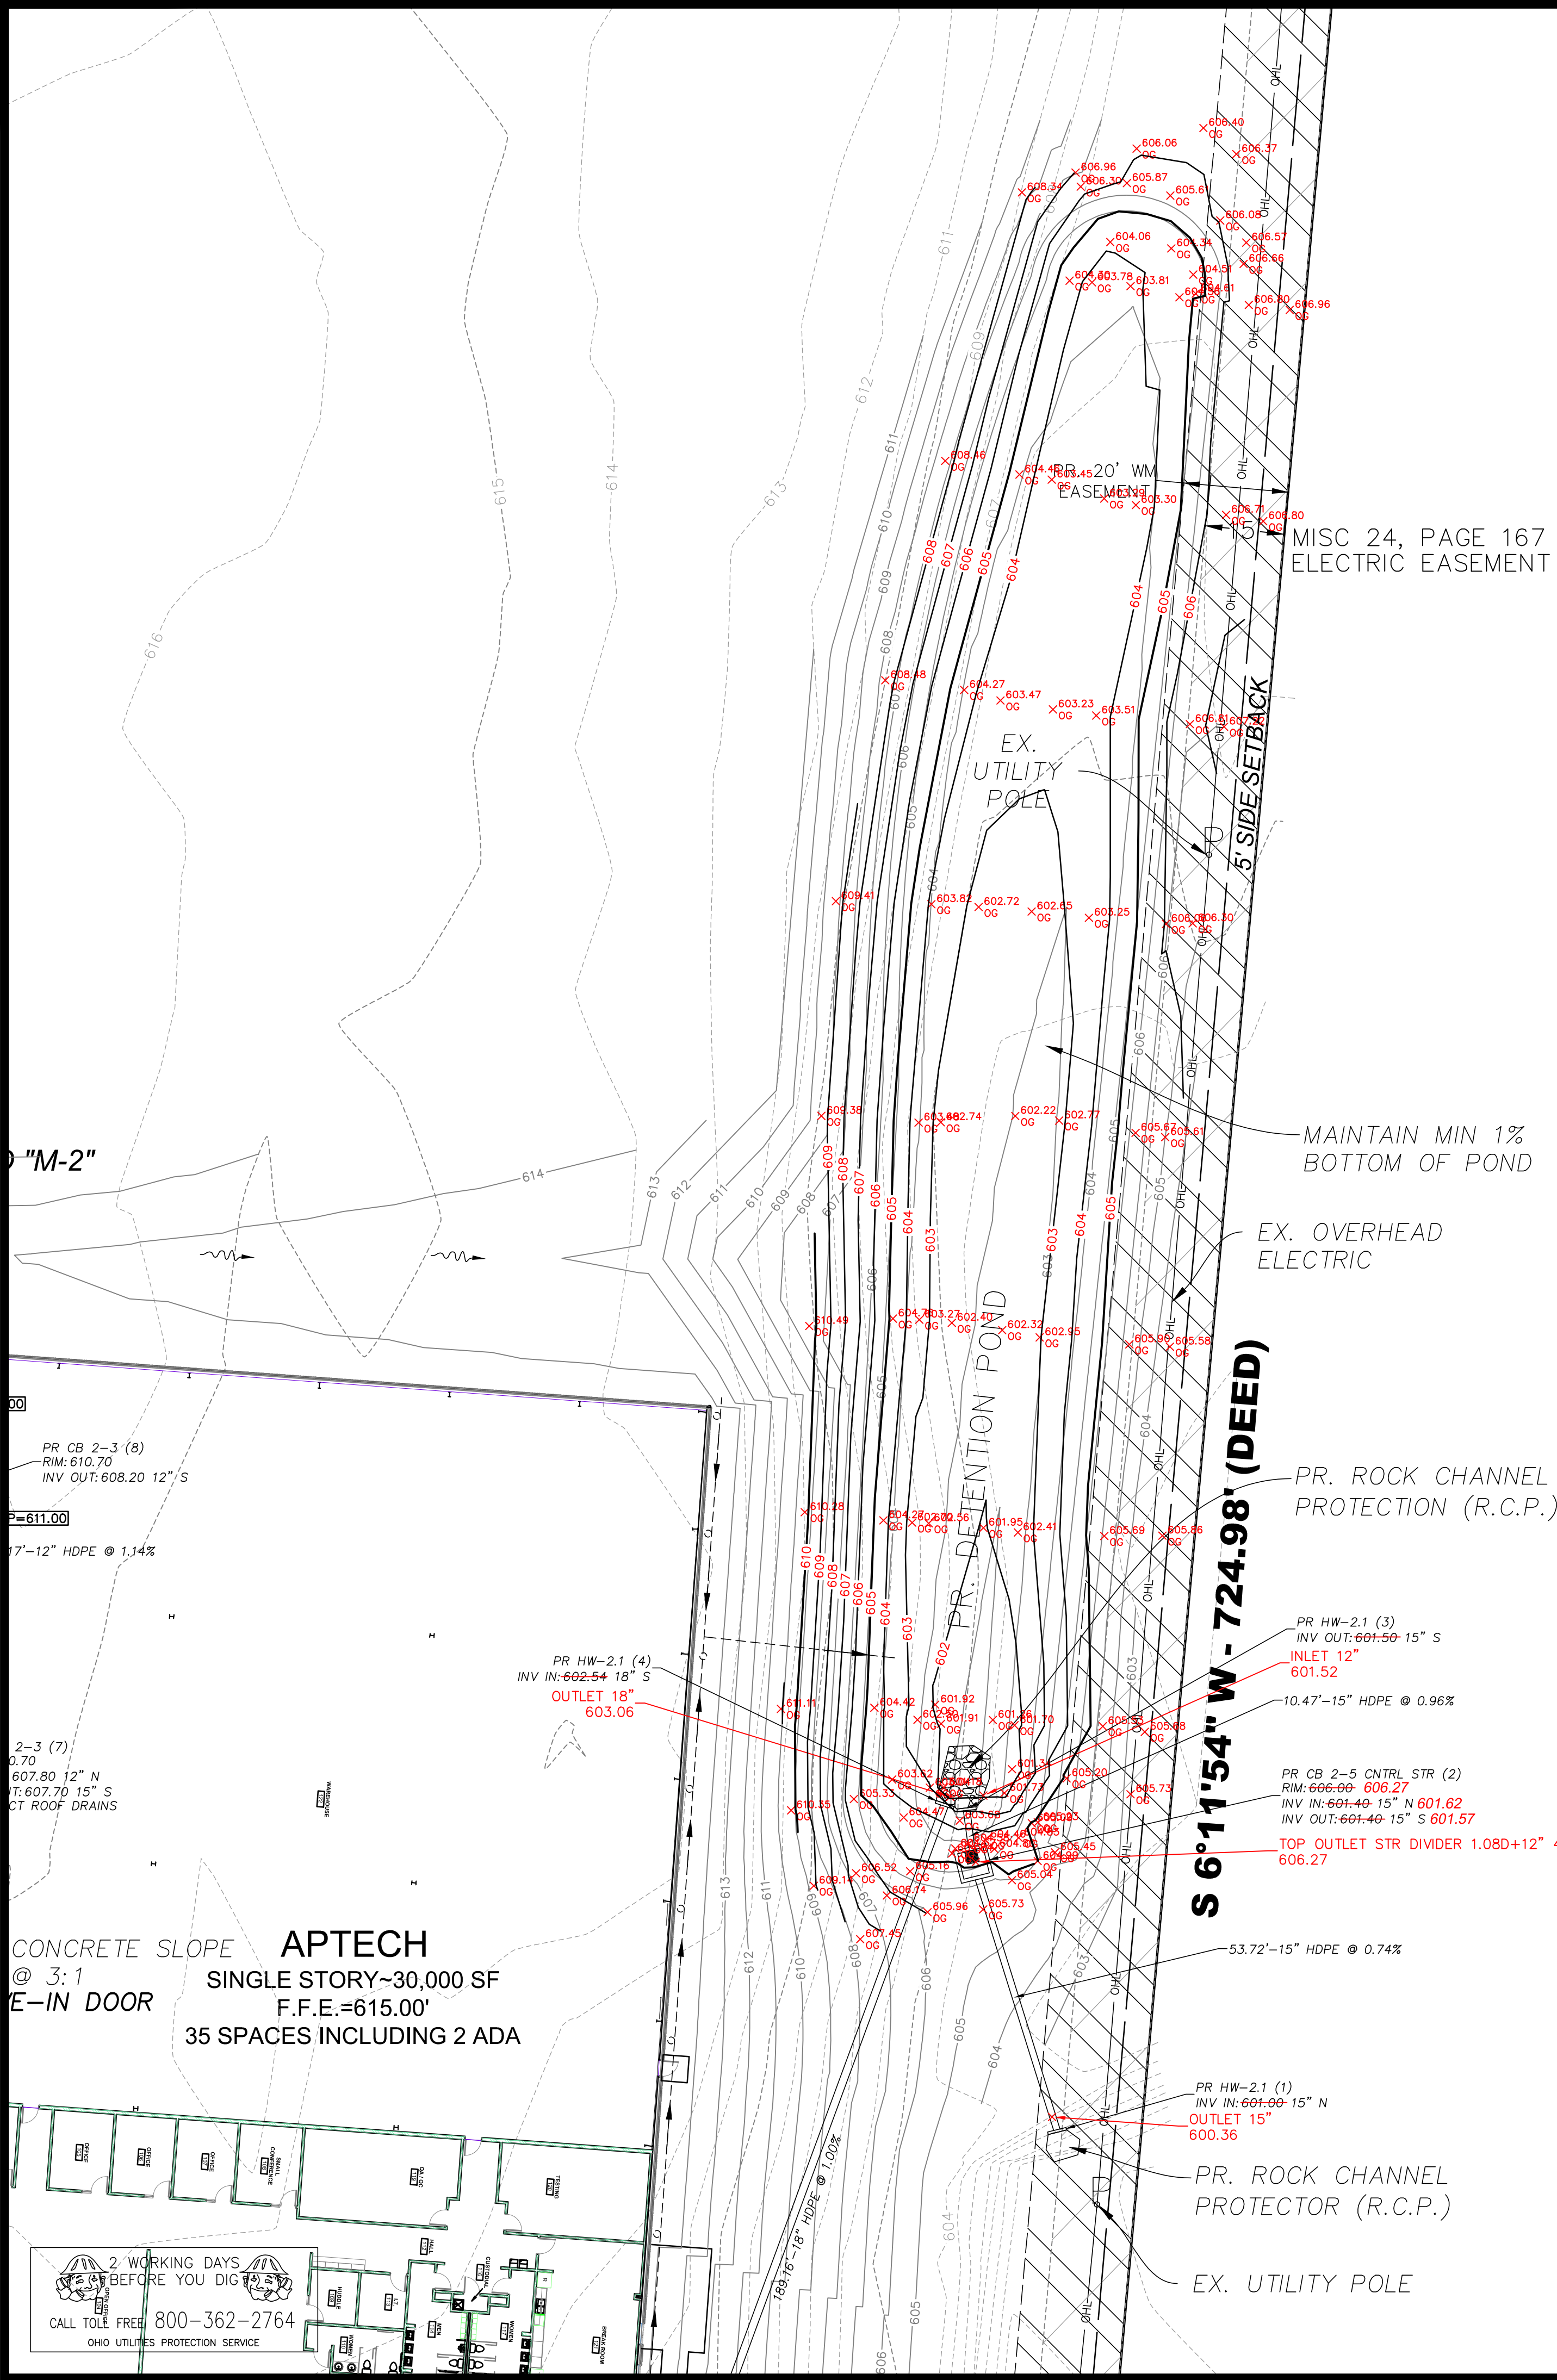
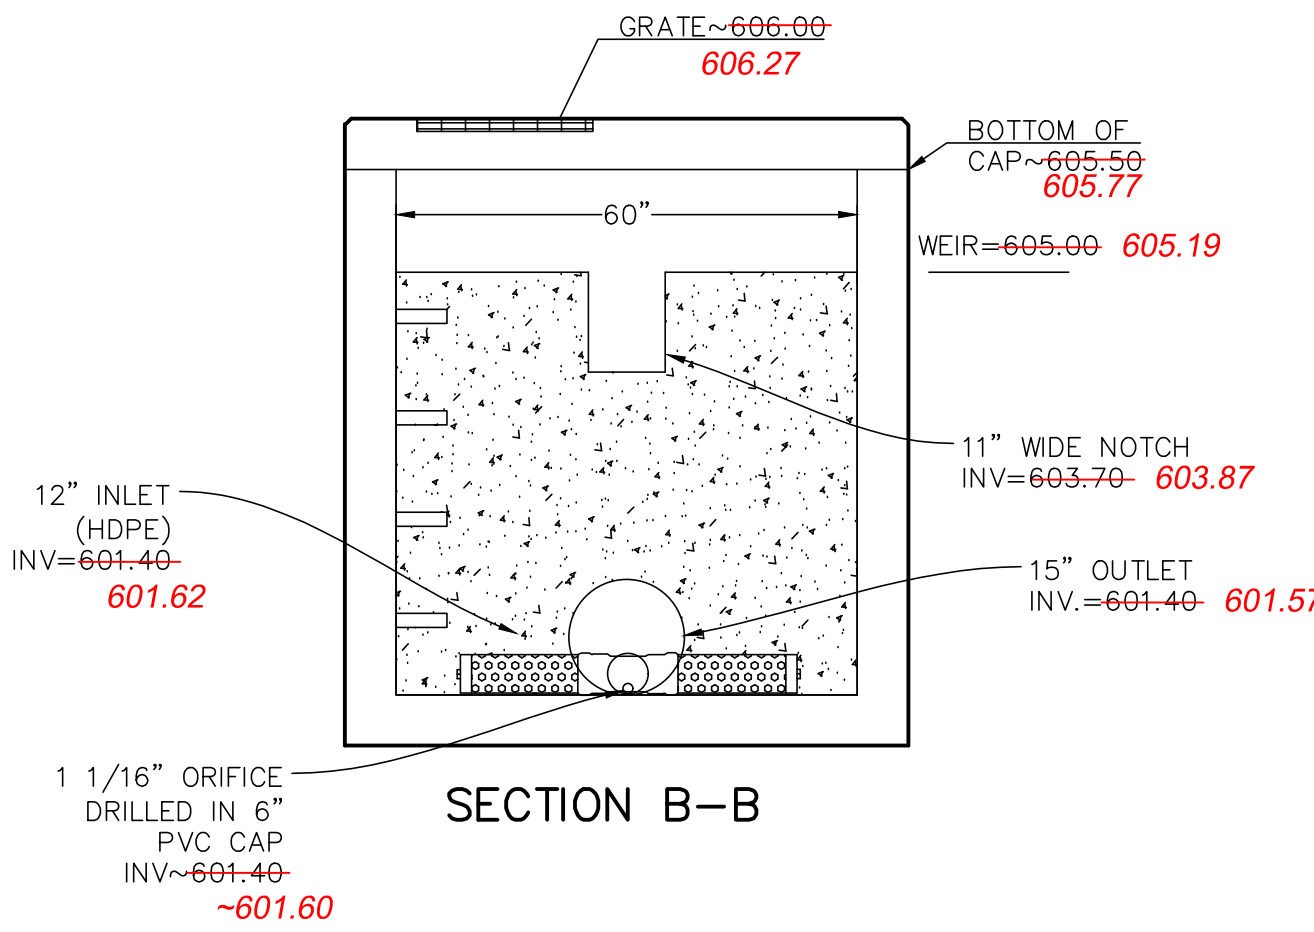


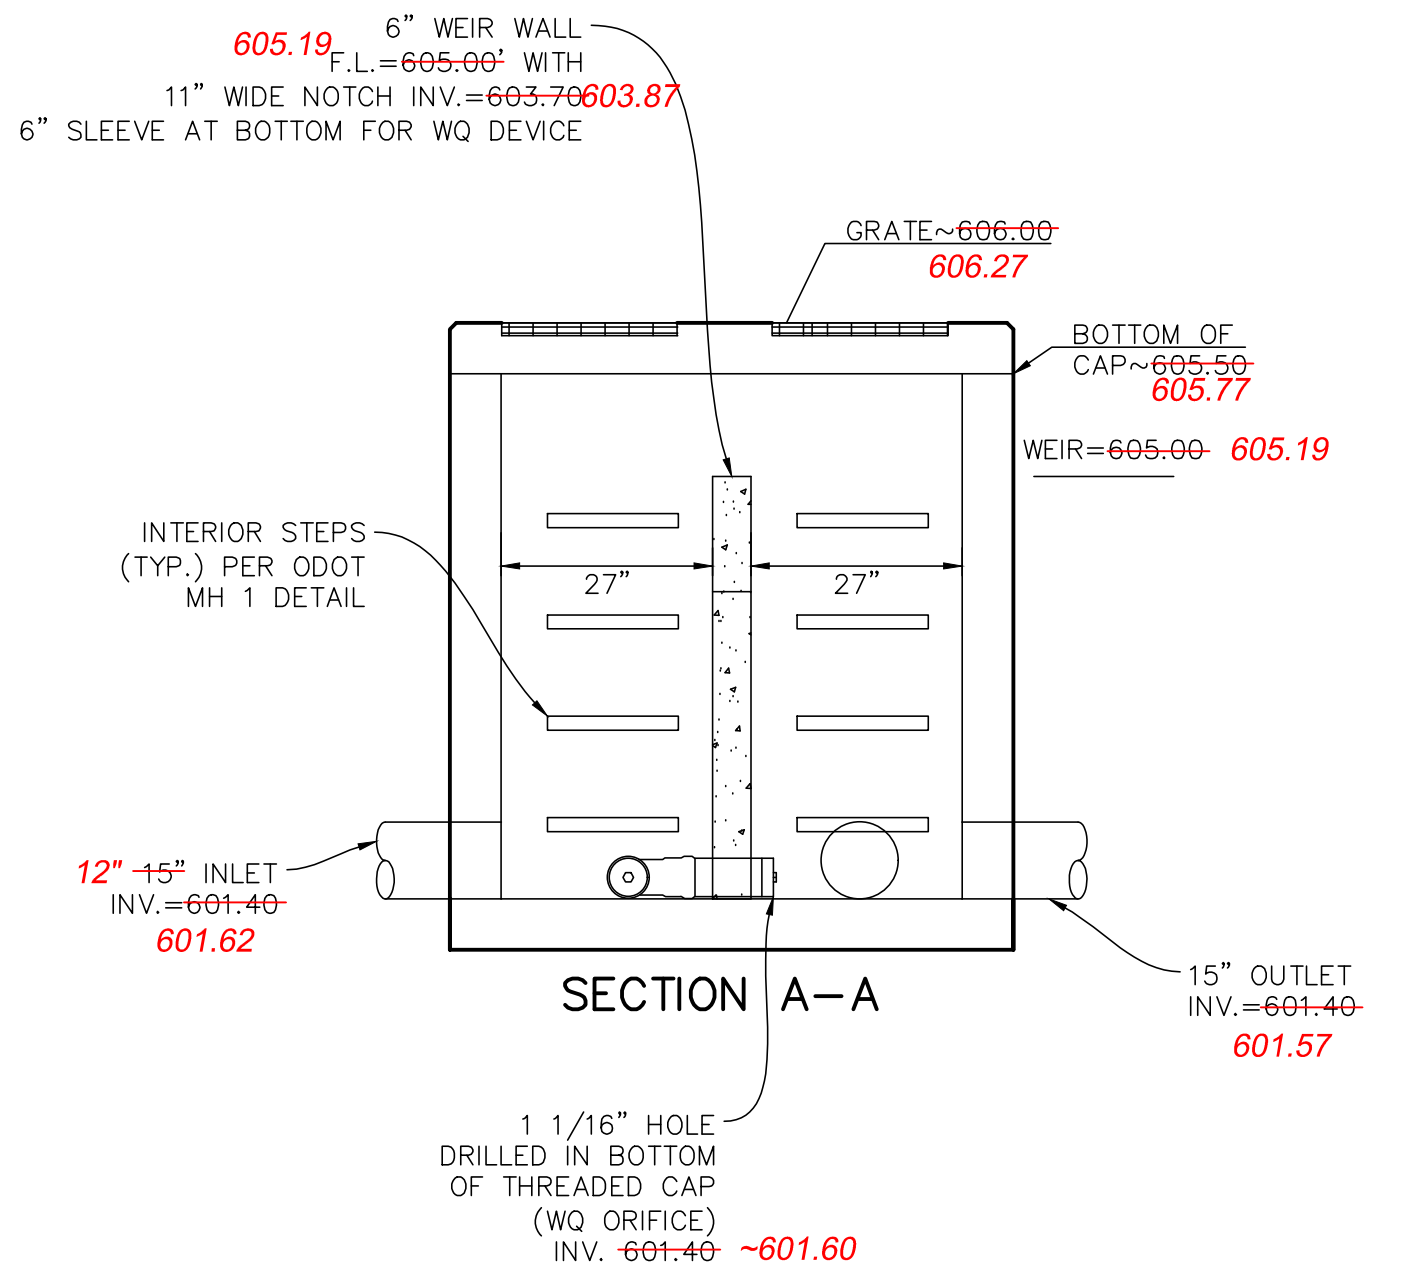


EX. CONC.
DRIVEWAY

EX. BLDG.
(RESIDENTIAL)

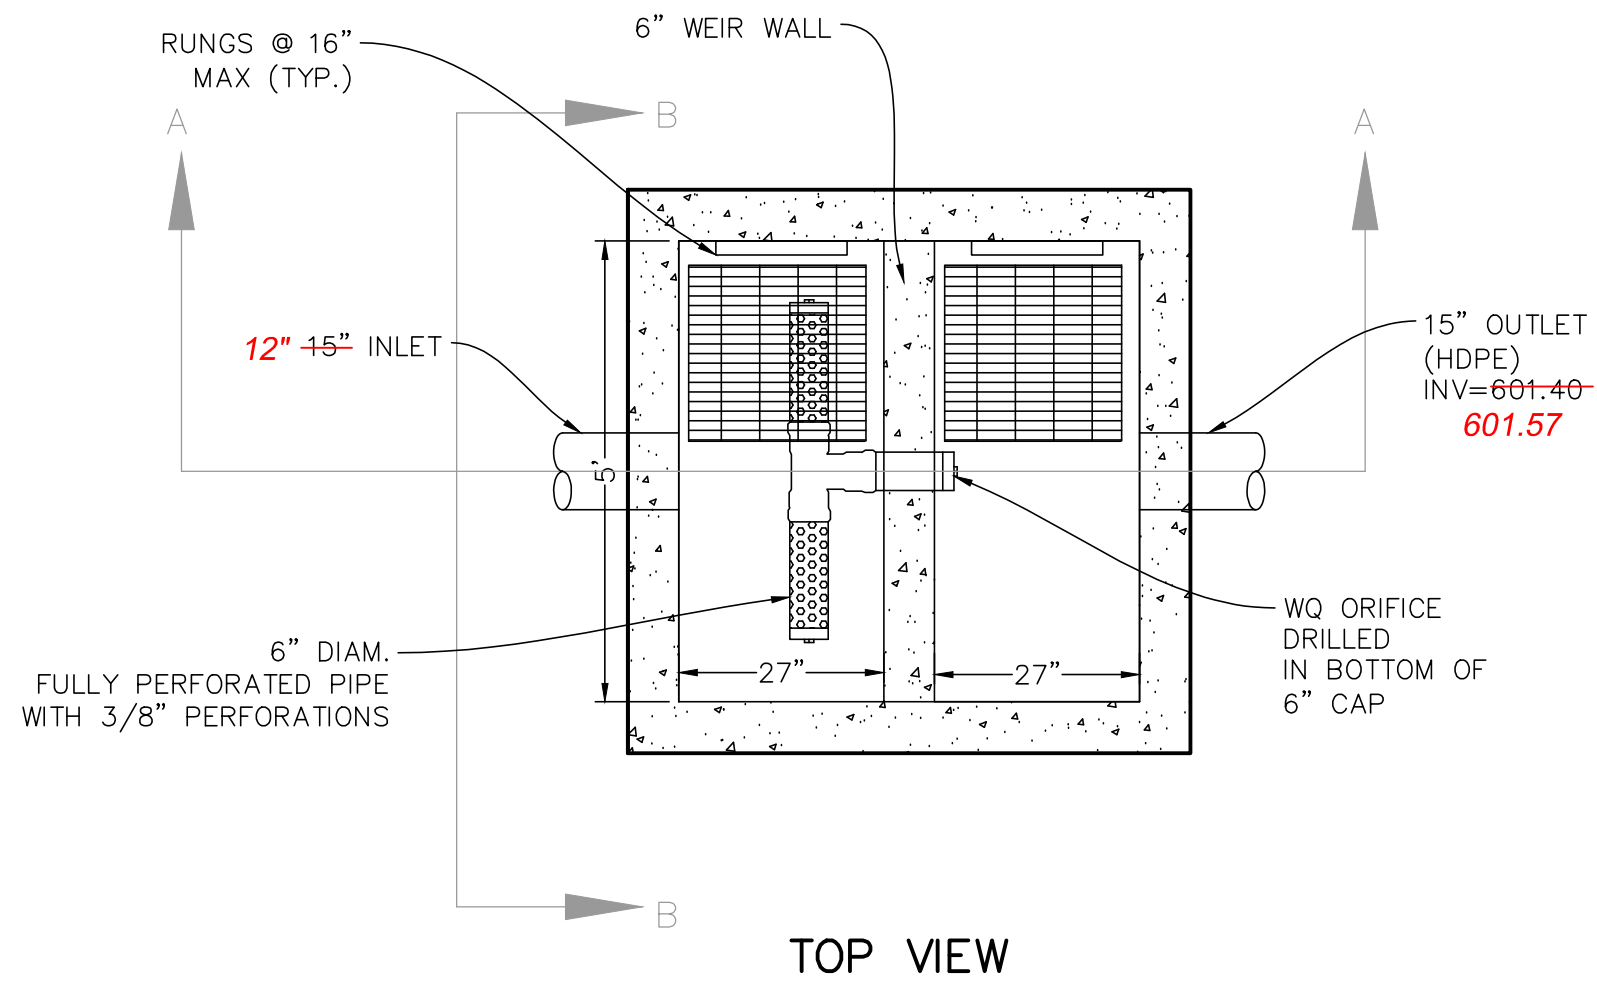

DETENTION CONTROL STRUCTURE
MODIFIED ODOT CB 2-5

SCALE: 1" = 3'

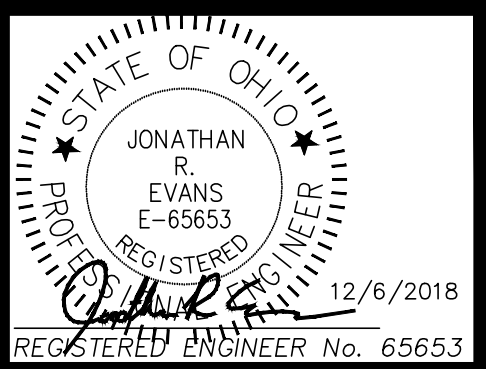

REVISIONS
NO. & DESCRIPTION

BY

DATE

EVANS ENGINEERING
4240 AIRPORT ROAD, SUITE 211
CINCINNATI, OHIO 45226
(513) 321-2168



DETENTION PLAN - AS-BUILT
AP TECH - RIALTO RD.
5090 RIALTO RD.,
WEST CHESTER TOWNSHIP, BUTLER COUNTY, OHIO

SCALE: HORIZ. VERT.
1"=10' N/A

JOB NO. 18-127
DATE Dec. 6, 2018

SHEET NO.

C-4.1-AB