

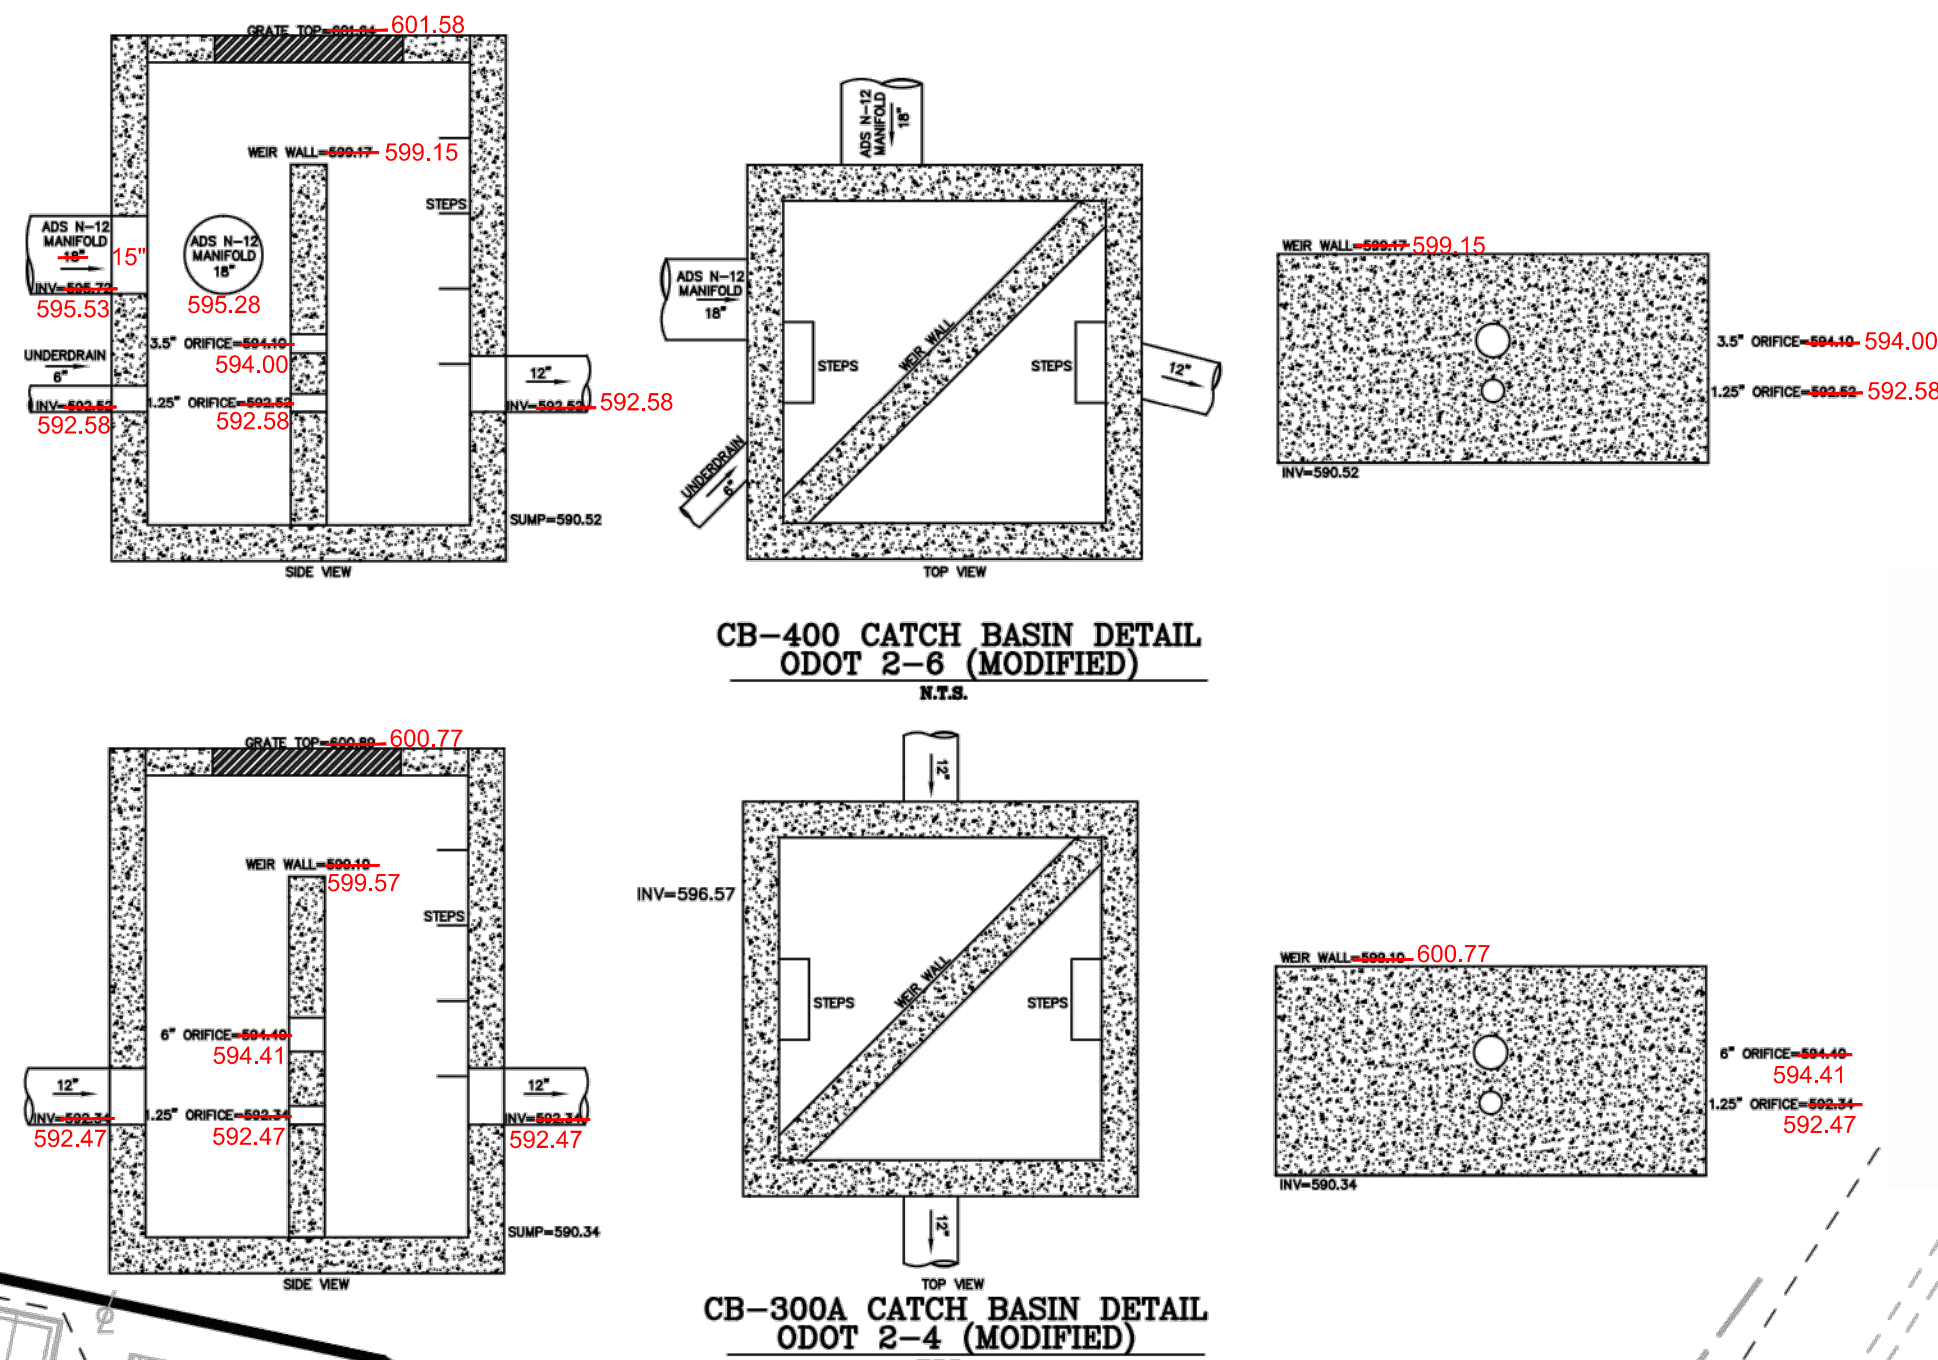


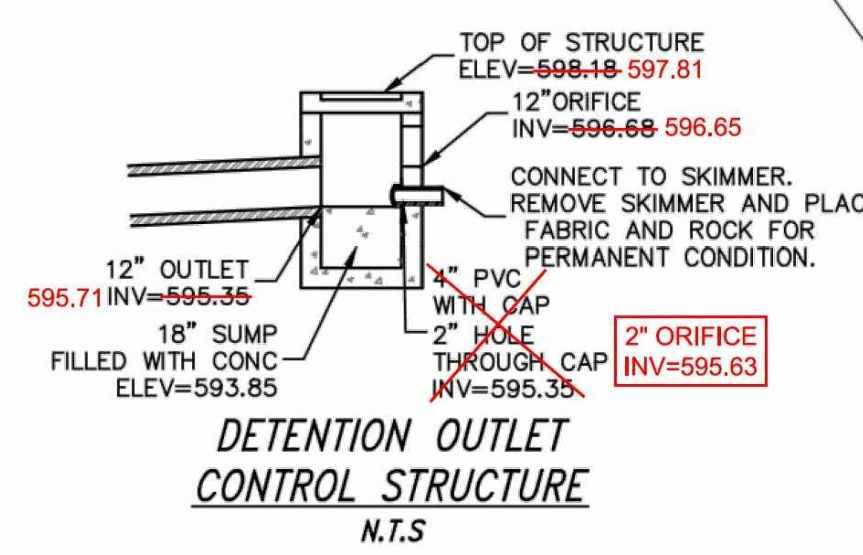

SEAL:

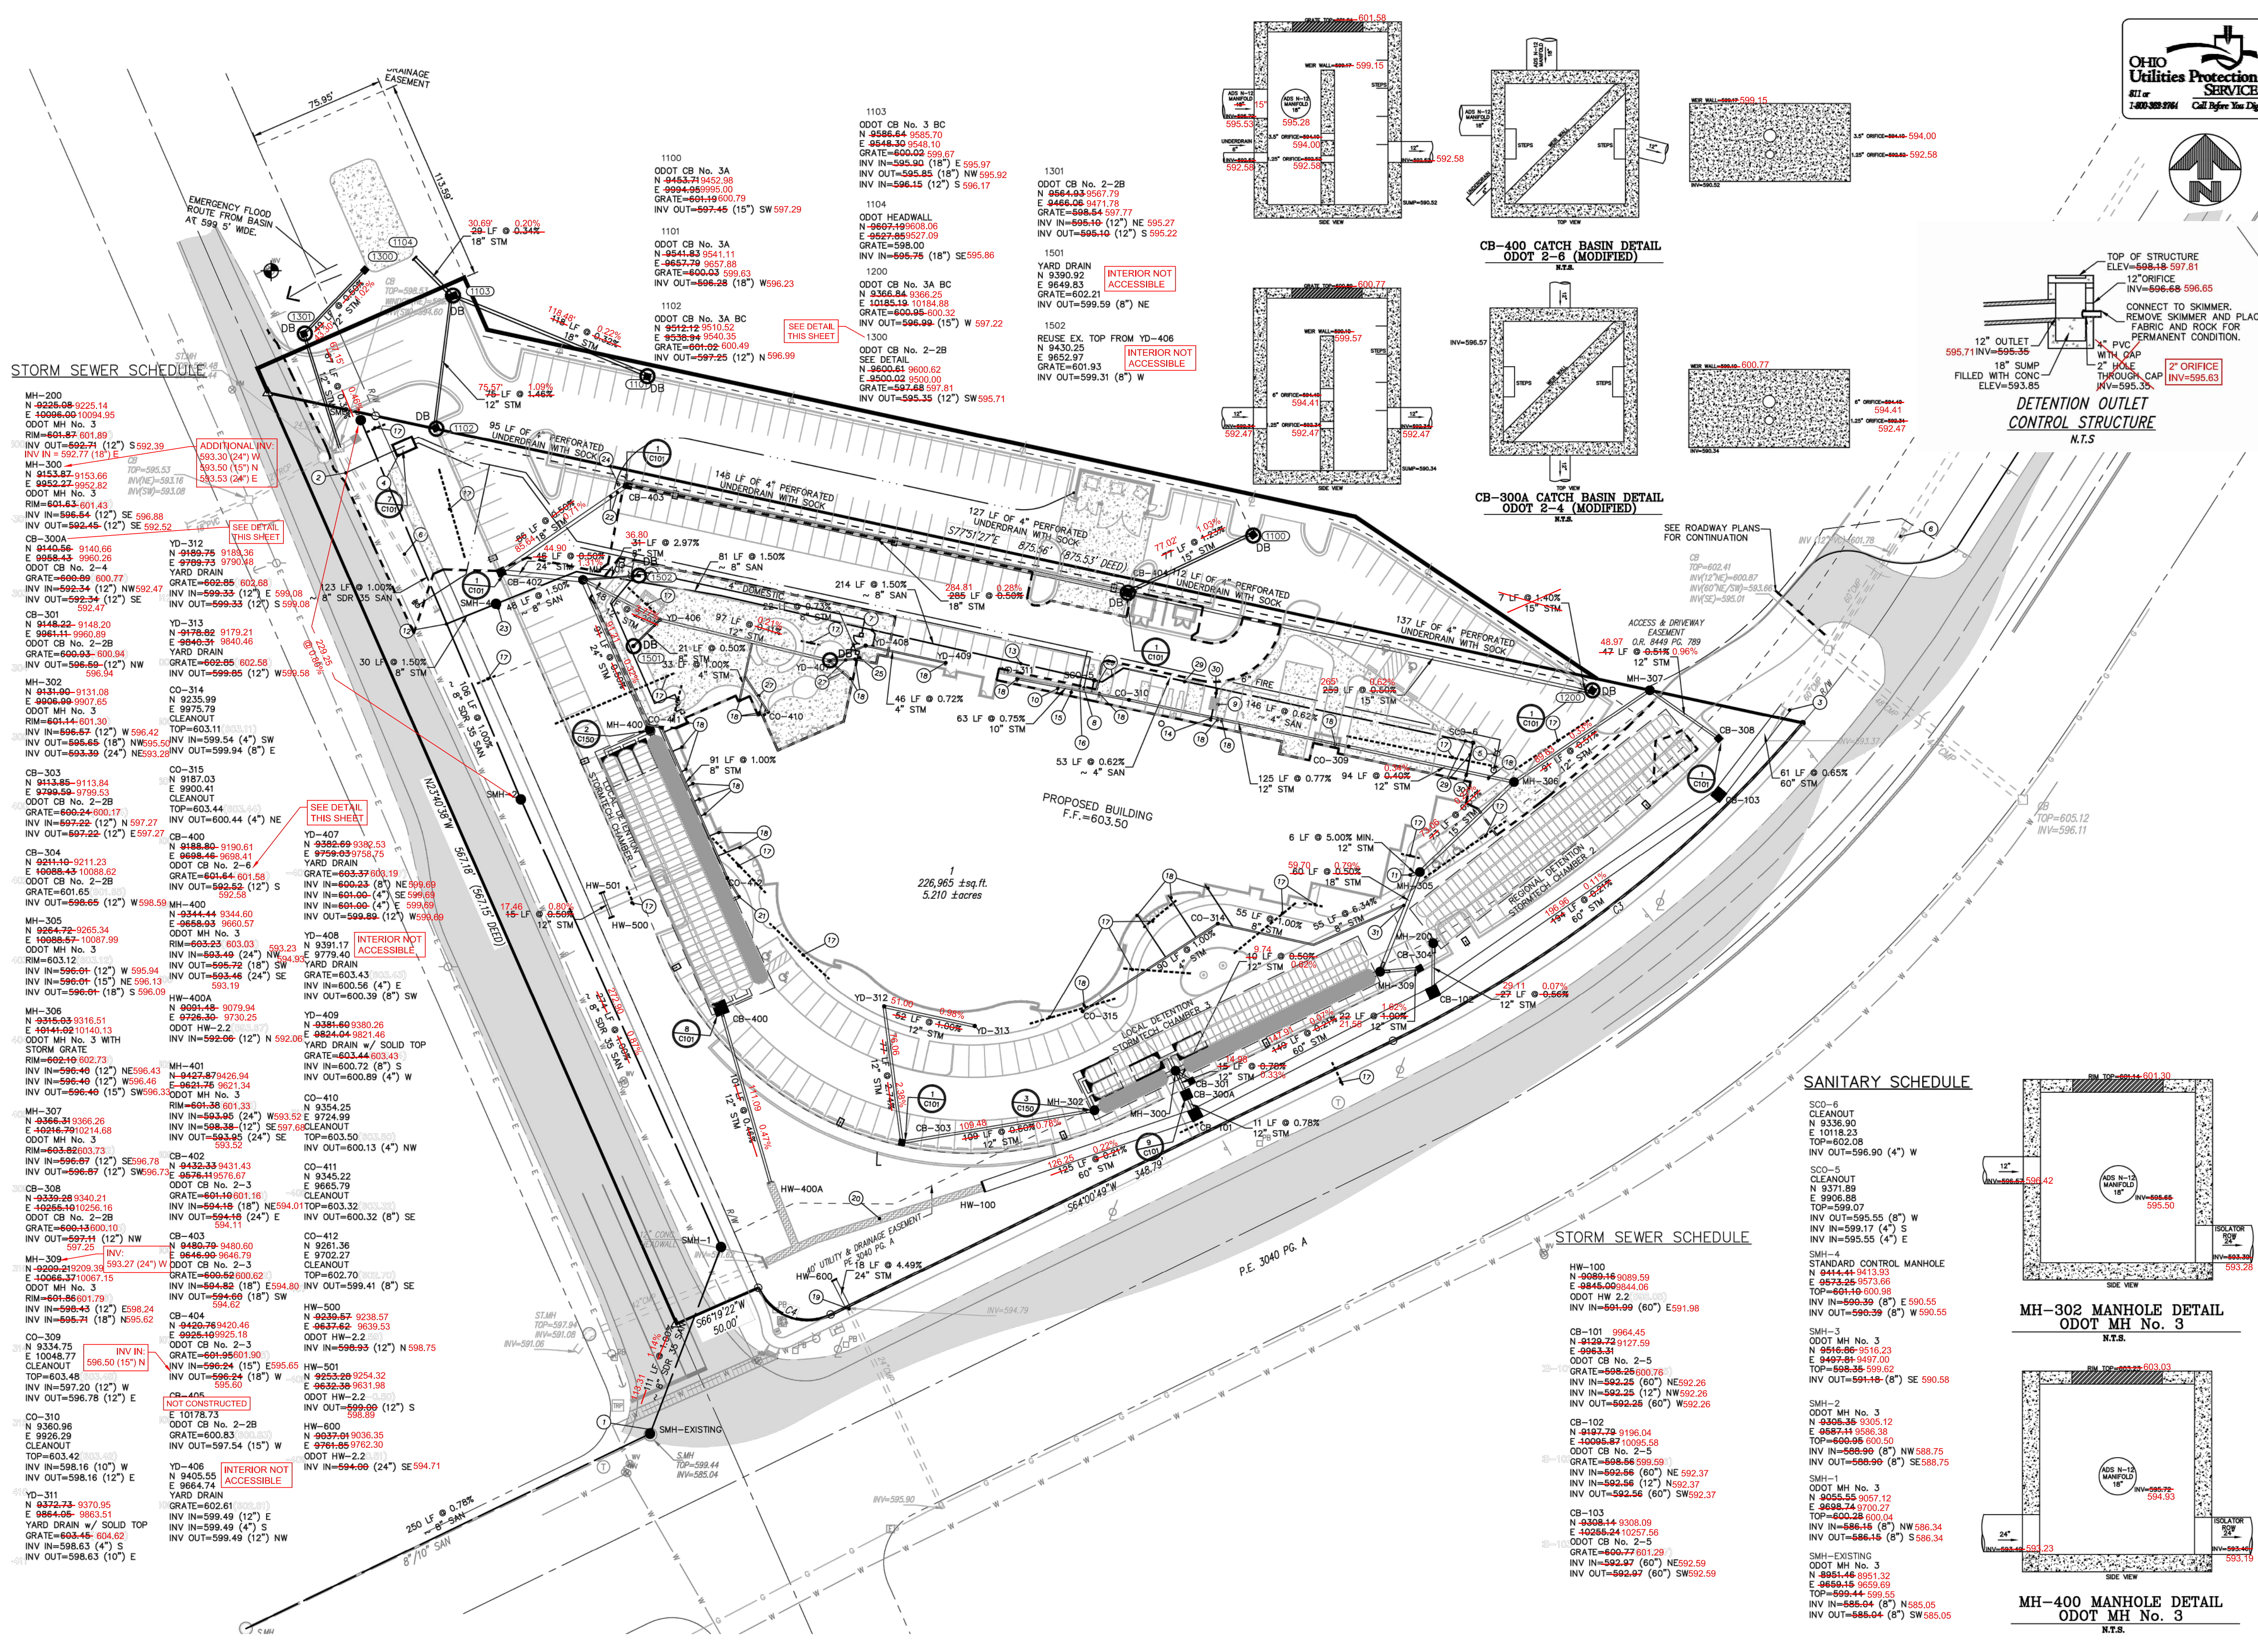

NO. DATE DESCRIPTION

1	08-28-2013	ZONING APPROVAL
2	08-18-2013	FOUNDATION/SHELL PERMIT SUBMITT
3	04-16-2014	REVISED SHELL

AS-BUILT - TKG 11/09/2015

SANITARY SCHEDULE

SC0-6
CLEANOUT
N 9336.90
E 10118.23
TOP=602.08
INV OUT=596.90 (4") W

SC0-5
CLEANOUT
N 9371.89
E 9906.88
TOP=599.07
INV OUT=595.55 (8") W
INV IN=599.17 (4") S
INV IN=595.64

12" INV=596.42 596.42

ADD N=12 MANFOLD 12" INV=595.50 595.50

ISOLATOR ROW

STANDARD CONTROL MANHOLE
N ~~6414-44~~ 9414.83
E ~~0573-26~~ 9573.66
TOP = ~~601-16~~ 600.98
INV IN = ~~590-39~~ (8") E 590.55
INV OUT = ~~590-39~~ (8") W 590.55

SMH-3
ODOT MH No. 3
N ~~9216-86~~ 9316.23
E ~~9497-81~~ 9497.00
TOP = ~~590-36~~ 599.62
INV OUT = ~~591-18~~ (8") SE 590.58

SMH-2
ODOT MH No. 3
N ~~9305-56~~ 9305.12
E ~~9567-44~~ 9568.39
TOP = ~~600-95~~ 600.50
INV IN = ~~598-90~~ (8") NW 588.75
INV OUT = ~~598-90~~ (8") SE 588.75

SMH-1
ODOT MH No. 3
N ~~9055-55~~ 9057.12
E ~~9698-74~~ 9700.27
TOP = ~~600-28~~ 600.04
INV IN = ~~596-18~~ (8") NW 586.34
INV OUT = ~~586-15~~ (8") S 586.34

SMH-EXISTING
ODOT MH No. 3
N ~~8951-46~~ 8951.32
E ~~9699-45~~ 9699.69
TOP = ~~590-44~~ 599.65
INV IN = ~~585-04~~ (8") N 585.05
INV OUT = ~~585-04~~ (8") SW 585.05

MH-302 MANHOLE DETAIL
ODOT MH No. 3
N.T.S.

MH-400 MANHOLE DETAIL
ODOT MH No. 3
N.T.S.

CENTRE PARK HOTEL AND CONFERENCE CENTER	
SECTION 33, TOWN 3, RANGE 2 WEST CHESTER TOWNSHIP BUTLER COUNTY, OHIO	
PROJECT NO:	110590.001
DATE:	01-27-2014
SCALE:	
 20 0 20 40 60	
SHEET NAME:	
UTILITY PLAN	
SHEET NO.	
C130	