


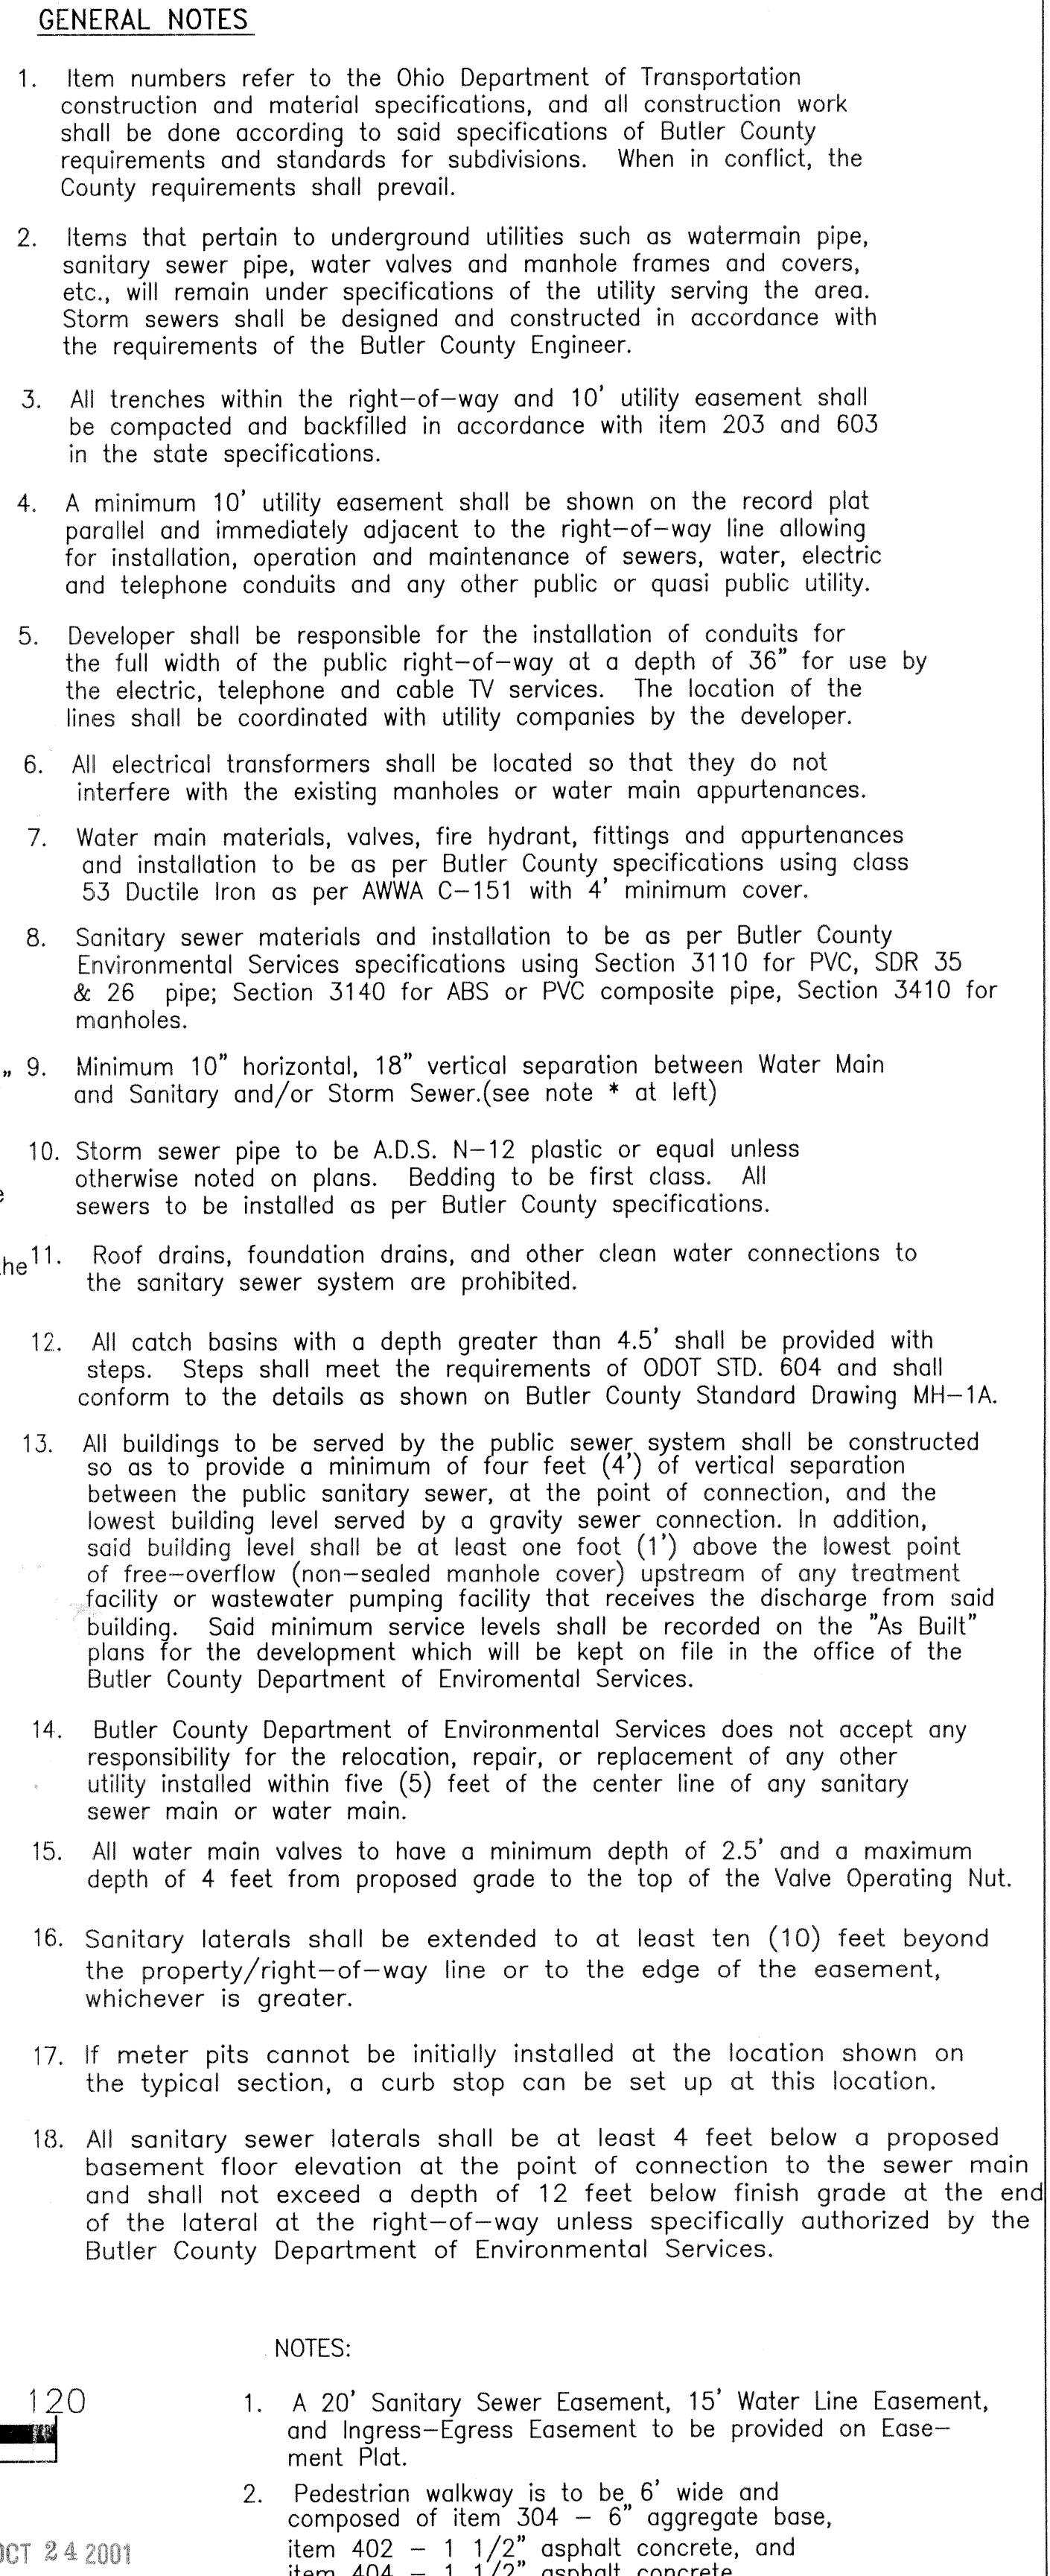


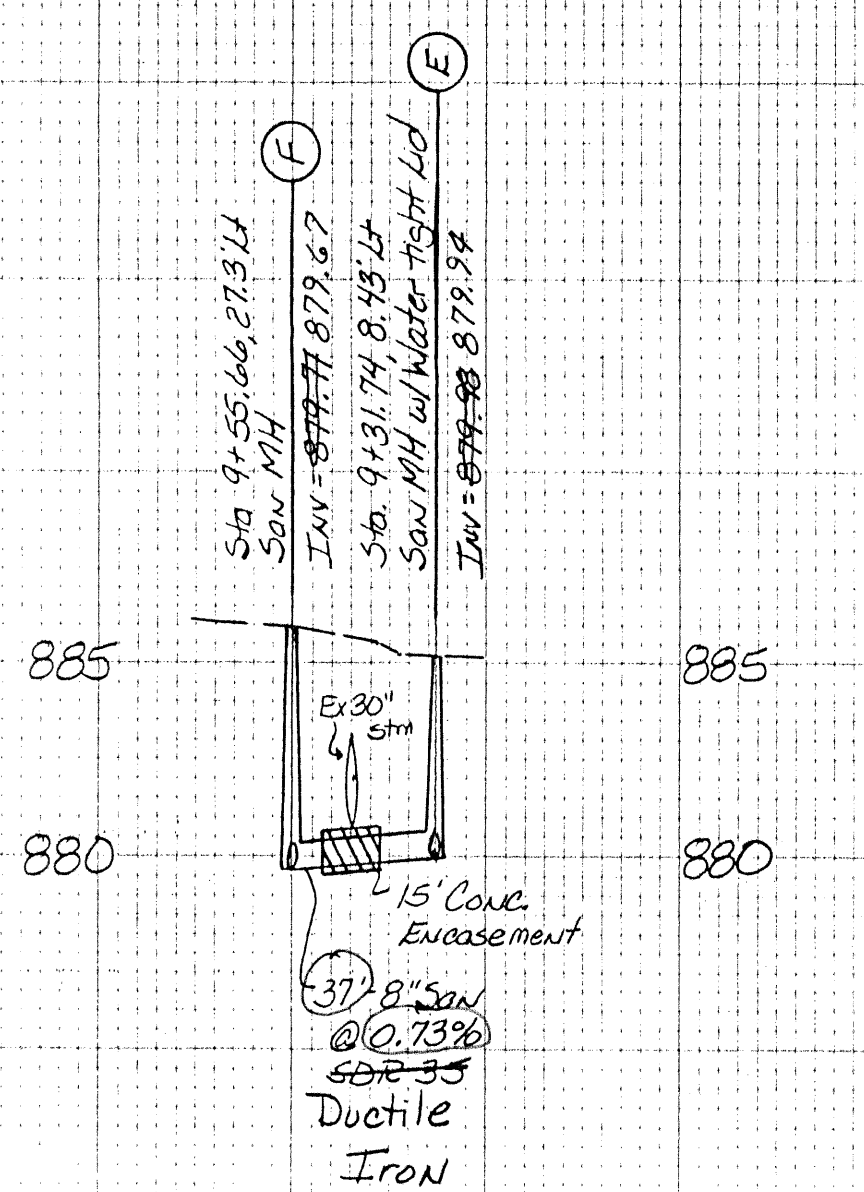

Plans 10-24-01

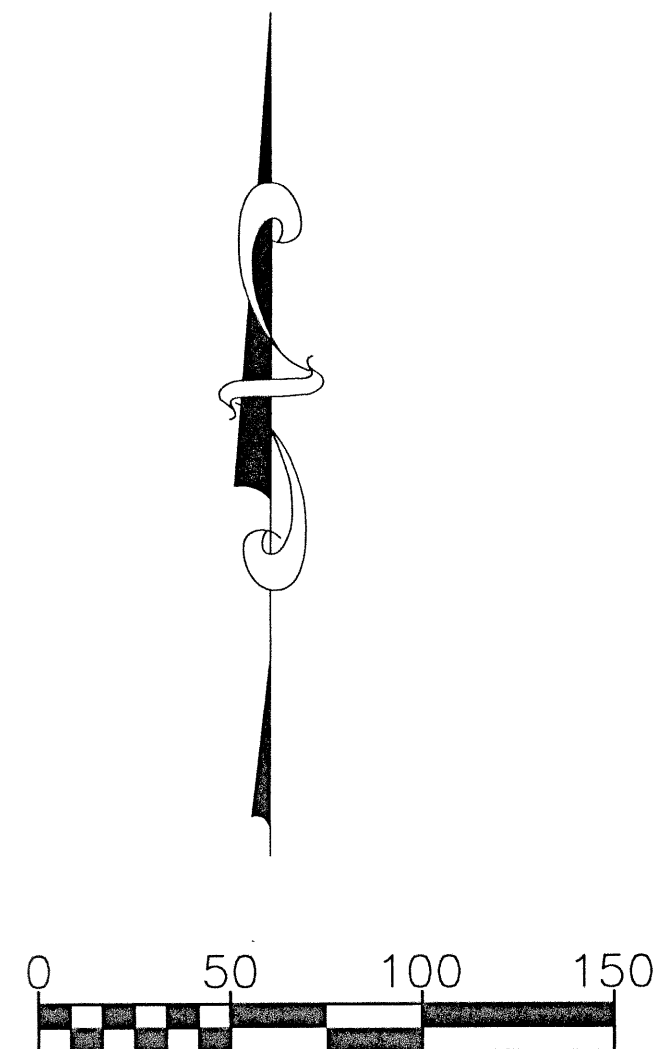

NOTE:
(1) 18" MIN. VERTICAL CLEARANCE OD TO OD TO BE MAINTAINED BETWEEN WATER MAIN AND STORM AND SANITARY SEWERS AT CROSSOVERS.
(2) LOWER WATER SERVICES AS NEEDED TO AVOID CONFLICTS WITH STORM WITH MIN. 4' COVER.
(3) LOCATION OF ALL EXISTING UTILITIES TO BE DETERMINED IN THE FIELD PRIOR TO WORK BEGINNING.
(4) 48 HOUR NOTICE TO BE PROVIDED TO PROPERTY OWNERS AFFECTED BY SHUTDOWN OF WATER MAIN.

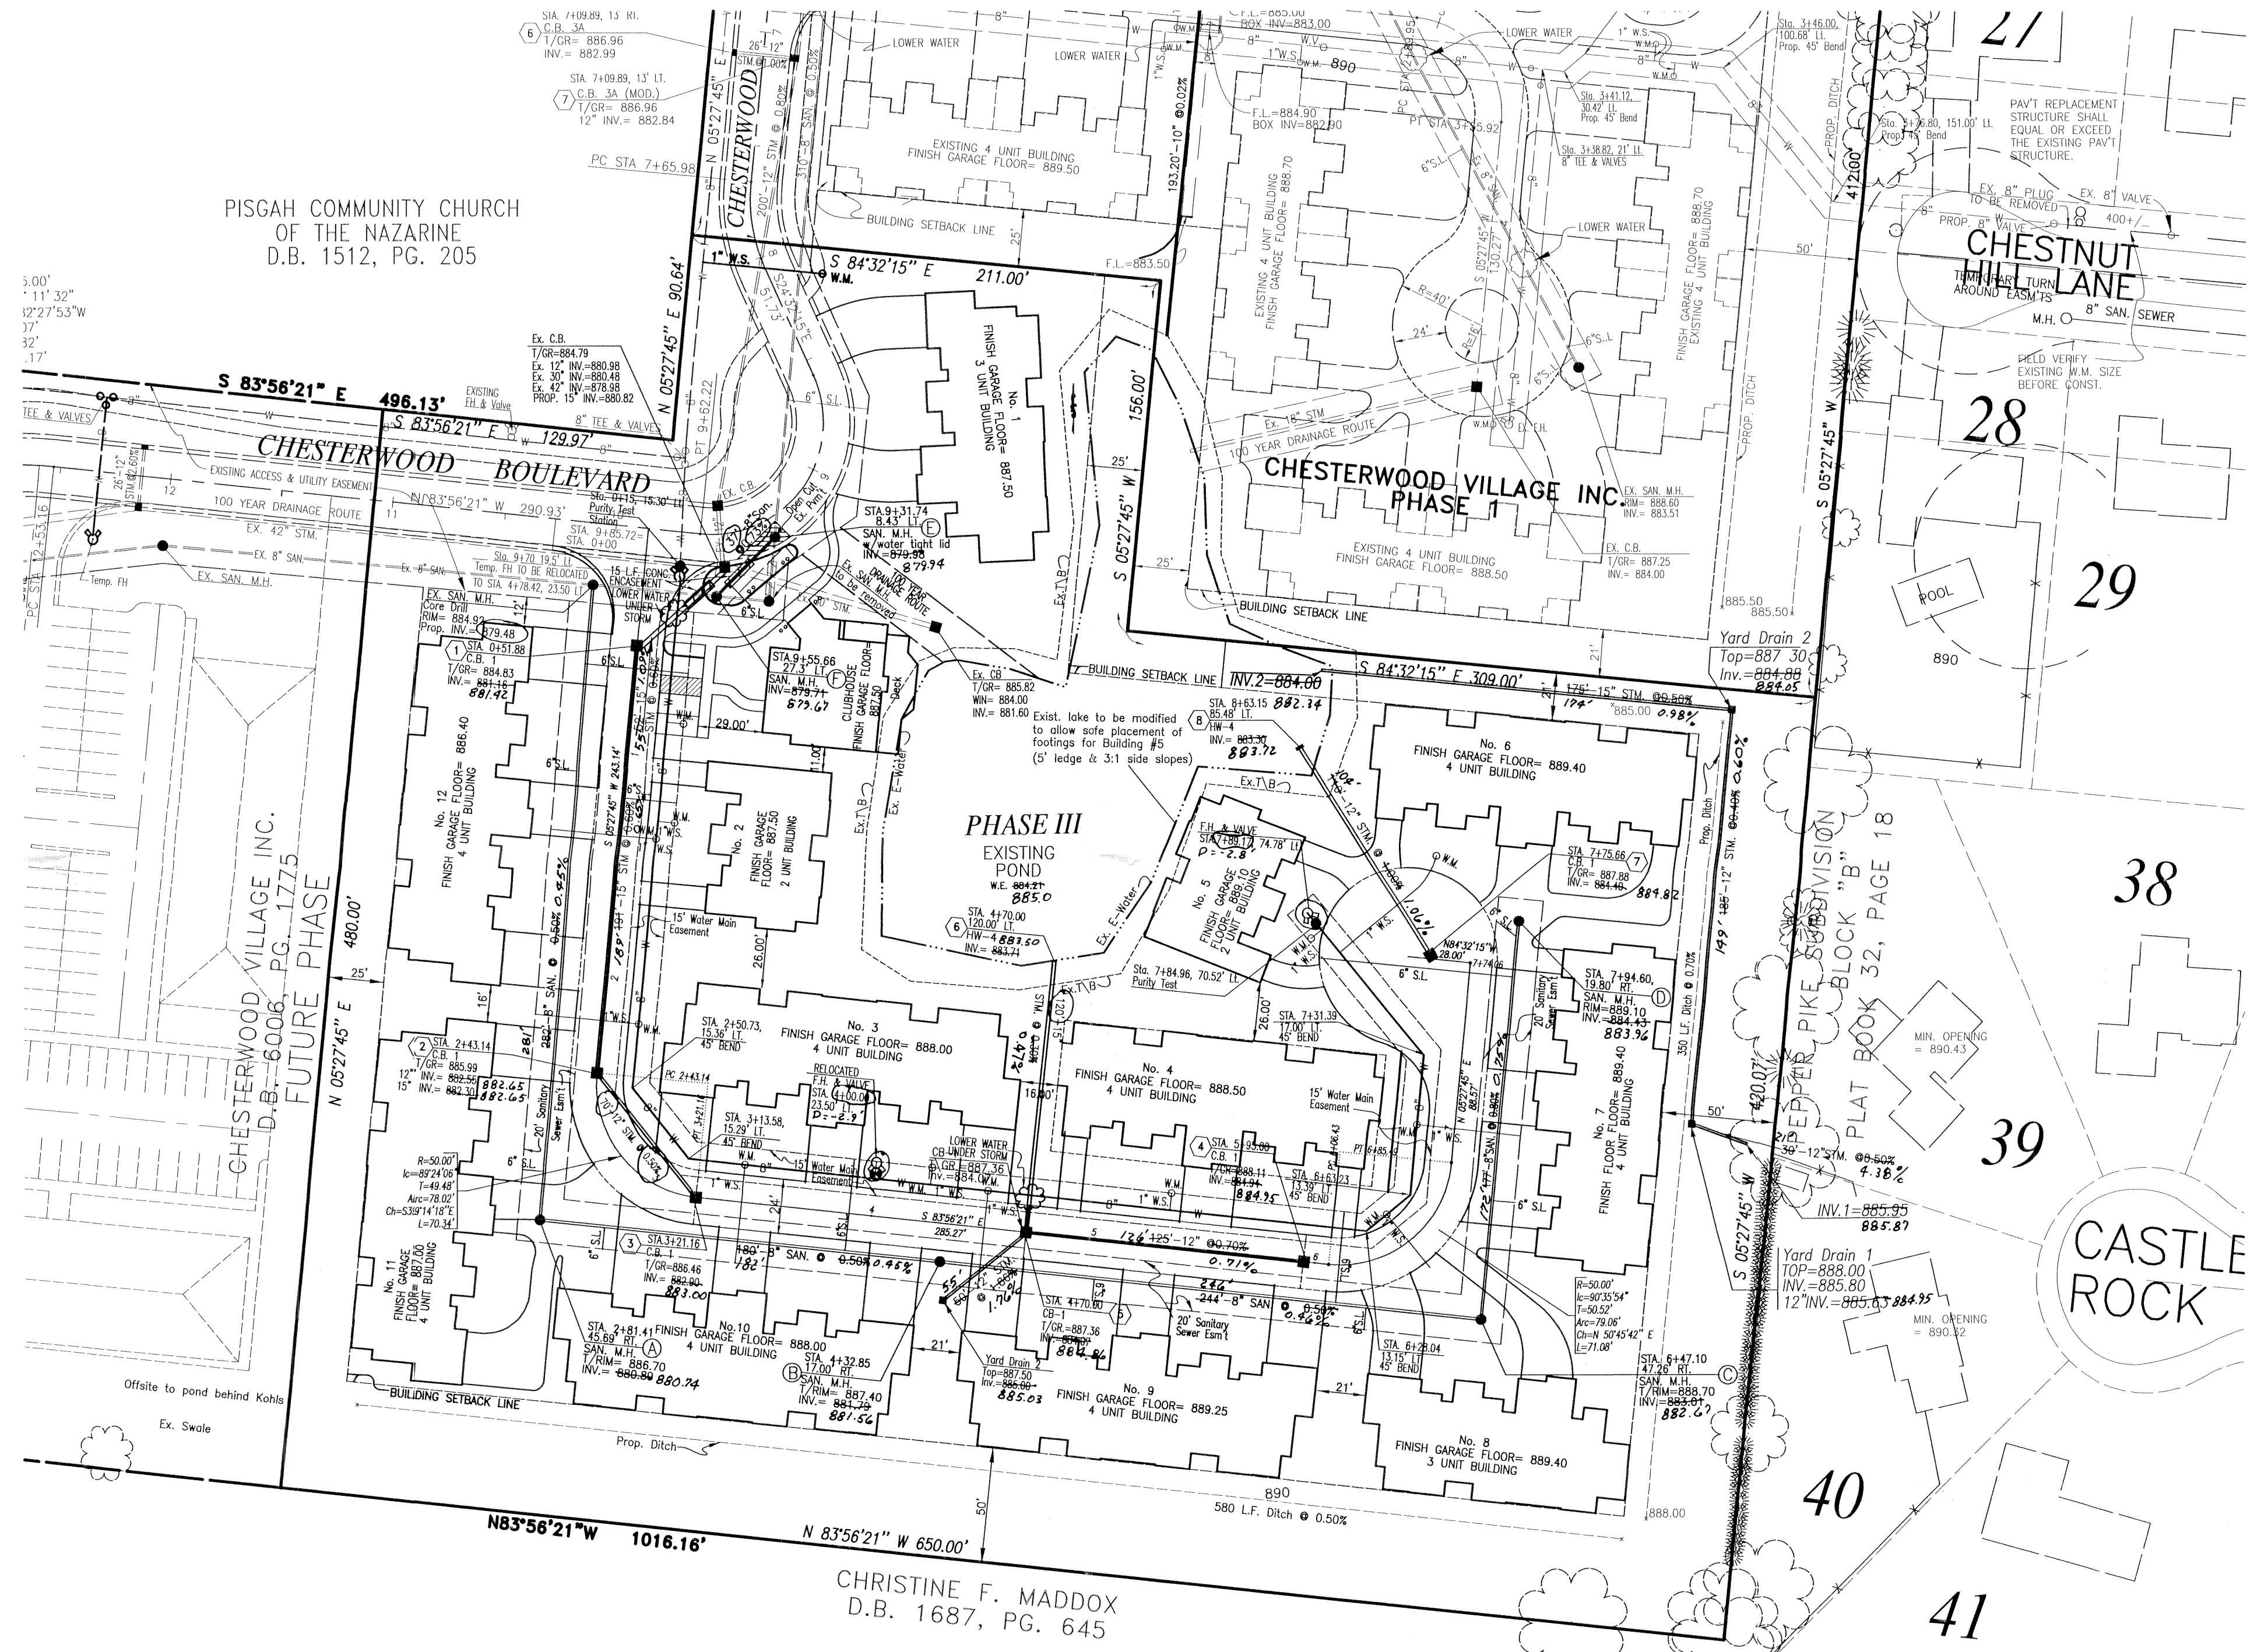

engineers planners surveyors





1220 BELLEVUE DR. LAWRENCEBURG, N. 47025-1912
812-537-9084

CHESTERWOOD RETIREMENT
COMMUNITY
PHASE THREE

UTILITY
PLAN

ITEM	REVISIONS	DATE
7	Rev. cul-de-sac, bldg 5 location, utils, dims.	7/03/01
6	Rev. San. Alignment at clubhouse	6/18/01
5	Revised Buildings	5/31/01
4	Revised per BODS	5/21/01
3	Revised per Butler County & BODS	5/11/01
2	Revised per Butler County	3/4/97
1	Revised per Owners Request	3/4/97

AutoCAD
Drawing Name: M9579.DWG
DATE: 10-30-96

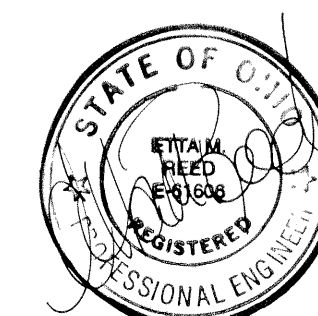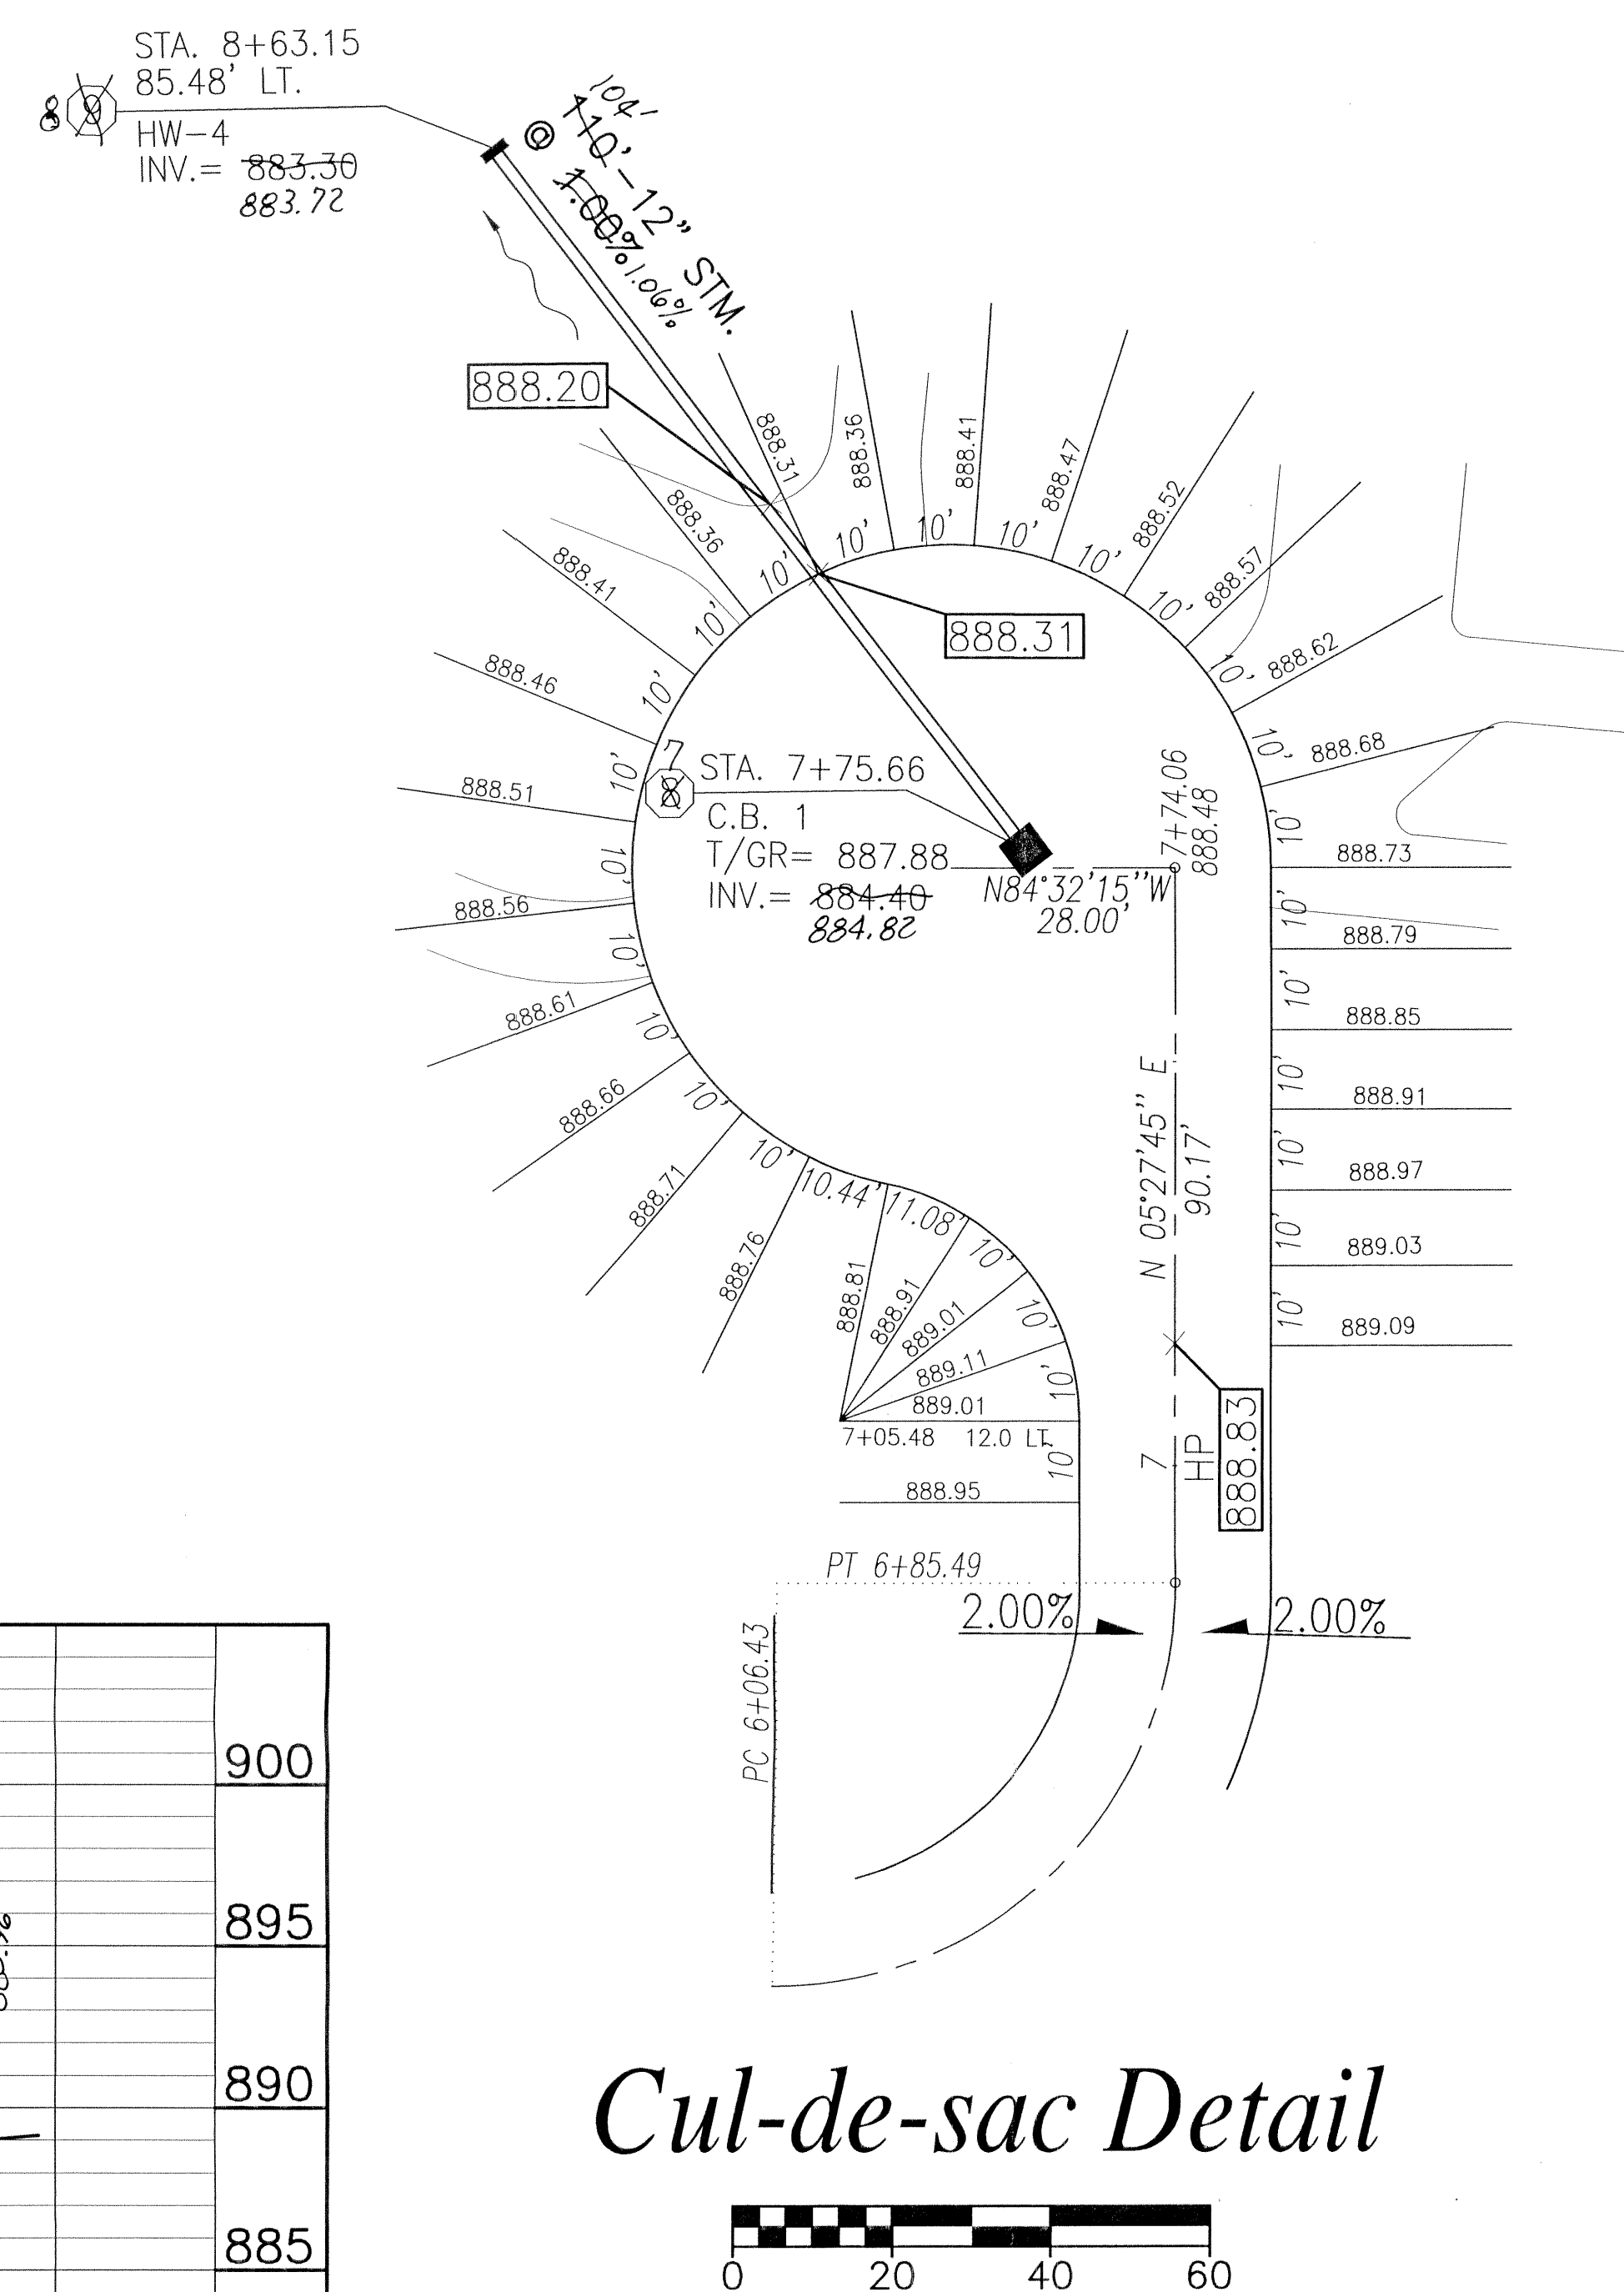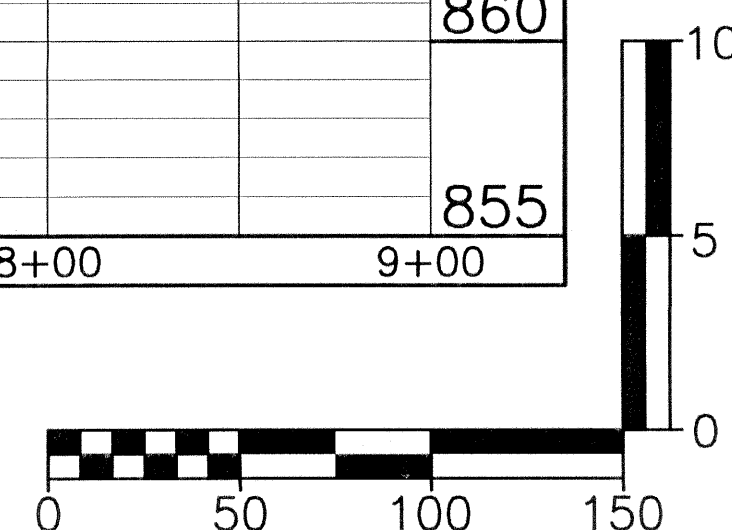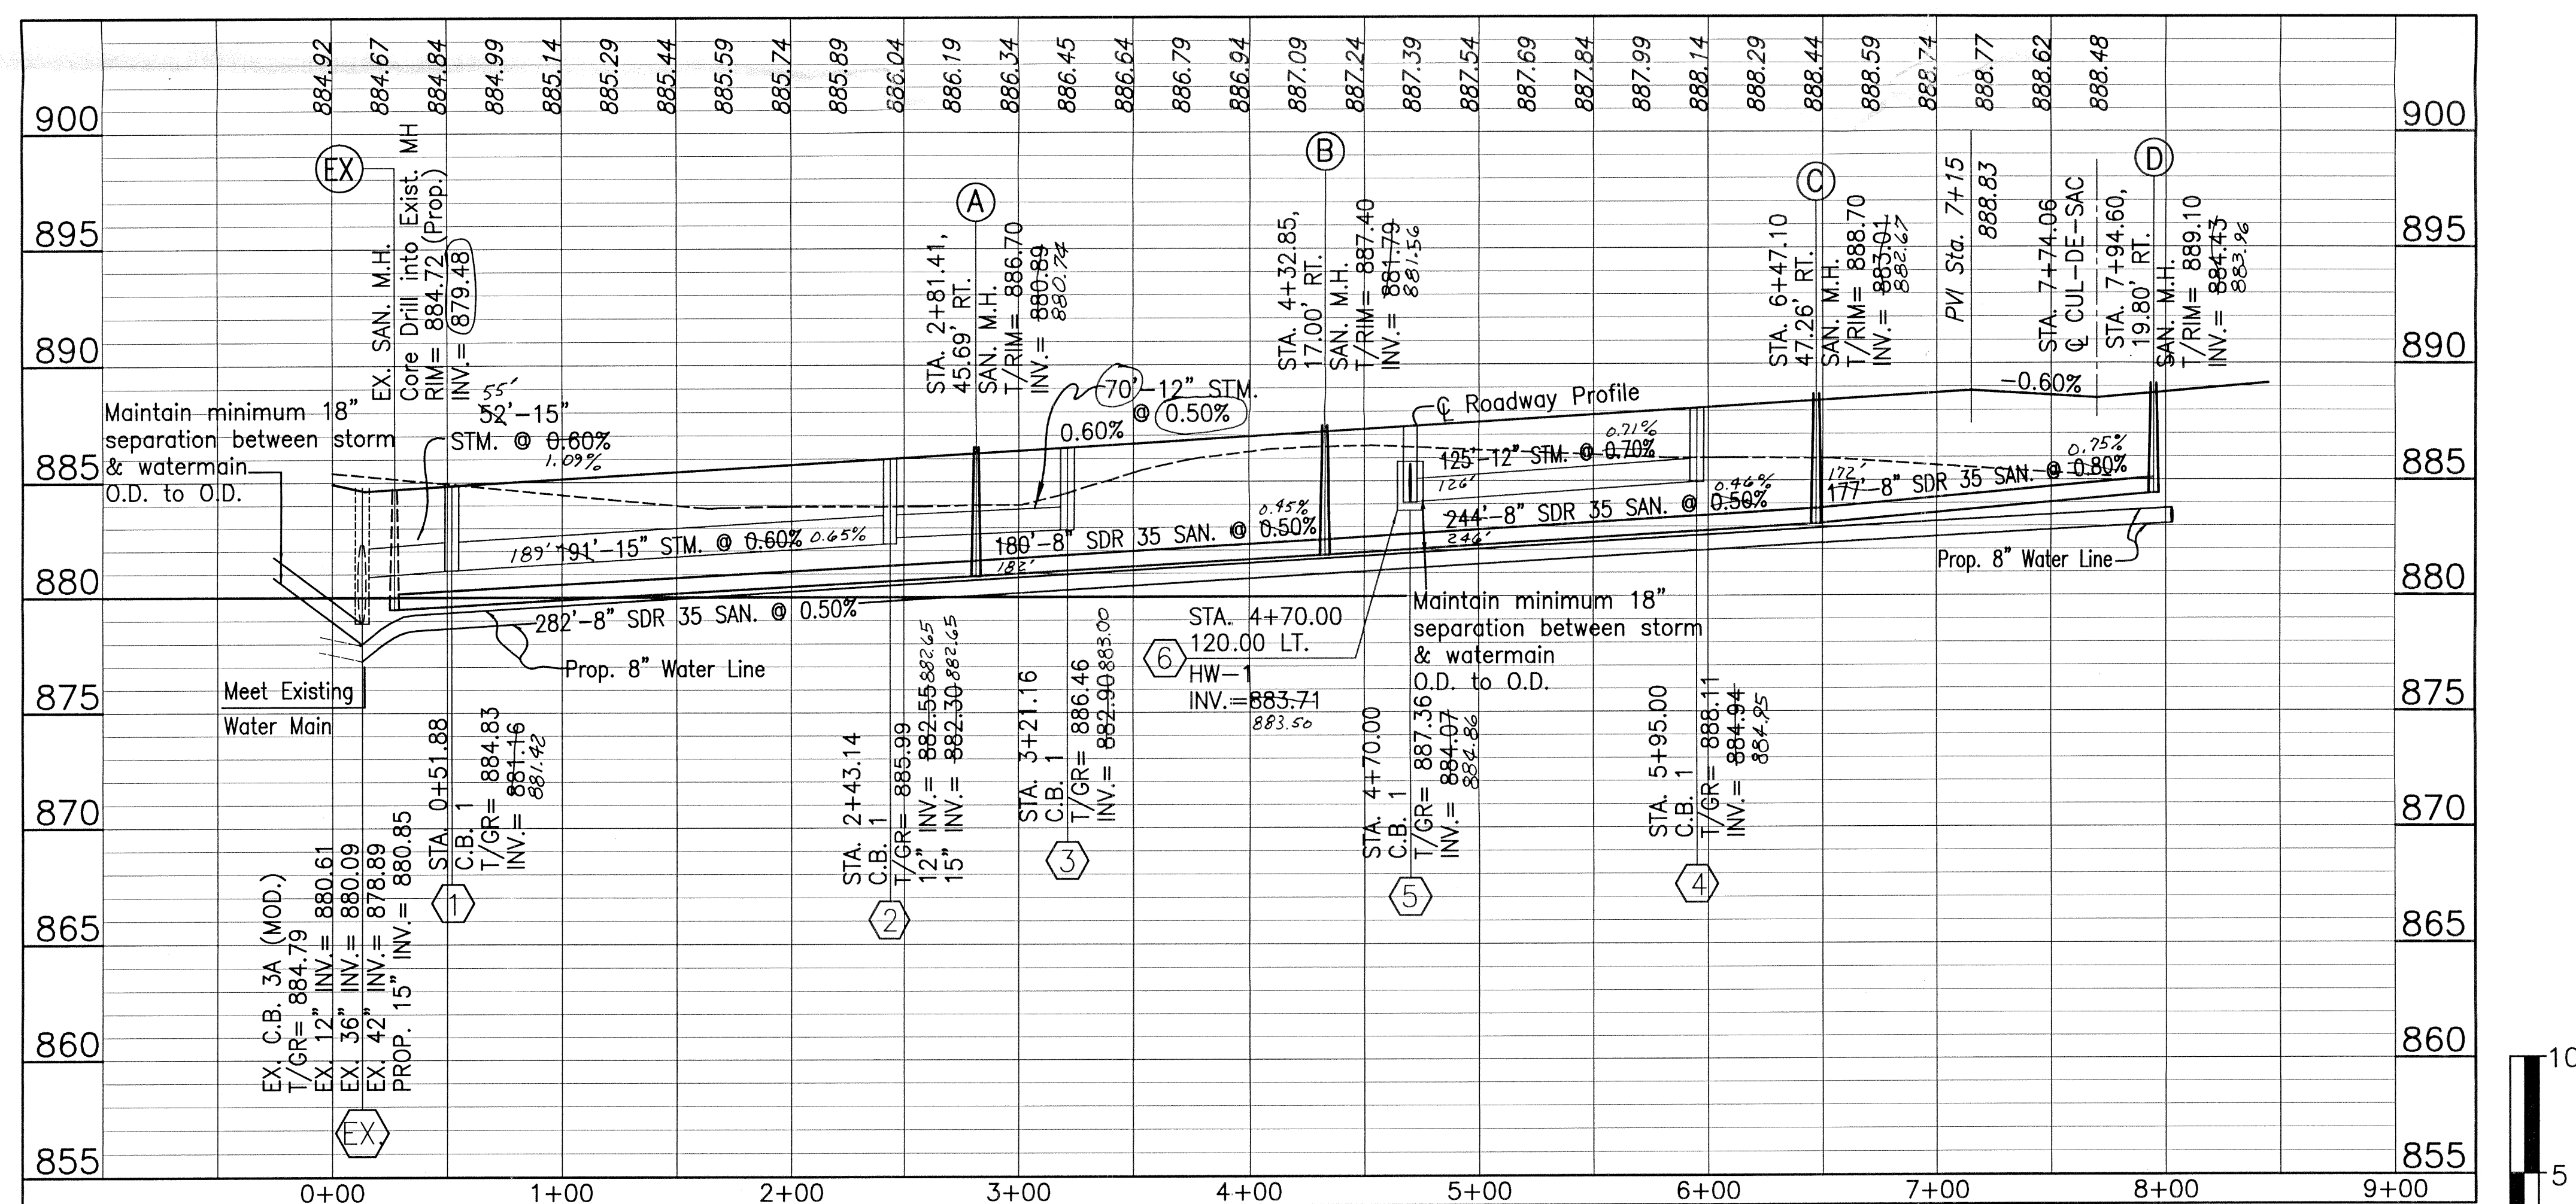

7		
6	Rev. cul-de-sac, bldg 5 location, utils, dims.	7/03/01
5	Revised per BCDES	5/21/01
4	Revised per Butler County & BCDES	5/11/01
3	Revised Cal-de-sac Detail	9/8/97
2	Revised per Owners Request	3/4/97
1	Complete for Union Township Submittal	11/4/96