






NOTE:
UNDERGROUND UTILITIES ARE PLOTTED FROM A
COMPIATION OF AVAILABLE RECORD INFORMATION AND
SURFACE INDICATIONS OF UNDERGROUND STRUCTURES AND
MAY NOT BE INCLUSIVE. PRECISE LOCATIONS AND THE
EXISTENCE OR NON EXISTENCE OF UNDERGROUND UTILITIES
CANNOT BE VERIFIED. PLEASE NOTIFY THE OHIO UTILITY
PROTECTION SERVICE AT 1-800-362-2764 BEFORE ANY PERIOD
OF EXCAVATION OR CONSTRUCTION ACTIVITY.

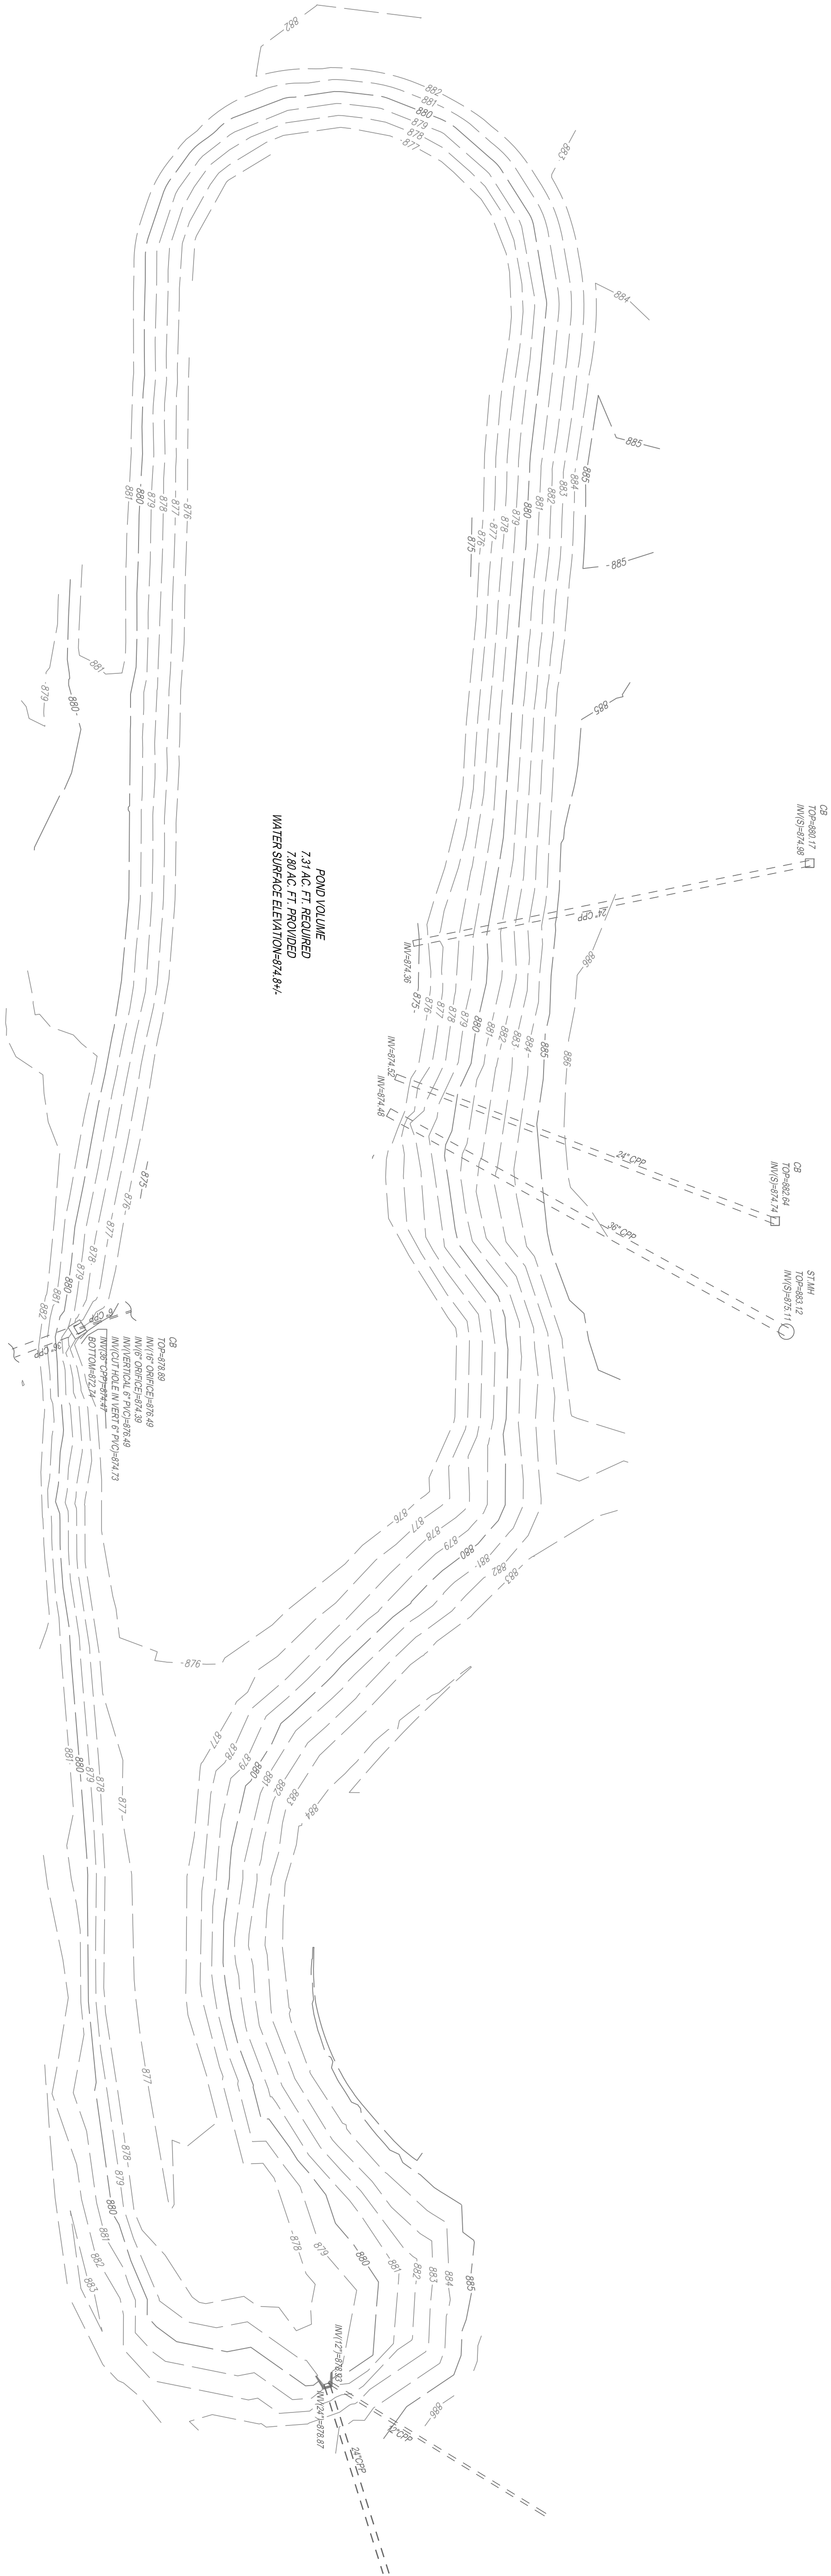

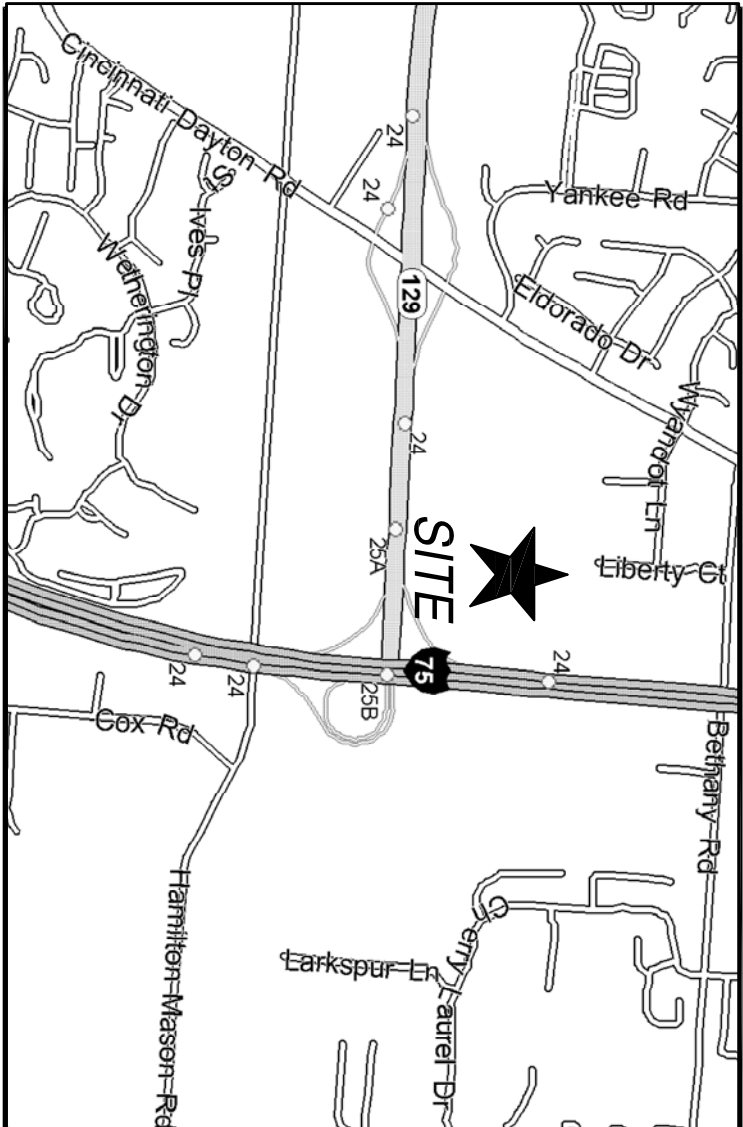


THE KLEINGERS GROUP

CIVIL ENGINEERING | www.kleingers.com
SURVEYING | 6025 Graham Park Dr.
LANDSCAPE ARCHITECTURE | West Chester, OH 43089
513.773.7851

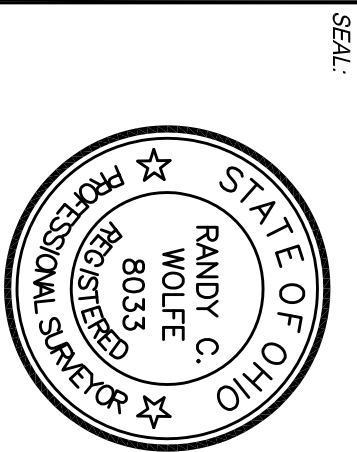

NO. DATE: 05/29/2013
12/13/13 DETENTION AS-BUILT - NDH

TOPOGRAPHIC SURVEY
DETENTION POND
SECTION 13, TOWN 3, RANGE 3
LIBERTY TOWNSHIP
BUTLER COUNTY, OHIO
FOR: NELSON STARK CO.
PROJECT NO. 130037VA8006
DATE: 12/13/2013

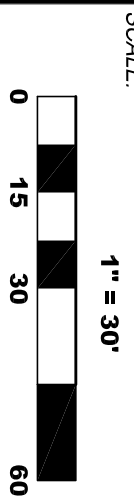

DETENTION POND
AS-BUILT

SHEET NO.

1 OF 1