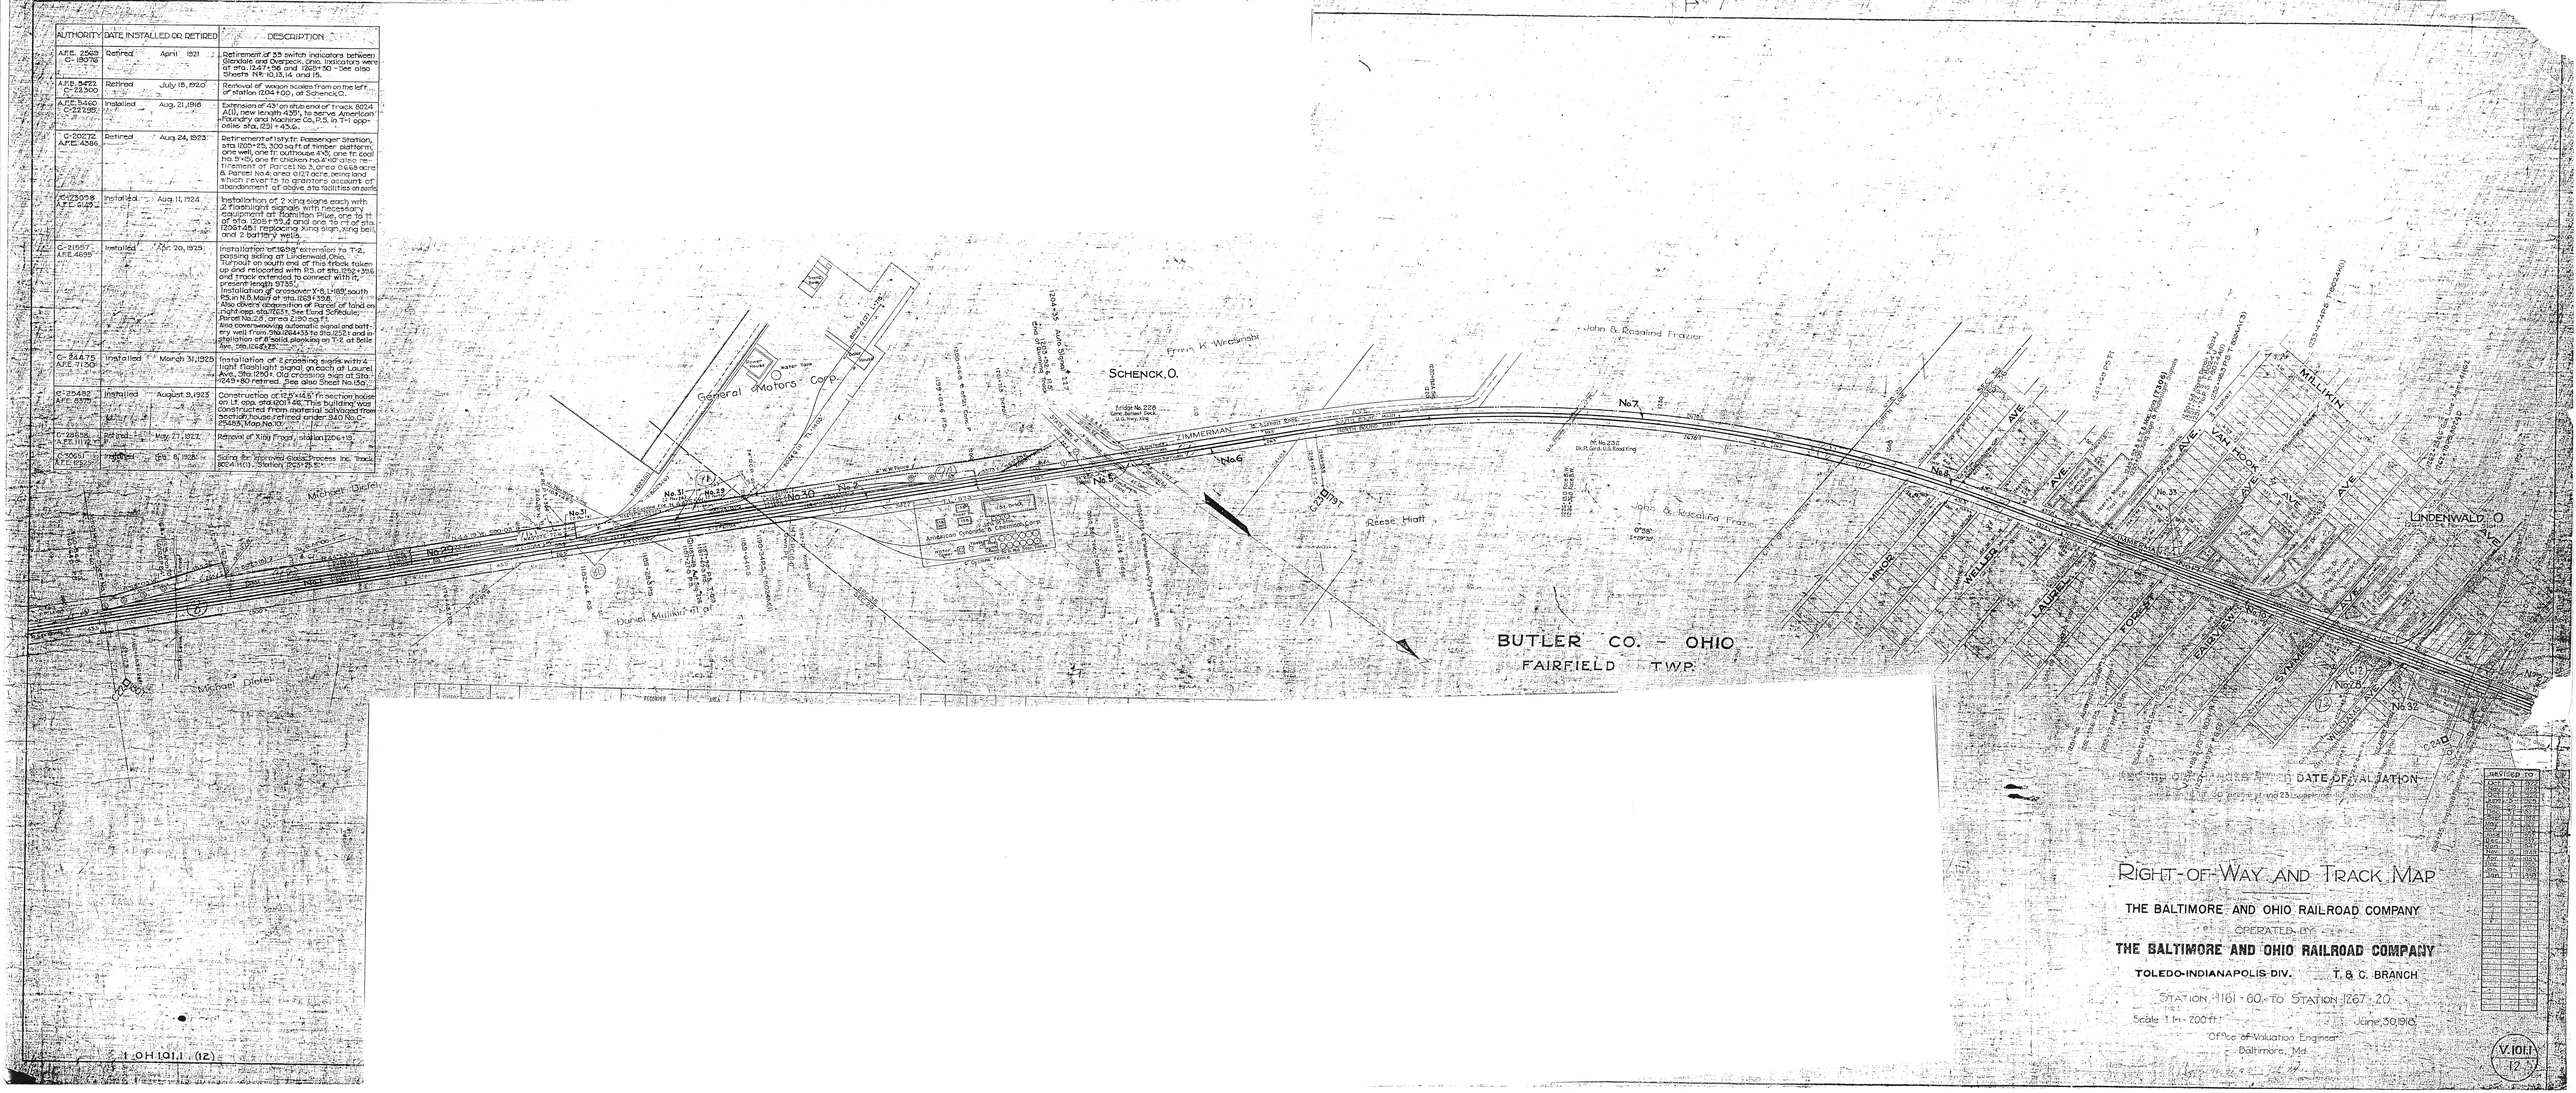AUTHORITY	DATE INSTALLED OR RETIRED		DESCRIPTION
A.F.E. 2563 C-19076	Retired	April 1921	Retirement of 33 switch indicators between Glendale and Overpeck, Ohio. Indicators were at sta. 1247+96 and 1321+90 - See also Sheets Nr: 10,13,14 and 15.
A.F.E. 5422 C-23300	Retired	July 18, 1920	Removal of wagon scales from on the left of station 1204+00, at Schenck, O.
A.F.E. 5460 C-22338	Installed	Aug. 21, 1918	Extension of 43' on stub end of track 8024 A(1), new length 455', to serve American Foundry and Machine Co. P.S. in T-1 opposite sta. 1251+43.6.
C-20072 A.F.E. 4386	Retired	Aug. 24, 1923	Retirement of sty fr. passenger station, sta 1220+25, 300 sq.ft. of timber platform, one well, one fr. outhouse 4x5, one fr. coal ho. 9'x15', one fr. chicken ho. 4'x10' also fireplace of Parcel No. 3, area 0.468 acres & Parcel No. 4, area 0.127 acre, being land which reverts to grantors account of abandonment of above sta. facilities on same
C-23028 A.F.E. 6149	Installed	Aug. 11, 1924	Installation of 2 xing signs each with 2 flashlight signals with necessary equipment at Hamilton Pike, one to rt. of sta. 1205+99.4 and one to rt. of sta. 1206+48.1 replacing xing sign, xing bell and 2 battery wells.
C-21557 A.F.E. 4699	Installed	Mar. 20, 1925	Installation and signal extension to T-2, passing siding at Lindenwald, Ohio. Turnout on south end of this track taken up and relocated with P.S. at sta. 1262+30.6 and track extended to connect with it, present length 9735'. Installation of crossover X-8, L-183, south P.S. in N.B. Main at sta. 1223+39.8. Also divers disposition of Parcel of land on right esp. sta. 1263.1. See Land Schedule: Parcel No. 2.8, area 2,260 sq.ft. Also overswerking automatic signal and battery well from sta. 1264+43.5 to sta. 1251 and installation of 8' solid planking on T-2 at Belle Ave. sta. 1264+32.5.
C-24475 A.F.E. 7150	Installed	March 31, 1925	Installation of 2 crossing signs with 4 light flashlight signal on each at Laurel Ave. Sta. 1260+. Old crossing sign at Sta. 1249+80 retired. See also Sheet No. 150.
C-25482 A.F.E. 6370	Installed	August 3, 1925	Construction of 12.5'x14.6' fr. section house on Lt. esp. sta. 1203+46. This building was constructed from material salvaged from section houses retired under S.O. No. C-25485, Map No. 10.
C-26808 A.F.E. 7112	Retired	May 27, 1927	Removal of Xing Flags, station 1206+13.
C-30651 A.F.E. 8323	Installed	Feb. 6, 1928	Siding for Improved Glass Process Inc. Track 8024 H(1). Station 1253+25.5.