

VICINITY MAP
N.T.S



THE KLEINGERS GROUP

CIVIL ENGINEERING
SURVEYING
LANDSCAPE
ARCHITECTURE

www.kleingers.com

6305 Centre Park Dr.
West Chester, OH 45069
513.779.7851

- LEGEND**
- FENCE LINE
 - EDGE OF WATER
 - TREELINE




SEAL:

NO.	DATE	DESCRIPTION
1	11-15-17	POND ASBUILT - TAR

GEORGIA PACIFIC CORPORATION
SECTION 3, TOWN 2, RANGE 2
WEST CHESTER
BUTLER COUNTY, OHIO

PROJECT NO: 160544.000

DATE: 11-15-2017

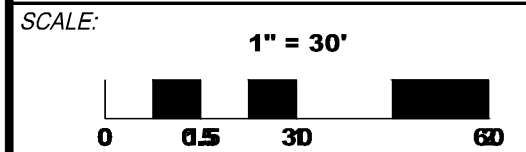

SHEET NAME: 9048
PORT UNION -
RIALTO ROAD

SHEET NO. 1 OF 1

NOTE:
UNDERGROUND UTILITIES ARE PLOTTED FROM A
COMPILATION OF AVAILABLE RECORD INFORMATION AND
SURFACE INDICATIONS OF UNDERGROUND STRUCTURES AND
MAY NOT BE INCLUSIVE. PRECISE LOCATIONS AND THE
EXISTENCE OR NON EXISTENCE OF UNDERGROUND UTILITIES
CANNOT BE VERIFIED. PLEASE NOTIFY THE OHIO UTILITY
PROTECTION SERVICE AT 1-800-362-2764 BEFORE ANY PERIOD
OF EXCAVATION OR CONSTRUCTION ACTIVITY.



- NOTES:**
- BEARINGS ARE ASSUMED
 - VERTICAL DATUM IS BASED ON THE FINISH FLOOR
ELEVATION 605.00' OF THE WAREHOUSE ADDITION ON
SHEET C-1 OF PROFESSIONAL DESIGN ASSOCIATES
DATED 27 MARCH 2017