SHANNON RIDGE
SECTION TWO
SECTION 33, TOWN 3, RANGE 3
LIBERTY TOWNSHIP, BUTLER COUNTY, OHIO
MARCH, 2018

Know what's **below.** **Call** before you dig.

SUBDIVISION CONSTRUCTION DRAWINGS — APPROVED

EJP 03/14/2019

INDEX TO SHEETS

Title Sheet	1
Typical Sections, Profile	2
Plan & Profile	3–7
Grading Plan	8–10
Grading Plan	11
Detail Sheets	12–14
Soil Erosion & Sedimentation Control Detail Sheet	15

LEGEND

EXISTING CONTOURS
PROPOSED CONTOURS
CENTERLINE
PROPERTY LINE
EXISTING SANITARY SEWER & MANHOLE
PROPOSED SANITARY SEWER & MANHOLE
EXISTING WATER MAIN
FIRE HYDRANT
WATER VALVE
PROPOSED WATER MAIN
EXISTING GAS MAIN
SUMP DRAIN LINE
EXISTING STORM PIPE & CATCH BASIN
STORM CATCH BASIN
STORM MANHOLE
PROPOSED STORM PIPE
EXISTING TELEPHONE
EXISTING CABLE
DIRECTION OF DRAINAGE
PROPOSED SWALE
LOT SWALE

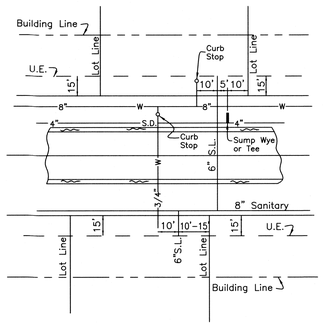

STANDARD SERVICE DETAIL

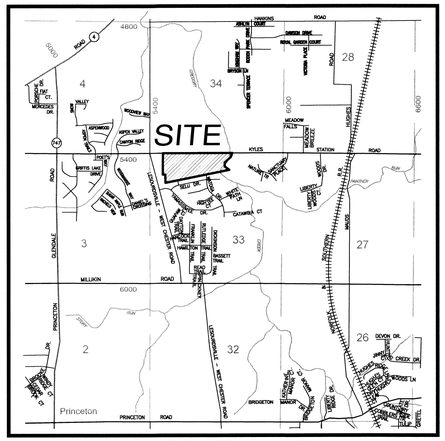

VICINITY MAP
NOT TO SCALE

JOB LOG

DATE	COMMENT
1-24-18	Submitted to Butler County Planning
2-6-18	Resubmitted to BCWS
3-9-18	Resubmitted to BCEO

OWNER/DEVELOPER

Kyles Land Development LLC
4166 Tonya Trail
Hamilton, OH 45011
(513)- 813- 5595

BENCHMARK

Found Magnail at the Northeast Corner of the Property
Elevation = 650.09

SUPPLEMENTAL PRINTS OF STANDARD CONSTRUCTION DRAWINGS

C-1	
Std.MH-1A	
Std.HW-D	HW-1 (O.D.O.T.)
CB-3	
CB-3(Mod.)	
CB-3A	
CB-3A(Mod.)	CB-2-4(O.D.O.T.)
CB-2-2-A(O.D.O.T.)	CB-2-3(O.D.O.T.)
CB-2-2-B(O.D.O.T.)	CB-2-5(O.D.O.T.)
Std.R-1	

CONSTRUCTION APPROVAL

	Date
Butler Co. Water & Sewer Dept.	2-12-18
Butler Co. Engineer's Office	3-23-18
But.Co. B. & Z. Flood Permit	3-14-18

These plans are not for construction until ALL approval dates have been filled in.

GENERAL NOTES

1. Item numbers refer to the Ohio Department of Transportation construction and material specifications, and all construction work shall be done according to said specifications of Butler County requirements and standards for subdivisions. When in conflict, the County requirements shall prevail.

2. Items that pertain to underground utilities such as watermain pipe, sanitary sewer pipe, water valves and manhole frames and covers, etc., will remain under specifications of the utility serving the area. Storm sewers shall be designed and constructed in accordance with the requirements of the Butler County Engineer.

3. All trenches within the right–of–way and 10' utility easement shall be compacted and backfilled in accordance with item 203 and 603 in the state specifications.

4. Surface course (item 448) and tack coat (item 407) are to be applied no sooner than nine (9) months after the leveling course, (item 448), and fifty (50) percent of the homes are completed. If after two (2) years fifty (50) percent of the homes have not been completed, then the top course may be applied.

5. A minimum 10' utility easement shall be shown on the record plat parallel and immediately adjacent to the right–of–way line allowing for installation, operation and maintenance of sewers, water, electric and telephone conduits and any other public or quasi public utility.

6. Developer shall be responsible for the installation of conduits for the full width of the public right–of–way at a depth of 36" for use by the electric, telephone and cable services. The location of the lines shall be coordinated with utility companies by the developer.

7. All electrical transformers shall be located so that they do not interfere with the existing manholes or water main appurtenances.

8. Sump line conduits are to be SDR 35, Armco 2000, or equivalent.

9. WATER MAIN
A. Water main materials, valves, fire hydrants, fittings and appurtenances and installation to be as per Butler County specifications, using class 53 Ductile Iron as per AWWA C–151 with minimum 4' cover.

B. All water main valves to have a minimum depth of 2.5' and a maximum depth of 4' from proposed grade to the top of the Valve Operating Nut.

C. Minimum 10' horizontal, 18" vertical separation between water main and sanitary and/or storm sewer.

D. If meter pits cannot be initially installed at the location shown on the typical section, a curb stop can be set up at this location.

10. SANITARY SEWER
A. Sanitary sewer materials and installation to be as per Butler County specifications, using Section 3110 for PVC SDR–35 & 26 pipe; Section 3140 for ABS or PVC composite pipe; Section 3410 for manholes.

B. Crossings Whenever a sanitary sewer and water main must cross, the sewer shall be at such an elevation that the crown of the sewer is at least 18 inches measured between the outside pipe walls, below the bottom of the water main.
If it is absolutely impossible to maintain the 18 inch vertical separation, the water main shall be relocated or the sewer shall be constructed as follows:

1. A sewer passing over or under the water main shall be encased or constructed of materials that are equivalent to water main standards of construction for a minimum distance of 10 feet on each side of the water main.
2. The sewer crossing shall be constructed so that the sewer joints will be equidistant and as far as possible from the water main joints.
3. Where a water main passes under a sewer, adequate structural support shall be provided for the sewer to prevent damage to the water main.

C. Sanitary laterals shall be extended to at least ten (10) feet beyond the Property / Right–of–Way or to the edge of the easement, whichever is greater.

D. Sanitary sewer laterals, which shall include all pipe and appurtenances from the building to the public sewer main, and the connection to the public sewer main shall be considered private and the responsibility of the property owner to maintain. The connection to the sewer would be any piping that extends out from the main barrel of the sewer main.

E. All buildings to be served by the public sewer system shall be constructed so as to provide a minimum of four feet (4') of vertical separation between the public sanitary sewer, at the point of connection, and the lowest building level served by a gravity sewer connection and shall not exceed a depth of 12 feet below finish grade at the end of the lateral at the right–of–way unless specifically authorized by the County. In addition, said building level shall be at least one (1) foot above the lowest point of free–overflow (non–sealed manhole cover) upstream of any treatment facility of wastewater pumping facility that receives the discharge from said building. Said minimum service levels shall be recorded on the "As–built" plans for the development which will be kept on file in the office of the Butler County Department of Environmental Services.

11. Butler County Water and Sewer Department does not accept any responsibility for the relocation, repair, or replacement of any other utility installed within five (5) feet of the center line of any sanitary sewer main or water main.

12. Private driveways, parking lots and other paved areas, earthen berms or structures should not be constructed over private water or sewer service lines within the public road right of way or within the easement areas for public utilities. Should this occur, the property owner shall be held responsible for the protection and repair and for providing access to any curb stops, meter pits, manholes, clean–outs, etc. installed in conjunction with these private service lines and for any damage or restoration of the paved surfaces or structures that may result from the future operation, maintenance, repair or replacement of said service lines and appurtenances.

13. STORM SEWER
A. Storm sewer pipe shall meet the requirements as follows:
1. PVC pipe as per ODOT Specification 707.42 for all diameters
2. HDPE pipe as per ODOT Specification 707.33
3. Corrugated steel pipe as per ODOT Specification 707.01 or 707.02 for all diameters
4. Reinforced concrete pipe as per ODOT Construction and Material Specification 706.02 for all diameters. Class shall be specified at the contractor's request. (Cincinnati Concrete Pipe, Duracrete or equal).
5. Bituminous coated corrugated steel pipe as per ODOT Specification 707.05 or 707.07

Installation shall meet Butler County Specifications. All joints shall be soil seal joints unless specifically noted on the plans.

B. Deflection Testing for Storm Sewers and Culverts 15% of all storm sewers shall be tested for deflection within thirty days after they are complete. Butler County Engineer or his designated representative will determine what 15% shall be tested. If any storm sewer in the original 15% is found out of compliance, deflection tests will be required on 100% of the remaining storm sewer. A vertical ring deflection greater than 5% will not be allowed. This deflection is defined as 5% reduction in the vertical base or average inside diameter. The method of testing shall be subject to the approval of the engineer. If rigid balls or mandrels are used to test pipe deflection, no mechanical pulling devices shall be used. The deflection test may be conducted with a nine prong mandrel, a ball or a cylinder or another manner acceptable to the Butler County Engineer or his designated representative. The testing will be accomplished from manhole to manhole or catchbasin to catchbasin, following the complete flushing of the line. The contractor shall furnish all equipment required to complete the deflection testing. The deflection test shall be witnessed by the County Engineer or his designated representative. Any section of pipe that fails to meet the aforementioned requirements shall be rerounded by a procedure acceptable to the County or be excavated and either be relayed or replaced, and retested until the requirements are met.

C. All catch basins and manholes with a depth greater than 4' shall be provided with steps. Steps shall meet the requirements of ODOT STD. 604 and shall conform to the details as shown on Butler County Standard Drawing MH–1A.

D. Headwall: HW–4A to be used with Corrugated Metal pipe or HW–4B to be used with Concrete Pipe.

13. Roof drains, foundation drains, and other clean water connections to the sanitary sewer system are prohibited.

14. Any detention basin on site should be constructed prior to the clearing of topsoil and grading of the site. All trees and vegetation shall be removed from all proposed detention basins regardless of maintenance responsibility.

15. SEDIMENTATION CONTROL
The project has been designed to control erosion and prevent damage to other property. All stripping, earthwork, and regrading shall be performed to minimize erosion. Natural vegetation shall be retained wherever possible. The proposed plan will allow almost all eroded material to be retained on site.

All areas disturbed by the construction of the roadways, ditches and sediment basins shall be seeded and strawed as soon as possible to limit the erosion and stabilize the soil. Payment will be by the number of square yards disturbed as per the grading plan. For additional sedimentation control details, see grading plan.

16. Butler County will not be responsible for any pavement or storm sewer repairs resulting from water main and sanitary sewer repairs. Butler County also will not be responsible for adjusting manholes, valves, fire hydrants, meter pits, etc. as a result of grade changes. The grantor shall be responsible for proper adjustment of manholes, valves, fire hydrants, meter pits, etc. to the satisfaction of Butler County, due to grade changes, paving, repairing, etc. initiated by the grantor.

17. A typical five (5) foot drainage easement is to be provided on both sides of every lot line.

18. Any roadway settlement greater than one inch will be required to be repaired with Item 613 Low Strength Mortar Backfill (Type 1). See Detail on Sheet #12.

19. Provide the Butler County Engineer's Office with a forty–eight (48) hour notice prior to the start of any construction, including sanitary installation. Phone 785–4145.

20. Contractors to accept all Quantities as correct prior to beginning construction.

21. Contractor shall include the cost of County inspection and extension fees in unit price bid.

22. Existing Zoning: R–PUD
Frontage: 90'
Setbacks: Front = 30', unless otherwise noted on plan
Side = 8'Min., 20'Total
Rear = 40', unless otherwise noted on plan

23. Total Acreage: 57.9175 Acres
24. Total # Single Family Lots: 84

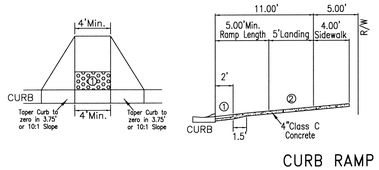

CURB RAMP DETAIL

① Detectable Warning (Truncated Domes) are to be installed in the location shown. Dimensions of the domes are 24" from the back of the curb by the width of the ramp.

② Minimum Landing is to be 4' but 5' is preferred. The slope of the ramp is preferred to be 12:1 or flatter related to the horizontal, but the minimum slope shall be 12:1 relative to the existing or proposed walk slope.

③ Curb ramps shall be design A or design B per ODOT Drawing 7–12–02, sheets 1 thru 3. Truncated domes are to meet the specifications of ODOT drawing 7–12–02 sheet 3.

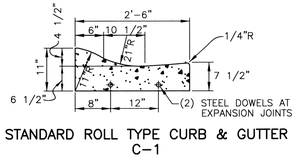

STANDARD ROLL TYPE CURB & GUTTER C–1

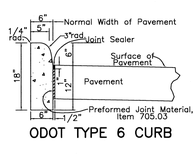

ODOT TYPE 6 CURB

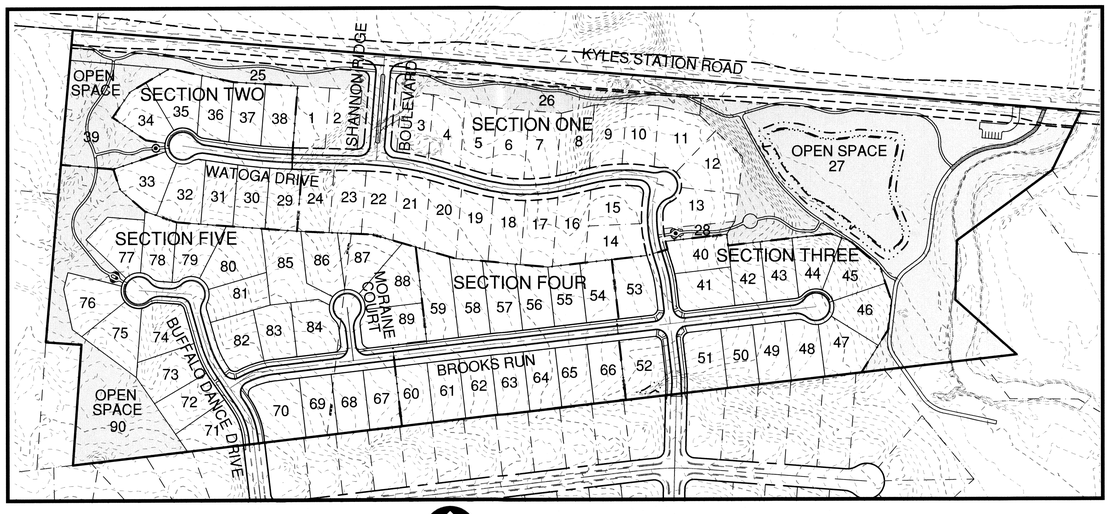

PROPERTY MAP
1"=200'

BUTLER COUNTY ENGINEER'S OFFICE
STANDARD DETAIL FOR
ROADWAY PAVEMENT RESTORATION

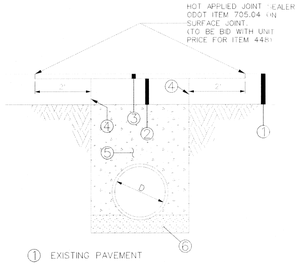

PRINTED
FEB 20 2019

Item	Revision Description	Date	Drwn.	Chk:
1	Revised as per BCWS	2-6-18	TAC	
2	Revised as per BCEO	3-9-18	TAC	
3	Revised as per In House Review	3-9-18	TAC	
4	Revised as per OEPA	3-19-18	TAC	
5				
6				
7				
8				
9				

SHANNON RIDGE SECTION TWO
SECTION 33, TOWN 3, RANGE 3
LIBERTY TOWNSHIP, BUTLER COUNTY, OHIO
TITLE SHEET

bayer becker
www.bayerbecker.com
6900 Tylersville Road, Suite A
Mason, OH 45040 - 513.336.6600

Drawing:	17-0120 CD2
Drawn by:	TAC
Checked By:	EMR
Issue Date:	1-24-18
Sheet:	1/15

Plot time: Feb 15, 2019 – 4:14pm
Drawing name: J:\2017\17-0120\CW\DWG\17-0120 CD2.dwg – Layout Tab: T1

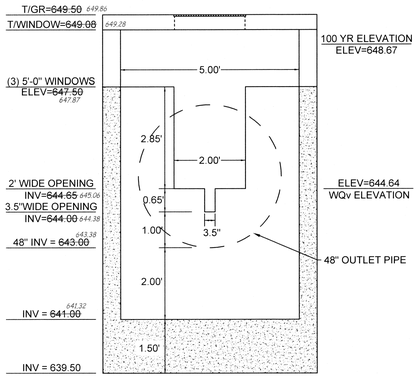

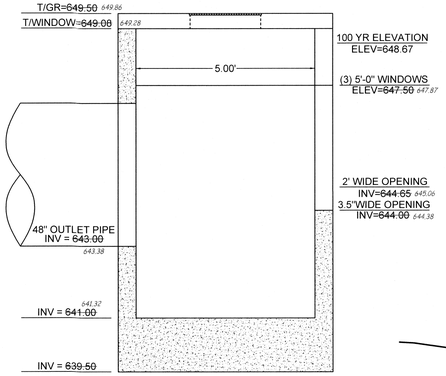

NOTES:
1. CONCRETE BASE UPSIZED TO SERVE AS ANTI-FLOATION BLOCK.
2. CATCH BASIN SECTIONS (INCLUDING LID SECTION) TO BE ANCHORED TO STRUCTURE BASE TO RESIST BUOYANCY FORCES. CONTRACTOR TO PROVIDE SHOP DRAWING FOR ENGINEER REVIEW PRIOR TO INSTALLATION.

DETENTION BASIN OUTLET STRUCTURE - ODOT CB2-5

NOT TO SCALE

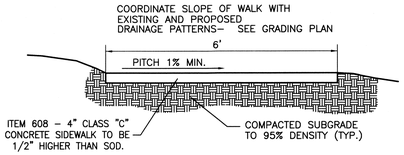

CONCRETE PATH TYPICAL SECTION

(Not to Scale)

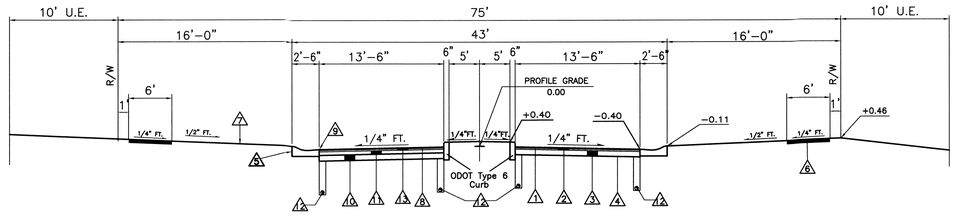

SHANNON RIDGE BOULEVARD
TYPICAL SECTION

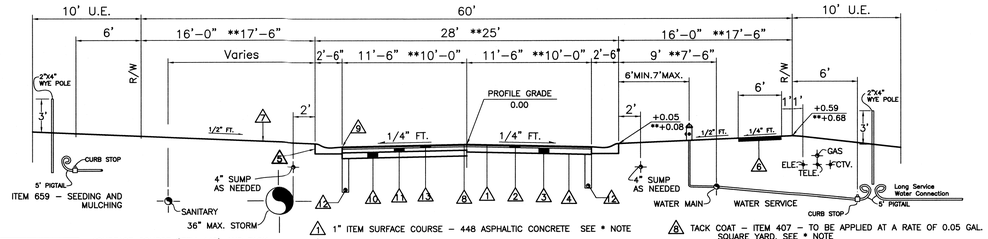

ITEM	DEPTH TOP OF PIPE
Underdrain	18"
Sumplines	24" – 30"
Gas	24" – 30"
Water	48" – 54"
Electric	36" – 40"
Telephone	36" – 40"
Cable TV	36" – 40"

*SURFACE COURSE (ITEM 448) AND TACK COAT (ITEM 407) ARE TO BE APPLIED NO SOONER THAN TWELVE (12) MONTHS AFTER THE LEVELING COURSE (ITEM 448), AND FIFTY (50) PERCENT OF THE HOMES ARE COMPLETED. IF AFTER TWO (2) YEARS FIFTY (50) PERCENT OF THE HOMES HAVE NOT BEEN COMPLETED, THEN THE TOP COURSE MAY BE APPLIED.

TYPICAL SECTION

1. 1" ITEM SURFACE COURSE – 448 ASPHALTIC CONCRETE SEE * NOTE
2. 2 1/2" LEVELING COURSE – ITEM 448 ASPHALTIC CONCRETE
   ** 1 1/2" LEVELING COURSE – ITEM 448 ASPHALTIC CONCRETE
3. 6" BASE COURSE – ITEM 301 BITUMINOUS AGGREGATE BASE
4. COMPACTED SUBGRADE – ITEM 204
5. ROLL TYPE CURB & GUTTER – ITEM 609 (BUTLER COUNTY STANDARD C–1)
6. FOUR INCH THICK CLASS "C" CONCRETE SIDEWALK, SIX FEET WIDE ITEM 608 WALK TO BE 1/2" HIGHER THAN SOD.
7. SEEDING & MULCHING – ITEM 659
8. TACK COAT – ITEM 407 – TO BE APPLIED AT A RATE OF 0.05 GAL. PER SQUARE YARD, SEE * NOTE
9. TACK COAT – ITEM 407 – TO BE APPLIED TO FRONT FACE OF CURB PRIOR TO INSTALLATION OF 301 BITUMINOUS AGGREGATE BASE. ALSO TO BE APPLIED TO CURB JOINT AFTER THE INSTALLATION OF 448 LEVELING COURSE.
10. 6" BASE COURSE – ITEM 304 AGGREGATE BASE
11. 5" BASE COURSE – ITEM 301 BITUMINOUS AGGREGATE BASE
    ** 4" BASE COURSE – ITEM 301 BITUMINOUS AGGREGATE BASE
12. 4" UNDERDRAIN – ITEM 605. CONNECT UNDERDRAIN TO FRONT FACE OF NEAREST CATCH BASIN
13. 1 1/2" LEVELING COURSE – ITEM 448 ASPHALTIC CONCRETE

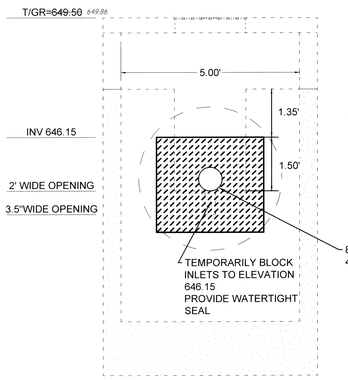

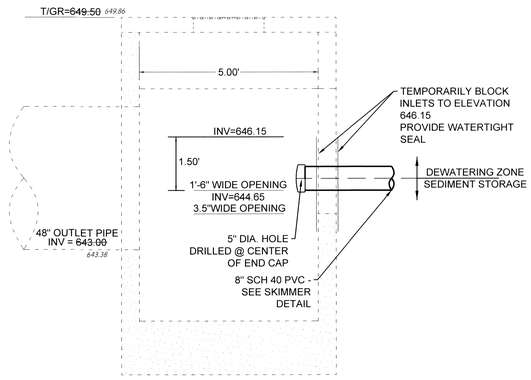

TEMPORARY SEDIMENTATION BASIN RETROFIT

NOT TO SCALE

SKIMMER DEWATERING DEVICE

NOT TO SCALE

NOTES:
1. ALL JOINTS OF THE FLOATATION SECTION SHALL BE GLUED TOGETHER AND WATERTIGHT. JOINTS OF THE SKIMMER SECTION NEED NOT BE WATERTIGHT.
2. TO INSTALL DEWATERING PIPE STUB:
   2.1. FOR CORRUGATED METAL RISER, STUB SHALL BE SCH 40 STEEL PIPE TACK WELDED TO CREATE A WATERTIGHT SEAL.
   2.2. FOR CONCRETE RISER, STUB SHALL BE SCH 40 PVC PIPE GROUTED TO CREATE A WATERTIGHT SEAL.
3. FLEXIBLE, NON-PERFORATED HDPE DRAIN PIPE SHALL BE ATTACHED TO OUTLET STRUCTURE DEWATERING STUB WITH WATER-TIGHT CONNECTIONS.
4. ORIFICE HAS BEEN SIZED FOR A MINIMUM 48-HOUR DEWATERING TIME.

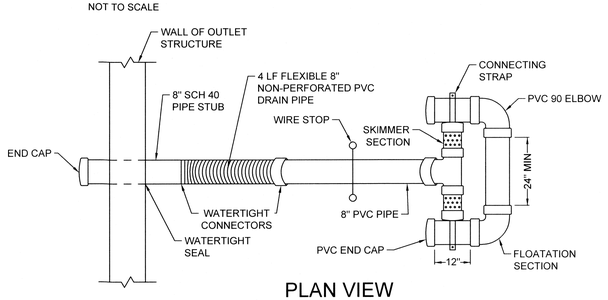

PLAN VIEW

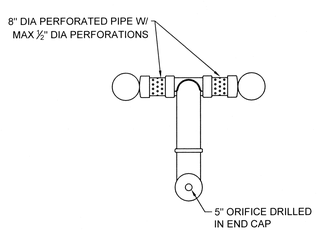

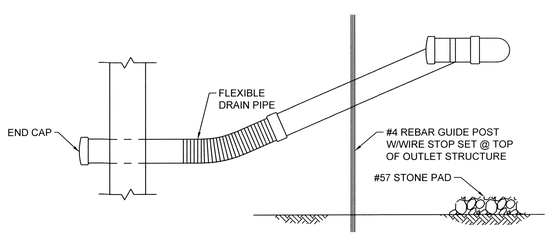

PROFILE VIEW

NOTES:
1. 48 hours notice to be given to affected residents before construction begins.
2. All Catch Basin B/C Elevations located within the curb are set to the Back of Curb Elevations.
3. Lower 3/4" Water Services as needed to avoid conflicts with Storm with Min. 4' Cover.
4. Location of existing utilities to be determined in the field prior to work beginning.
5. All lots Sump to Sump Drain unless otherwise noted in plan.
6. Sump Lines to be installed as per Standard Service Detail. Wyes or Tees are to be placed ten feet past lot line, on the low side of specified lots, and marked with Wye poles.
7. Contractors to accept all quantities as correct prior to beginning construction.

NOTE:
At Crossings, the water main shall have a minimum vertical distance of eighteen (18") inches from storm and sanitary sewers. Also, one full length of water main shall be located so the joints are as far from the storm and sanitary sewers as possible. Fittings, not joint deflection, must be used when water main is lowered at crossings.

WATER MAIN RESTRAINT JOINT LOCATION CHART

Water Main Dia.	Horizontal 45°Bends	Vertical 45°Bends Up (Lower Water Under...)	Vertical 45°Bends Down (Lower Water Under...)	Dead Ends (Permanent & Temporary)	Tees (for Tee Branch) 6"	8"	10"
6"	18' both sides	18' both sides	36' both sides	72' Back	54'		
8"	18' both sides	36' both sides	36' both sides	90' Back	54'	72'	
10"	36' both sides	36' both sides	54' both sides	117' Back	54'	72'	90'
12"	36' both sides	54' both sides	72' both sides	180' Back	36'	72'	90'
14"	54' both sides	54' both sides	90' both sides	198' Back	36'	72'	90'
16"	54' both sides	54' both sides	90' both sides	216' Back	36'	54'	90'

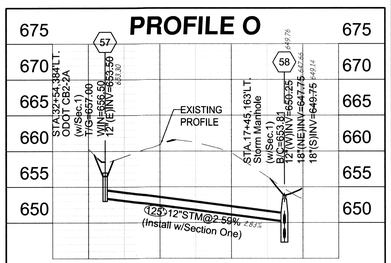

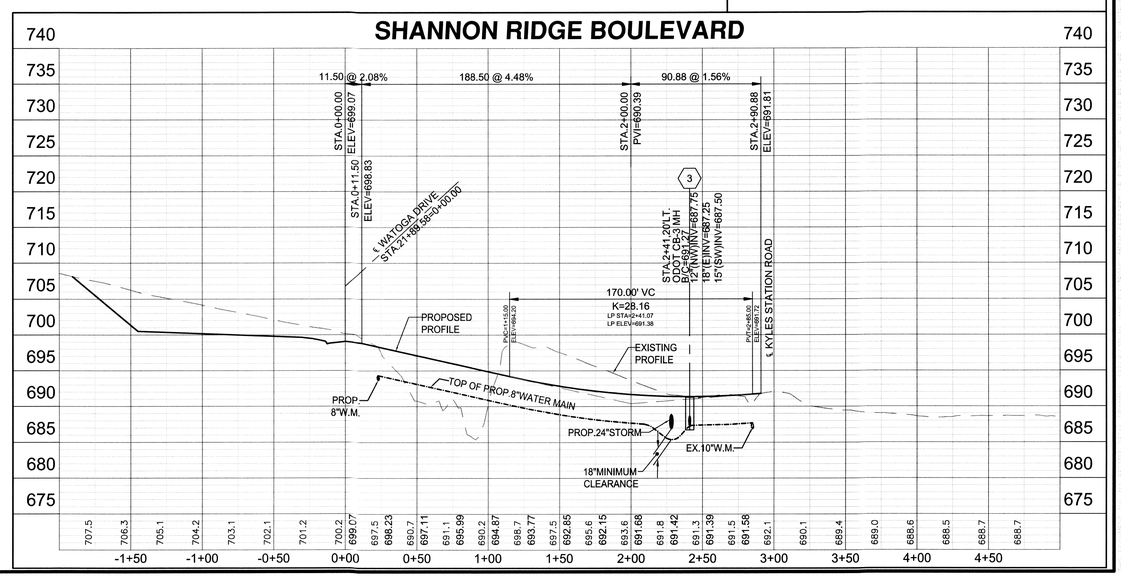

Basis of Bearing:
State Plane NAD83 (2011)
0 50 75
SCALE: 1" = 50'

Item	Date	Revision Description	Drwn.	Chk.
1	3-8-18	Revised as per BCEO	TAC	
2				
3				
4				
5				
6				
7				
8				
9				

SHANNON RIDGE
SECTION 33, TOWN 3, RANGE 3
LIBERTY TOWNSHIP
BUTLER COUNTY, OHIO
DETAILS, PLAN AND PROFILE

bayer becker
www.bayerbecker.com
6900 Tylersville Road, Suite A
Mason, OH 45040 - 513.336.6600

Drawing: 17-0120 CD2
Drawn by: TAC
Checked By: XXX
Issue Date: 1-24-18
Sheet: 2/15

Plot time: Feb 15, 2019 – 4:15pm
Drawing name: J:\2017\17-0120\CV\DWG\17-0120 CD2.dwg – Layout Tab: TYP2

OPEN SPACE

NOTES:

1. 48 hours notice to be given to affected residents before construction begins.
2. All Catch Basin B/C Elevations located within the curb are set to the Back of Curb Elevations.
3. Lower 3/4" Water Services as needed to avoid conflicts with Storm with Min. 4' Cover.
4. Location of existing utilities to be determined in the field prior to work beginning.
5. All lots Sump to Sump Drain unless otherwise noted in plan.
6. Sump Lines to be installed as per Standard Service Detail. Wyes or Tees are to be placed ten feet past lot line, on the low side of specified lots, and marked with Wye poles.
7. Contractors to accept all quantities as correct prior to beginning construction.
8. All abandoned utility poles on site are to be removed.

WATER MAIN RESTRAINT JOINT LOCATION CHART

Water Main Dia.	Horizontal 45°Bends	Vertical 45°Bends Up (Lower Water Under...)	Vertical 45°Bends Down (Lower Water Under...)	Dead Ends (Permanent & Temporary)	Tees (for Tee Branch) 6"	8"	10"
6"	18' both sides	18' both sides	36' both sides	72' Back	54'		
8"	18' both sides	36' both sides	36' both sides	90' Back	54'	72'	
10"	36' both sides	54' both sides	54' both sides	117' Back	54'	72'	90'
12"	36' both sides	54' both sides	72' both sides	180' Back	36'	72'	90'
14"	54' both sides	54' both sides	90' both sides	198' Back	36'	72'	90'
16"	54' both sides	54' both sides	90' both sides	216' Back	36'	54'	90'

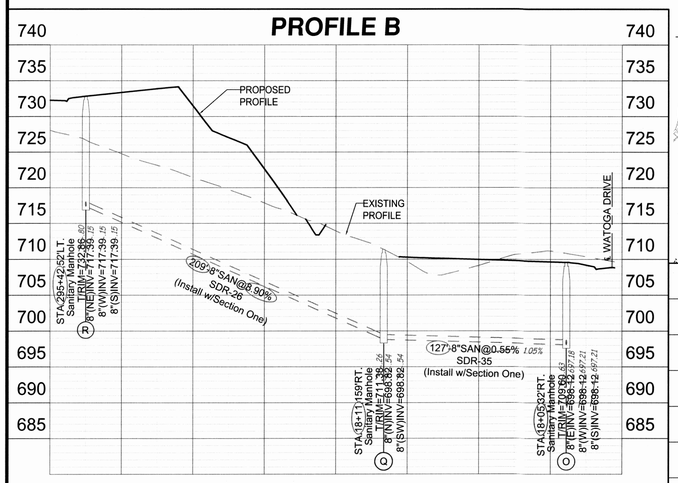

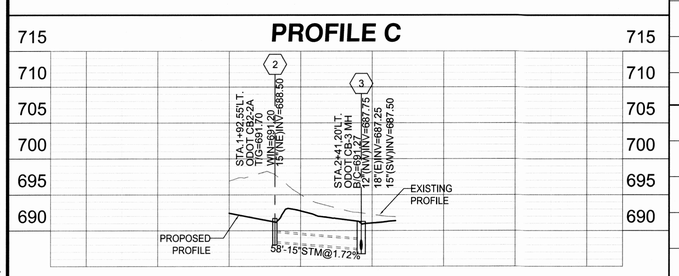

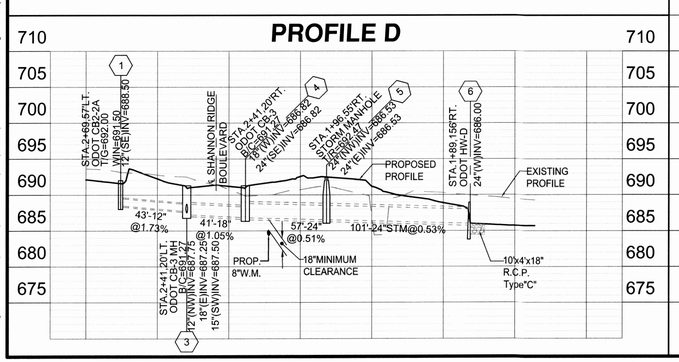

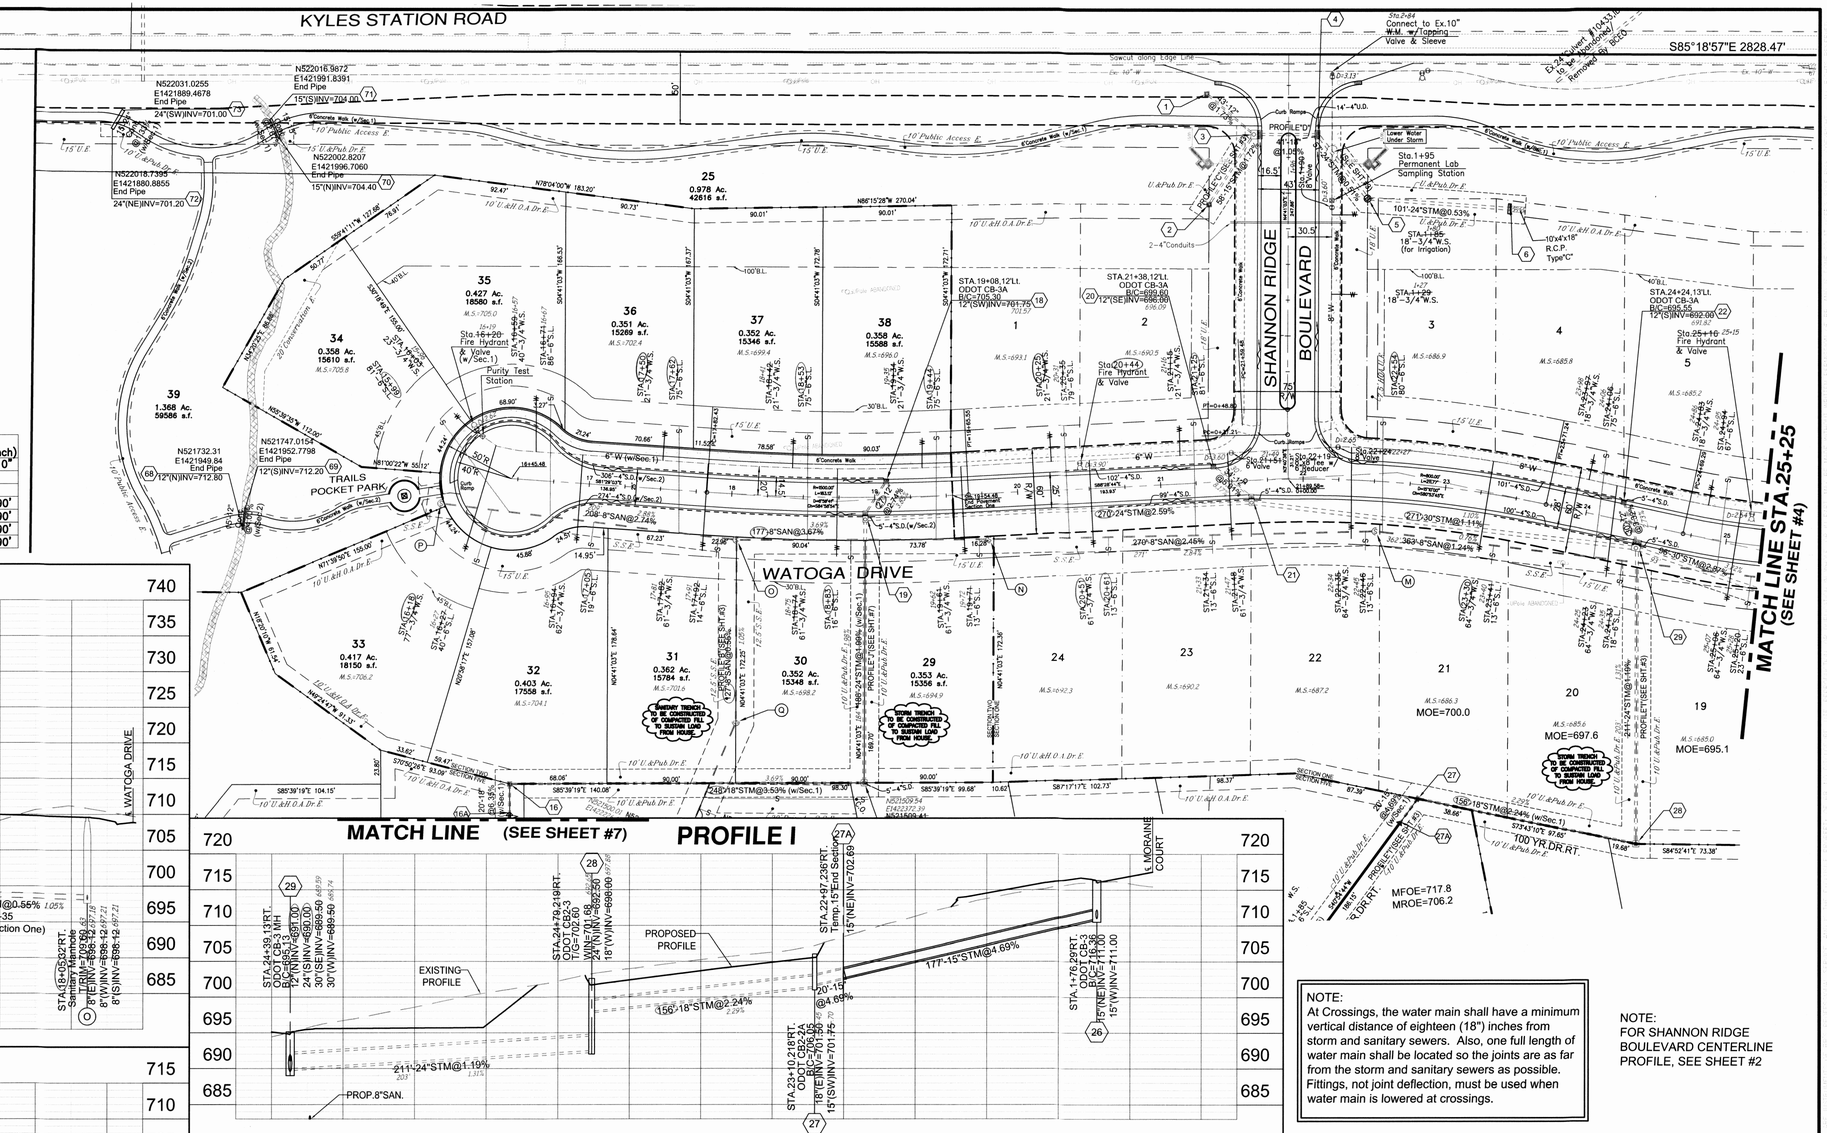

NOTE:
At Crossings, the water main shall have a minimum vertical distance of eighteen (18") inches from storm and sanitary sewers. Also, one full length of water main shall be located so the joints are as far from the storm and sanitary sewers as possible. Fittings, not joint deflection, must be used when water main is lowered at crossings.

NOTE:
FOR SHANNON RIDGE BOULEVARD CENTERLINE PROFILE, SEE SHEET #2

SHANNON RIDGE
SECTION 33, TOWN 3, RANGE 3
LIBERTY TOWNSHIP
BUTLER COUNTY, OHIO
PLAN AND PROFILE

Item	Revision Description	Date	Drwn.	Chk:
1	Revised as per BCWS	2-6-18	TAC	
2	Revised as per BCEO	3-8-18	TAC	
3	Revised as per In House Review	3-9-18	TAC	
4				
5				
6				
7				
8				
9				

bayer becker
www.bayerbecker.com
6900 Tylersville Road, Suite A
Mason, OH 45040 - 513.336.6600

Drawing: 17-0120 CD2
Drawn by: TAC
Checked By: XXX
Issue Date: 1-24-18
Sheet: 3/15

Plot time: Feb 19, 2019 - 12:11pm
Drawing name: J:\2017\17-0120\CV\DWG\17-0120 CD2.dwg - Layout Tab: PP3

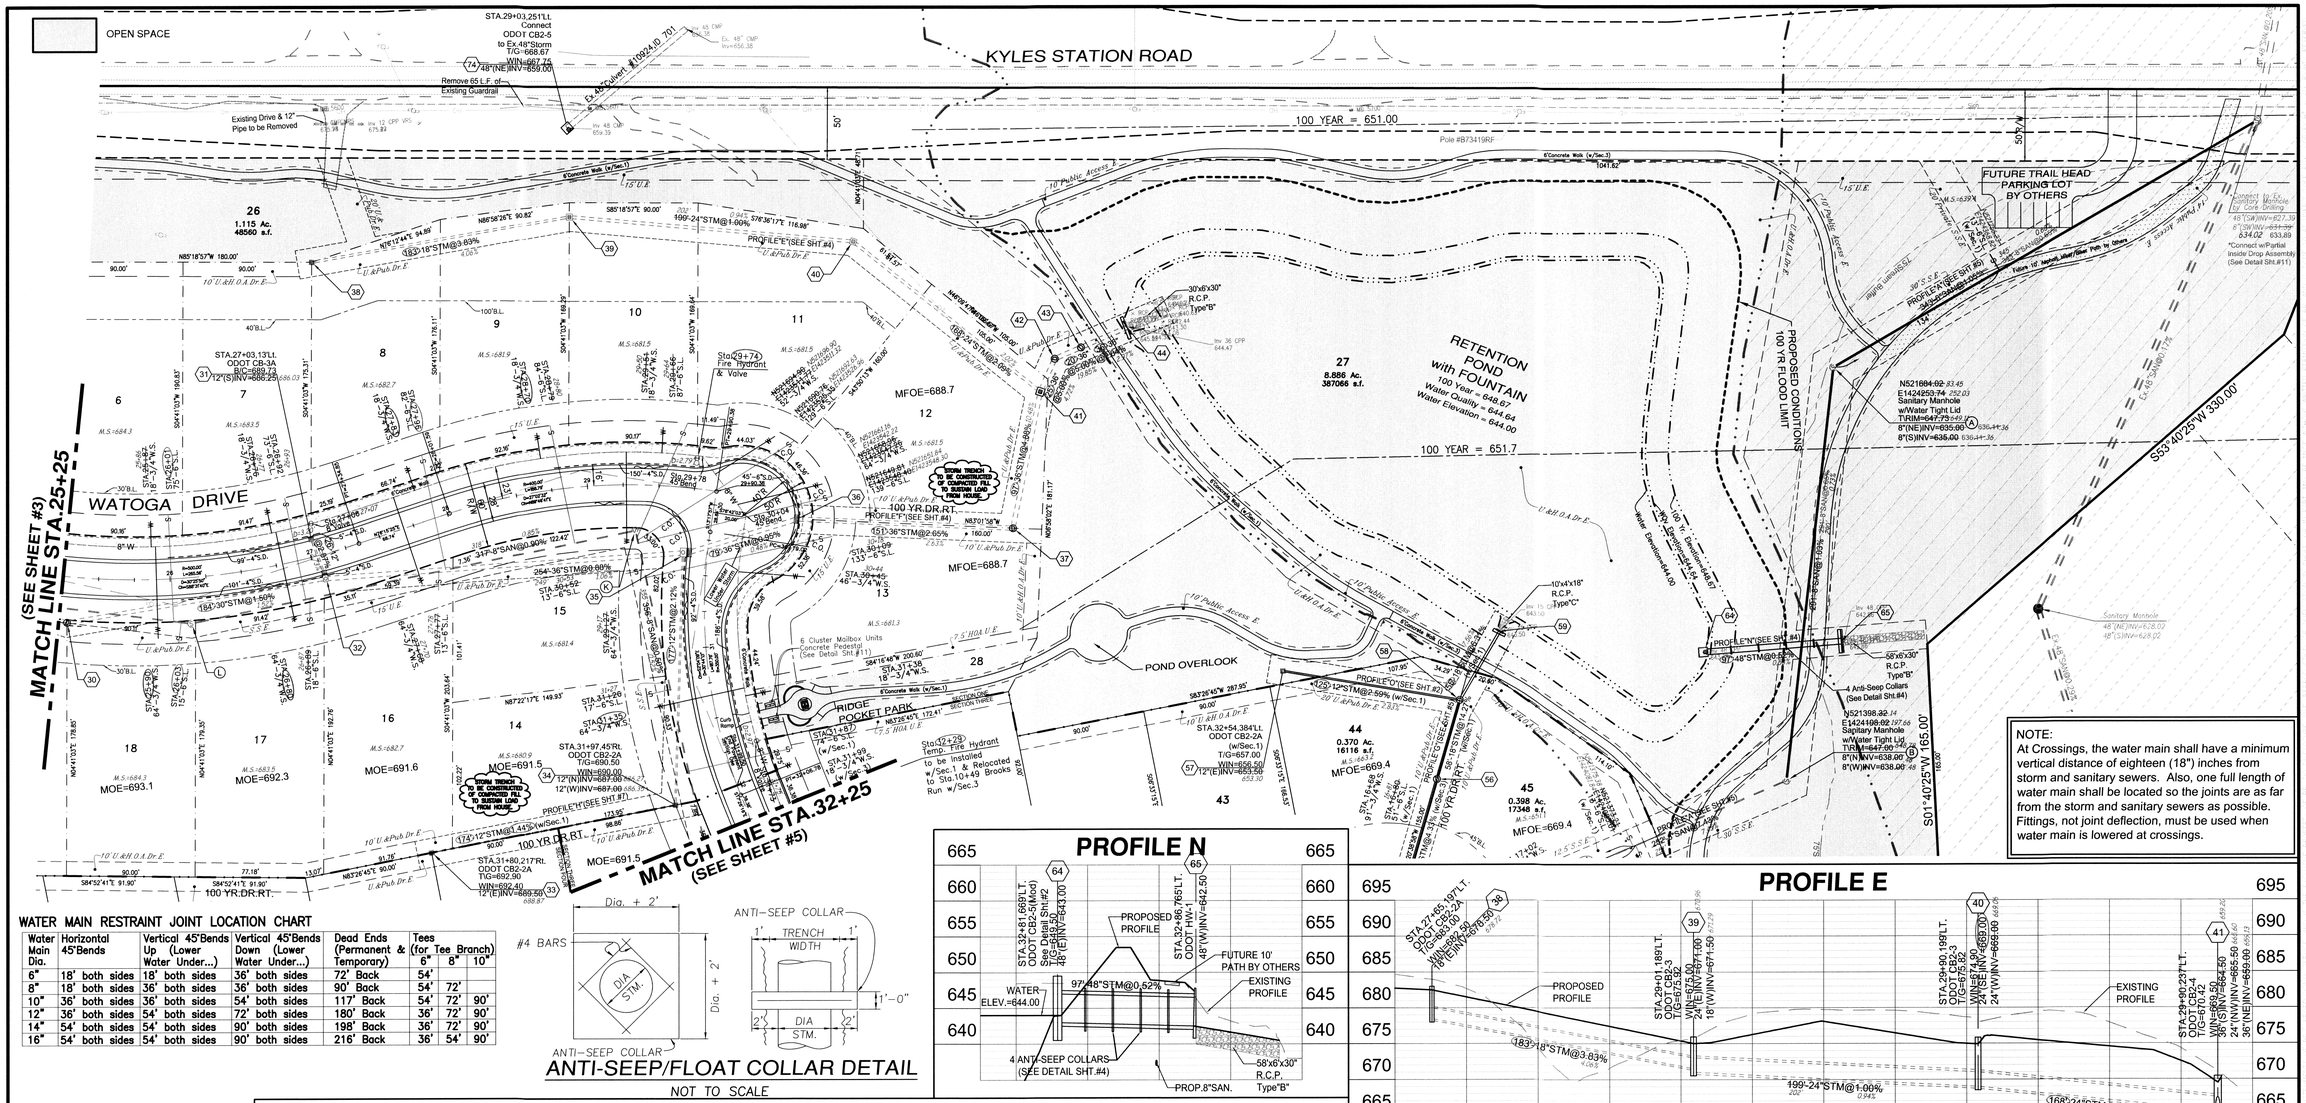

Basis of Bearing: State Plane NAD83 (2011)

0 50 75

SCALE: 1" = 50'

Item	Revision Description	Date	Drwn.	Chk.
1	Revised as per BOWS	2-6-18	TAC	
2	Revised as per BCEO	3-5-18	TAC	
3	Revised as per In House Review	3-9-18	TAC	
4	Revised as per EPA	3-19-18	TAC	
5				
6				
7				
8				
9				

WATER MAIN RESTRAINT JOINT LOCATION CHART

Water Main Dia.	Horizontal 45°Bends Up (Lower Water Under...)	Vertical 45°Bends Up (Lower Water Under...)	Vertical 45°Bends Down (Lower Water Under...)	Dead Ends (Permanent & Temporary)	Tees (for Tee Branch) 6"	8"	10"
6"	18' both sides	18' both sides	36' both sides	72' Back	54'		
8"	18' both sides	36' both sides	90' Back	54'	72'		
10"	36' both sides	36' both sides	54' both sides	117' Back	54'	72'	90'
12"	36' both sides	54' both sides	72' both sides	180' Back	36'	72'	90'
14"	54' both sides	54' both sides	90' both sides	198' Back	36'	72'	90'
16"	54' both sides	54' both sides	90' both sides	216' Back	36'	54'	90'

ANTI-SEEP/FLOAT COLLAR DETAIL

NOT TO SCALE

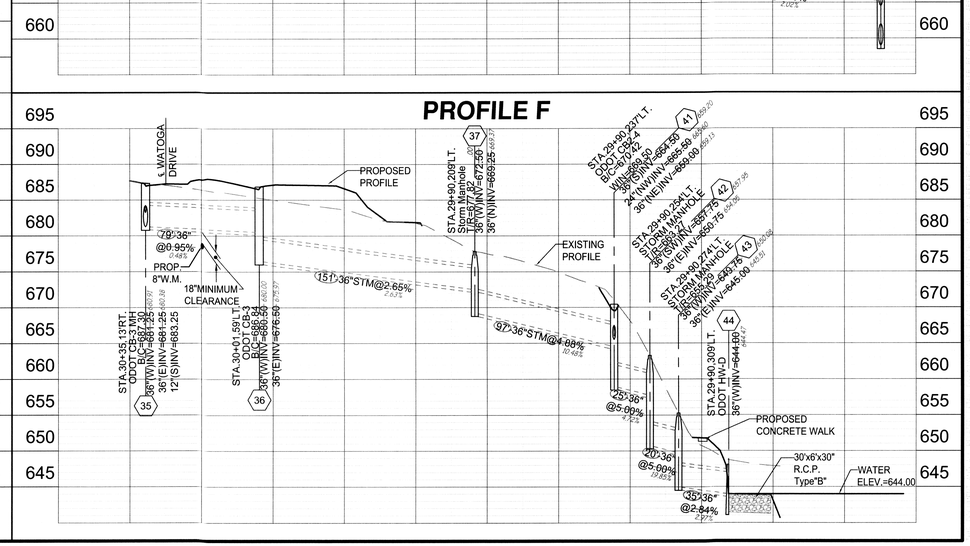

NOTES:

1. 48 hours notice to be given to affected residents before construction begins.
2. All Catch Basin B/C Elevations located within the curb are set to the Back of Curb Elevations.
3. Lower 3/4" Water Services as needed to avoid conflicts with Storm with Min. 4' Cover.
4. Location of existing utilities to be determined in the field prior to work beginning.
5. All lots Sump to Sump Drain unless otherwise noted in plan.
6. Sump Lines to be installed as per Standard Service Detail. Wyes or Tees are to be placed ten feet past lot line, on the low side of specified lots, and marked with Wye poles.
7. Contractors to accept all quantities as correct prior to beginning construction.
8. All abandoned utility poles on site are to be removed.

SHANNON RIDGE
SECTION 33, TOWN 3, RANGE 3
LIBERTY TOWNSHIP
BUTLER COUNTY, OHIO
PLAN AND PROFILE

bayer becker
www.bayerbecker.com
6900 Tylersville Road, Suite A
Mason, OH 45040 - 513.336.6600

Drawing:	17-0120 CD2
Drawn by:	TAC
Checked By:	XXX
Issue Date:	1-24-18
Sheet:	4/15

Plot time: Feb 19, 2019 - 12:18pm
Drawing name: J:\2017\17-0120\CV\DWG\17-0120 CD2.dwg - Layout Tab: PP4

NOTES:

1. 48 hours notice to be given to affected residents before construction begins.
2. All Catch Basin B/C Elevations located within the curb are set to the Back of Curb Elevations.
3. Lower 3/4" Water Services as needed to avoid conflicts with Storm with Min. 4' Cover.
4. Location of existing utilities to be determined in the field prior to work beginning.
5. All lots Sump to Sump Drain unless otherwise noted in plan.
6. Sump Lines to be installed as per Standard Service Detail. Wyes or Tees are to be placed ten feet past lot line, on the low side of specified lots, and marked with Wye poles.
7. Contractors to accept all quantities as correct prior to beginning construction.

WATER MAIN RESTRAINT JOINT LOCATION CHART

Water Main Dia.	Horizontal 45°Bends	Vertical 45°Bends Up (Lower Water Under...)	Vertical 45°Bends Down (Lower Water Under...)	Dead Ends (Permanent & Temporary)	Tees (for Tee Branch) 6"	8"	10"
6"	18' both sides	18' both sides	36' both sides	72' Back	54'		
8"	18' both sides	36' both sides	36' both sides	90' Back	54'	72'	
10"	36' both sides	36' both sides	54' both sides	117' Back	54'	72'	90'
12"	36' both sides	54' both sides	72' both sides	180' Back	36'	72'	90'
14"	54' both sides	54' both sides	90' both sides	198' Back	36'	72'	90'
16"	54' both sides	54' both sides	90' both sides	216' Back	36'	54'	90'

NOTE:
At Crossings, the water main shall have a minimum vertical distance of eighteen (18") inches from storm and sanitary sewers. Also, one full length of water main shall be located so the joints are as far from the storm and sanitary sewers as possible. Fittings, not joint deflection, must be used when water main is lowered at crossings.

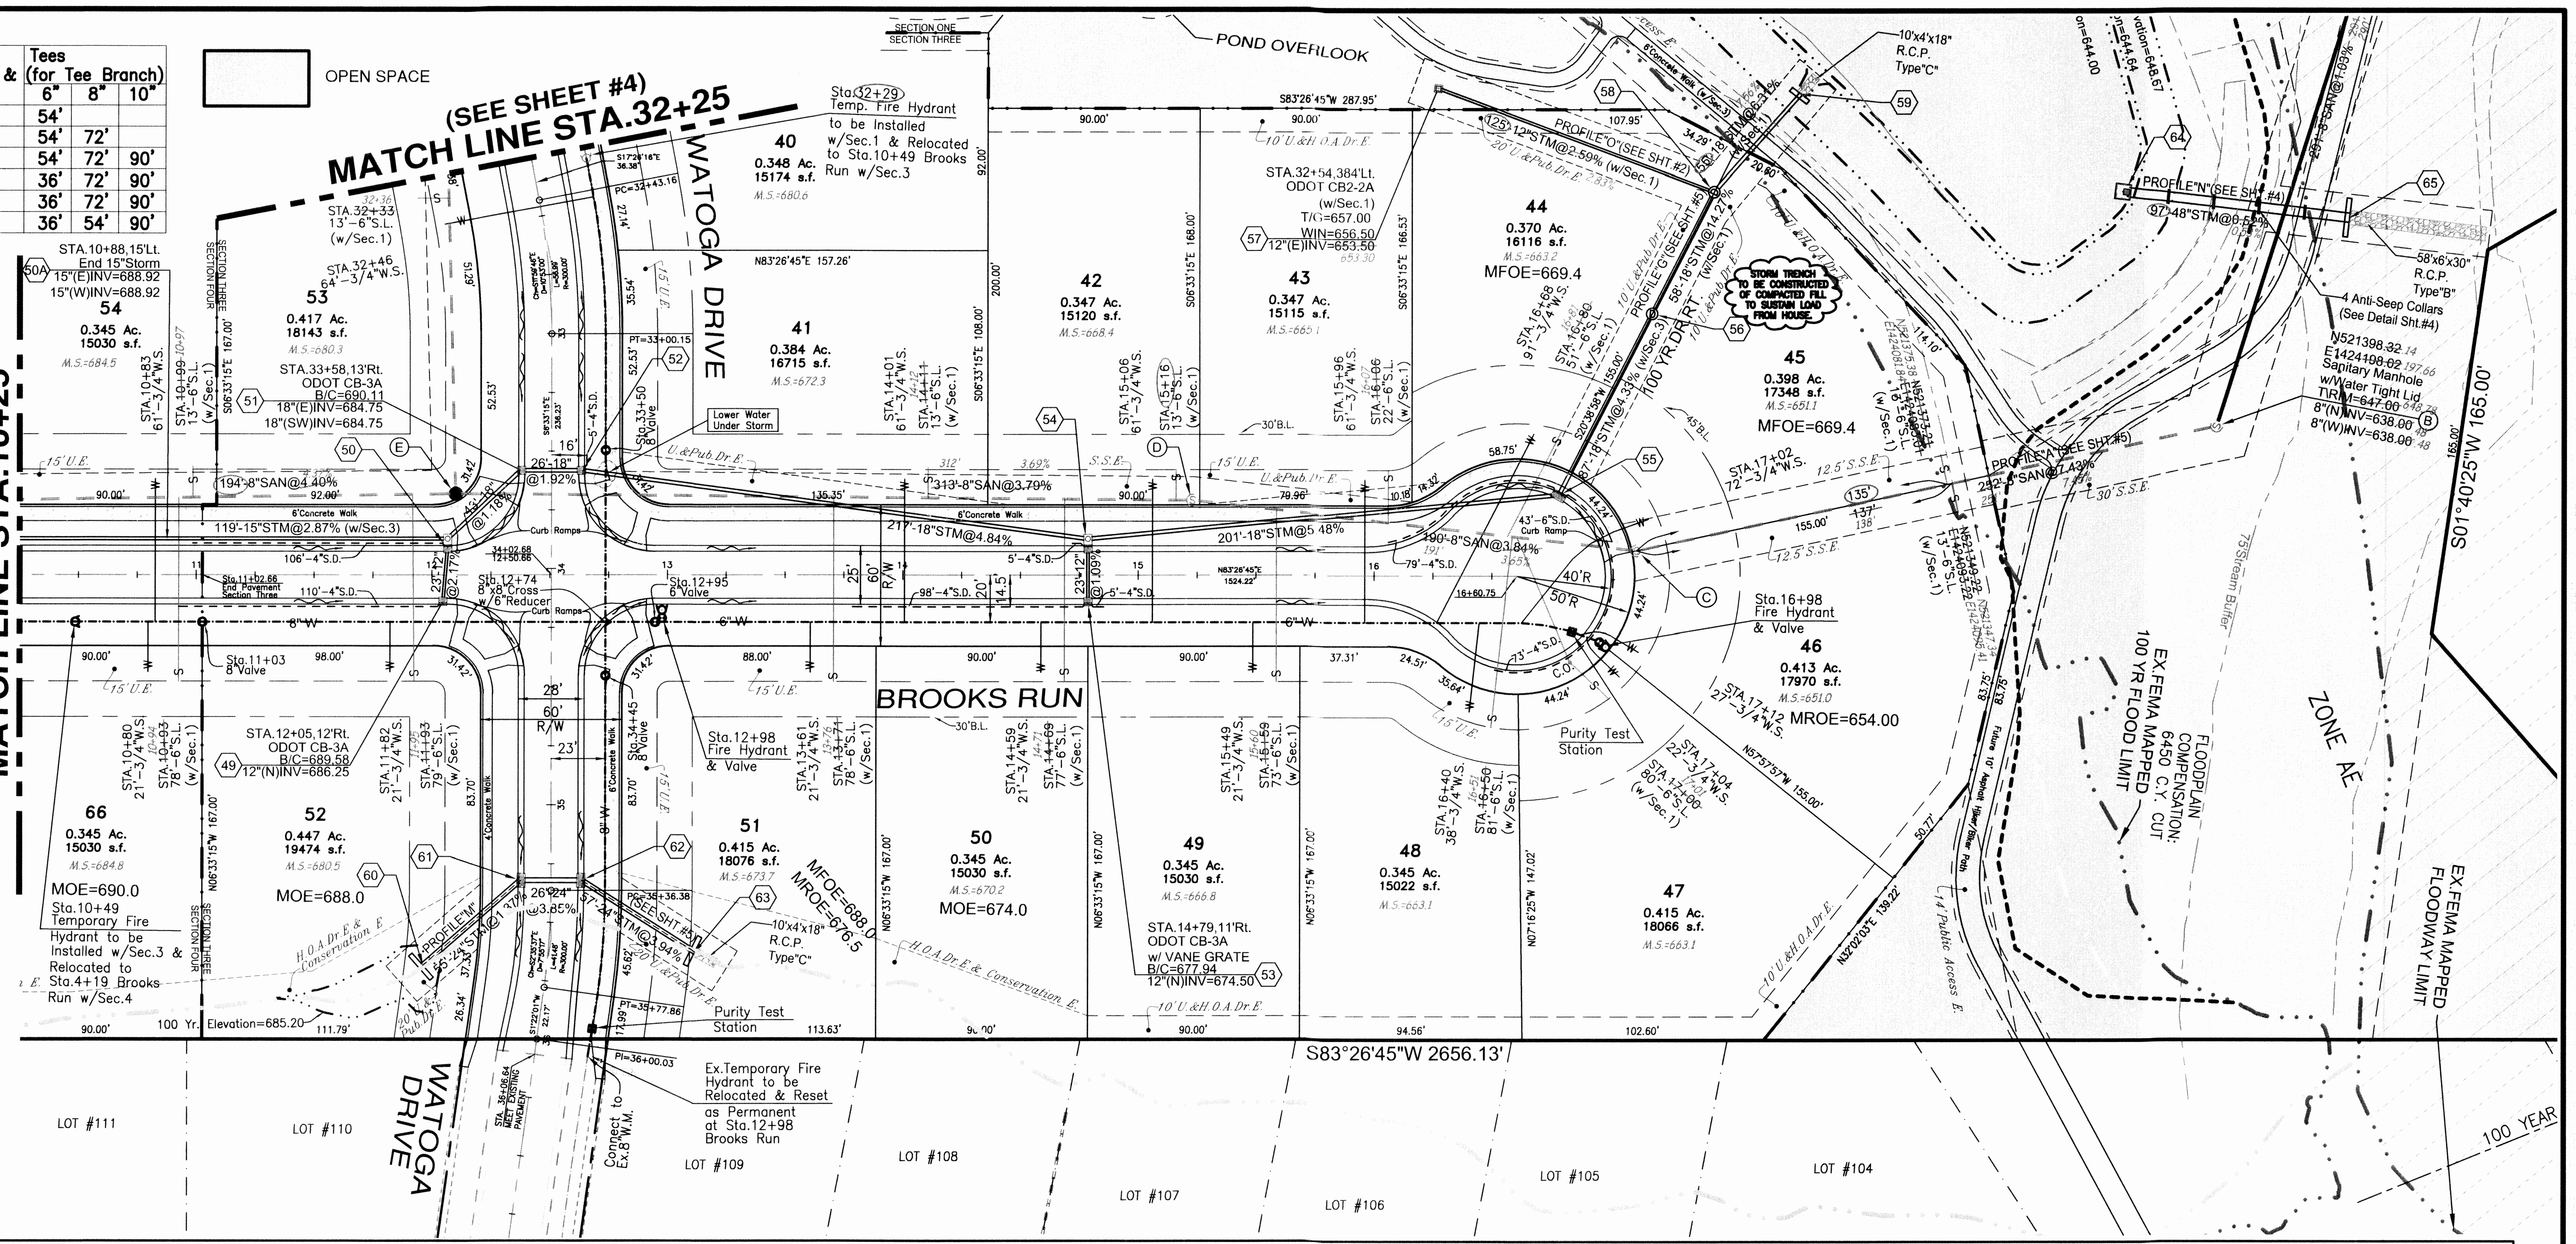

PROFILE G

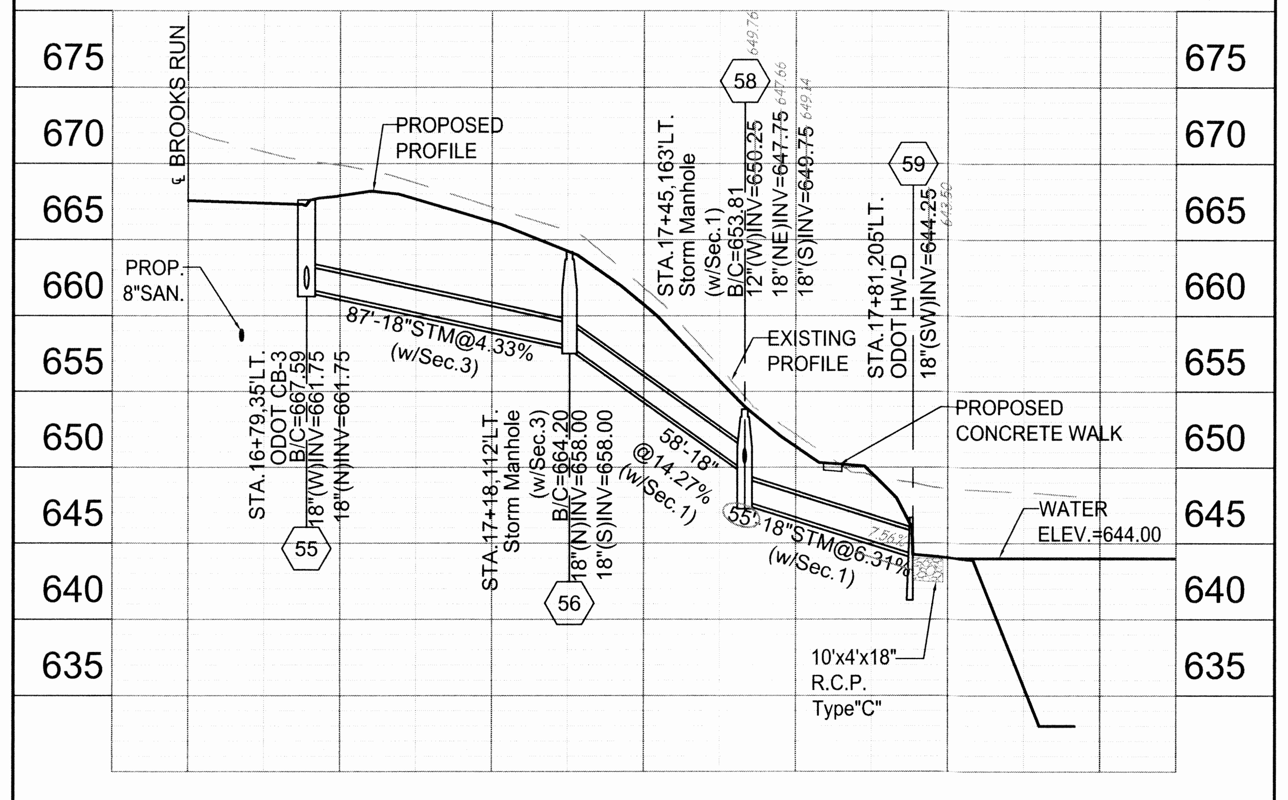

PROFILE M

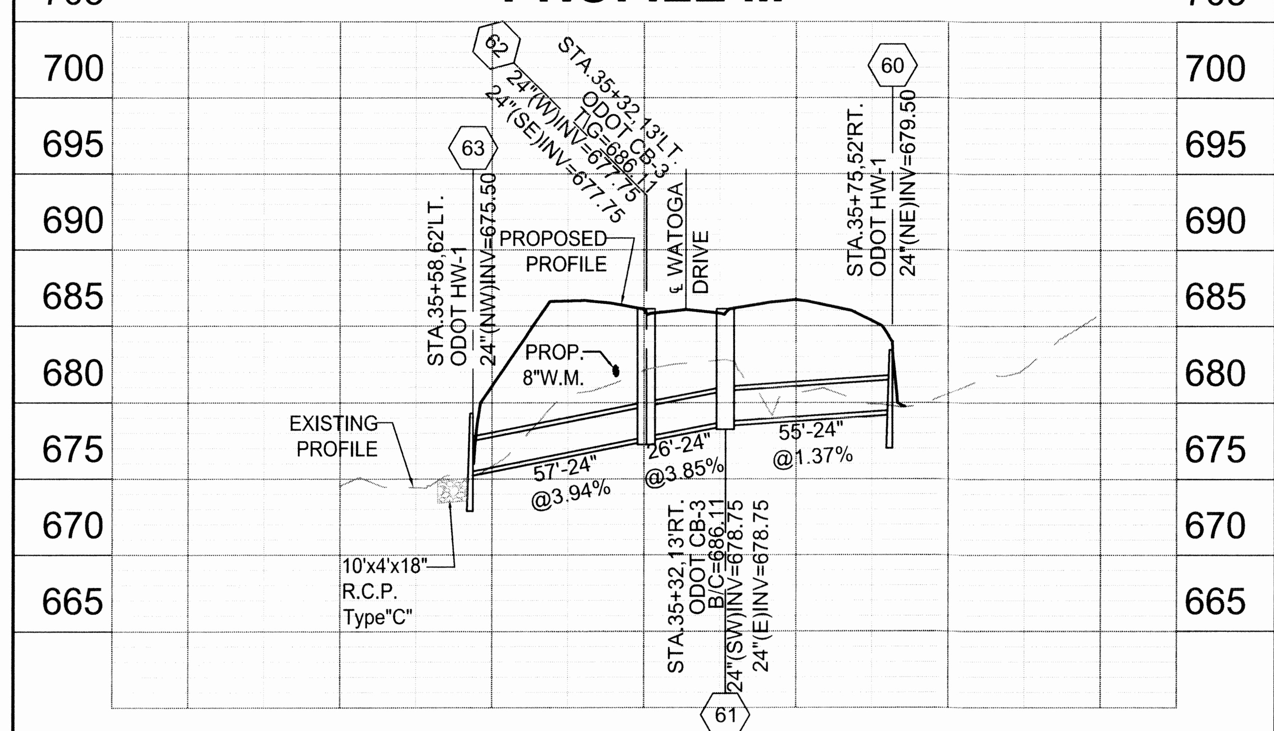

PROFILE A

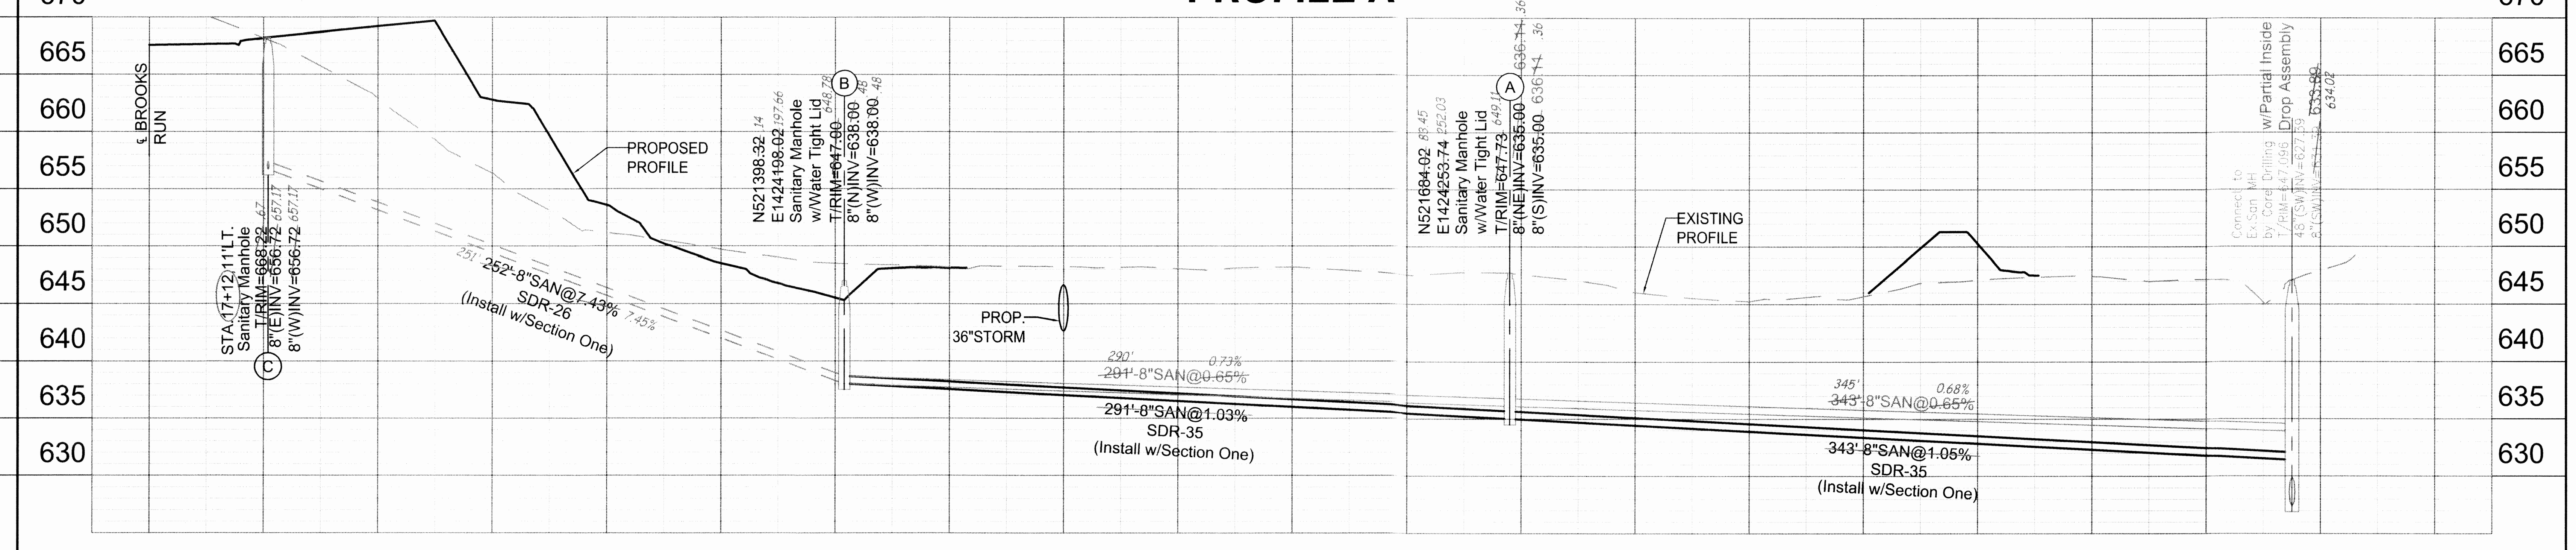

WATOGA DRIVE

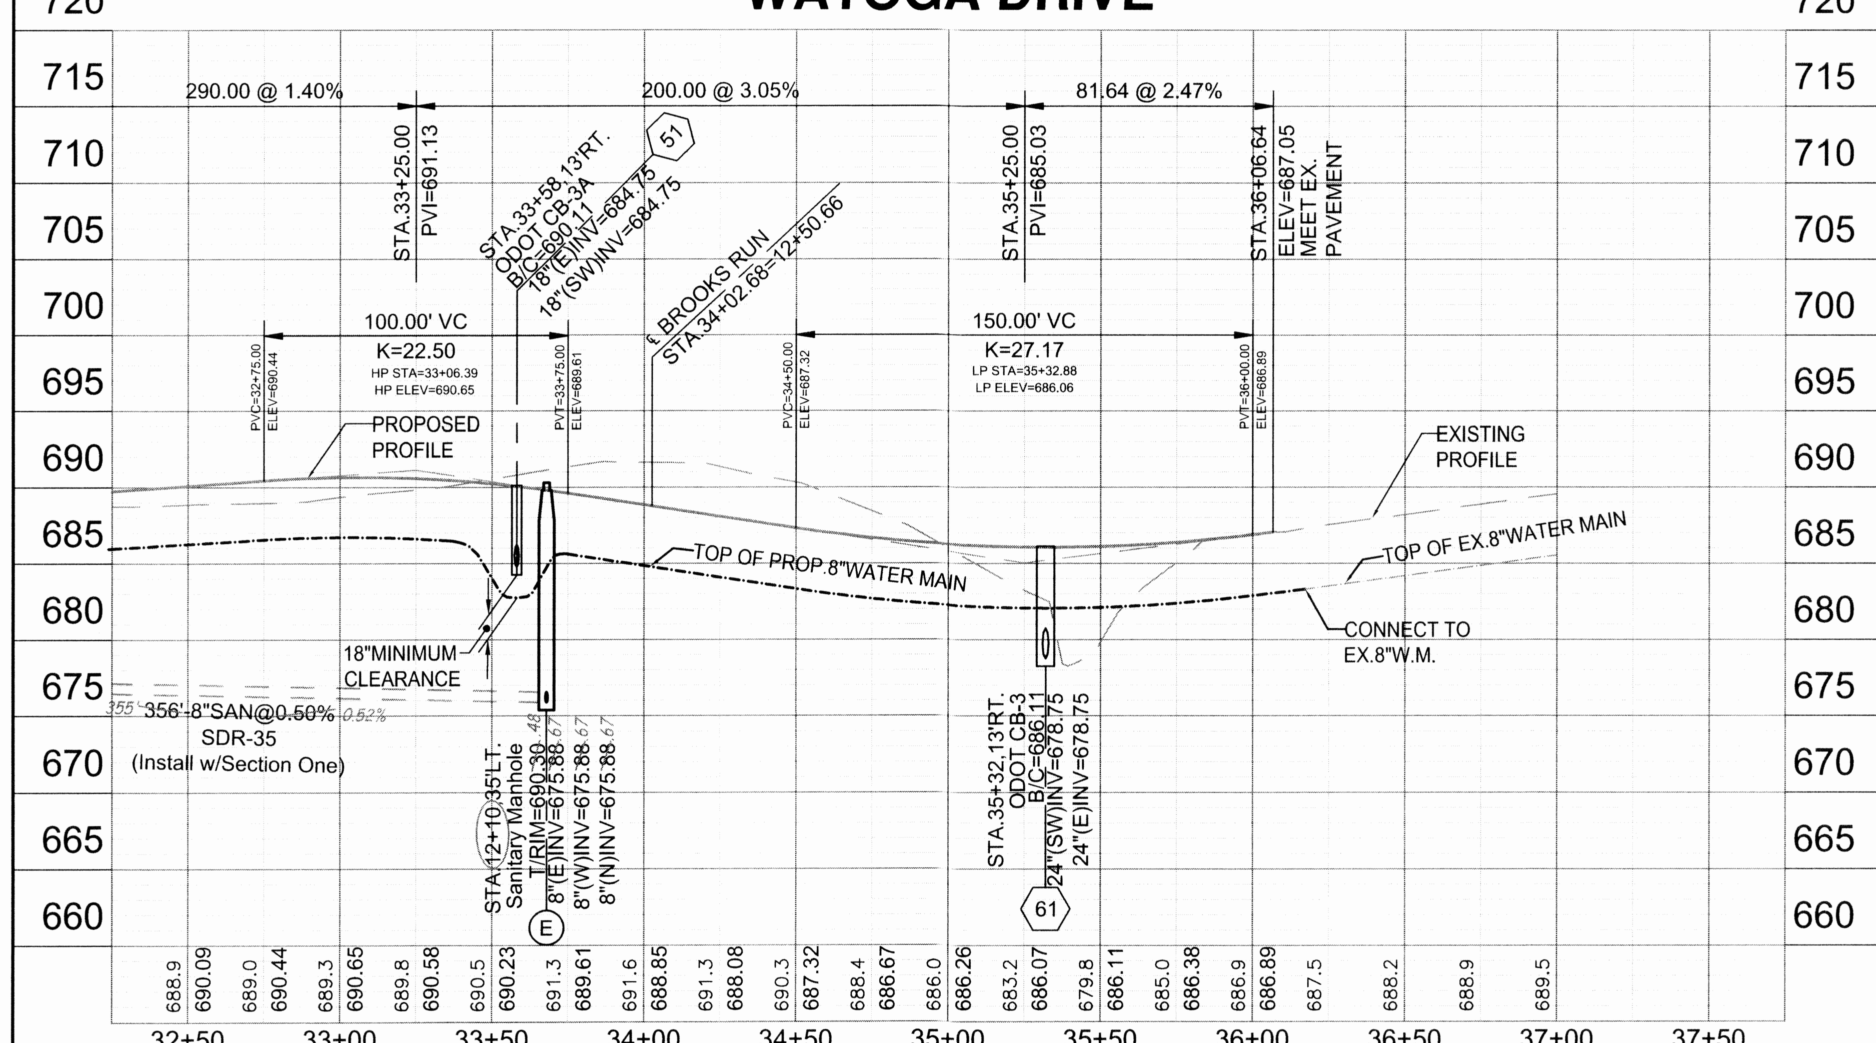

BROOKS RUN

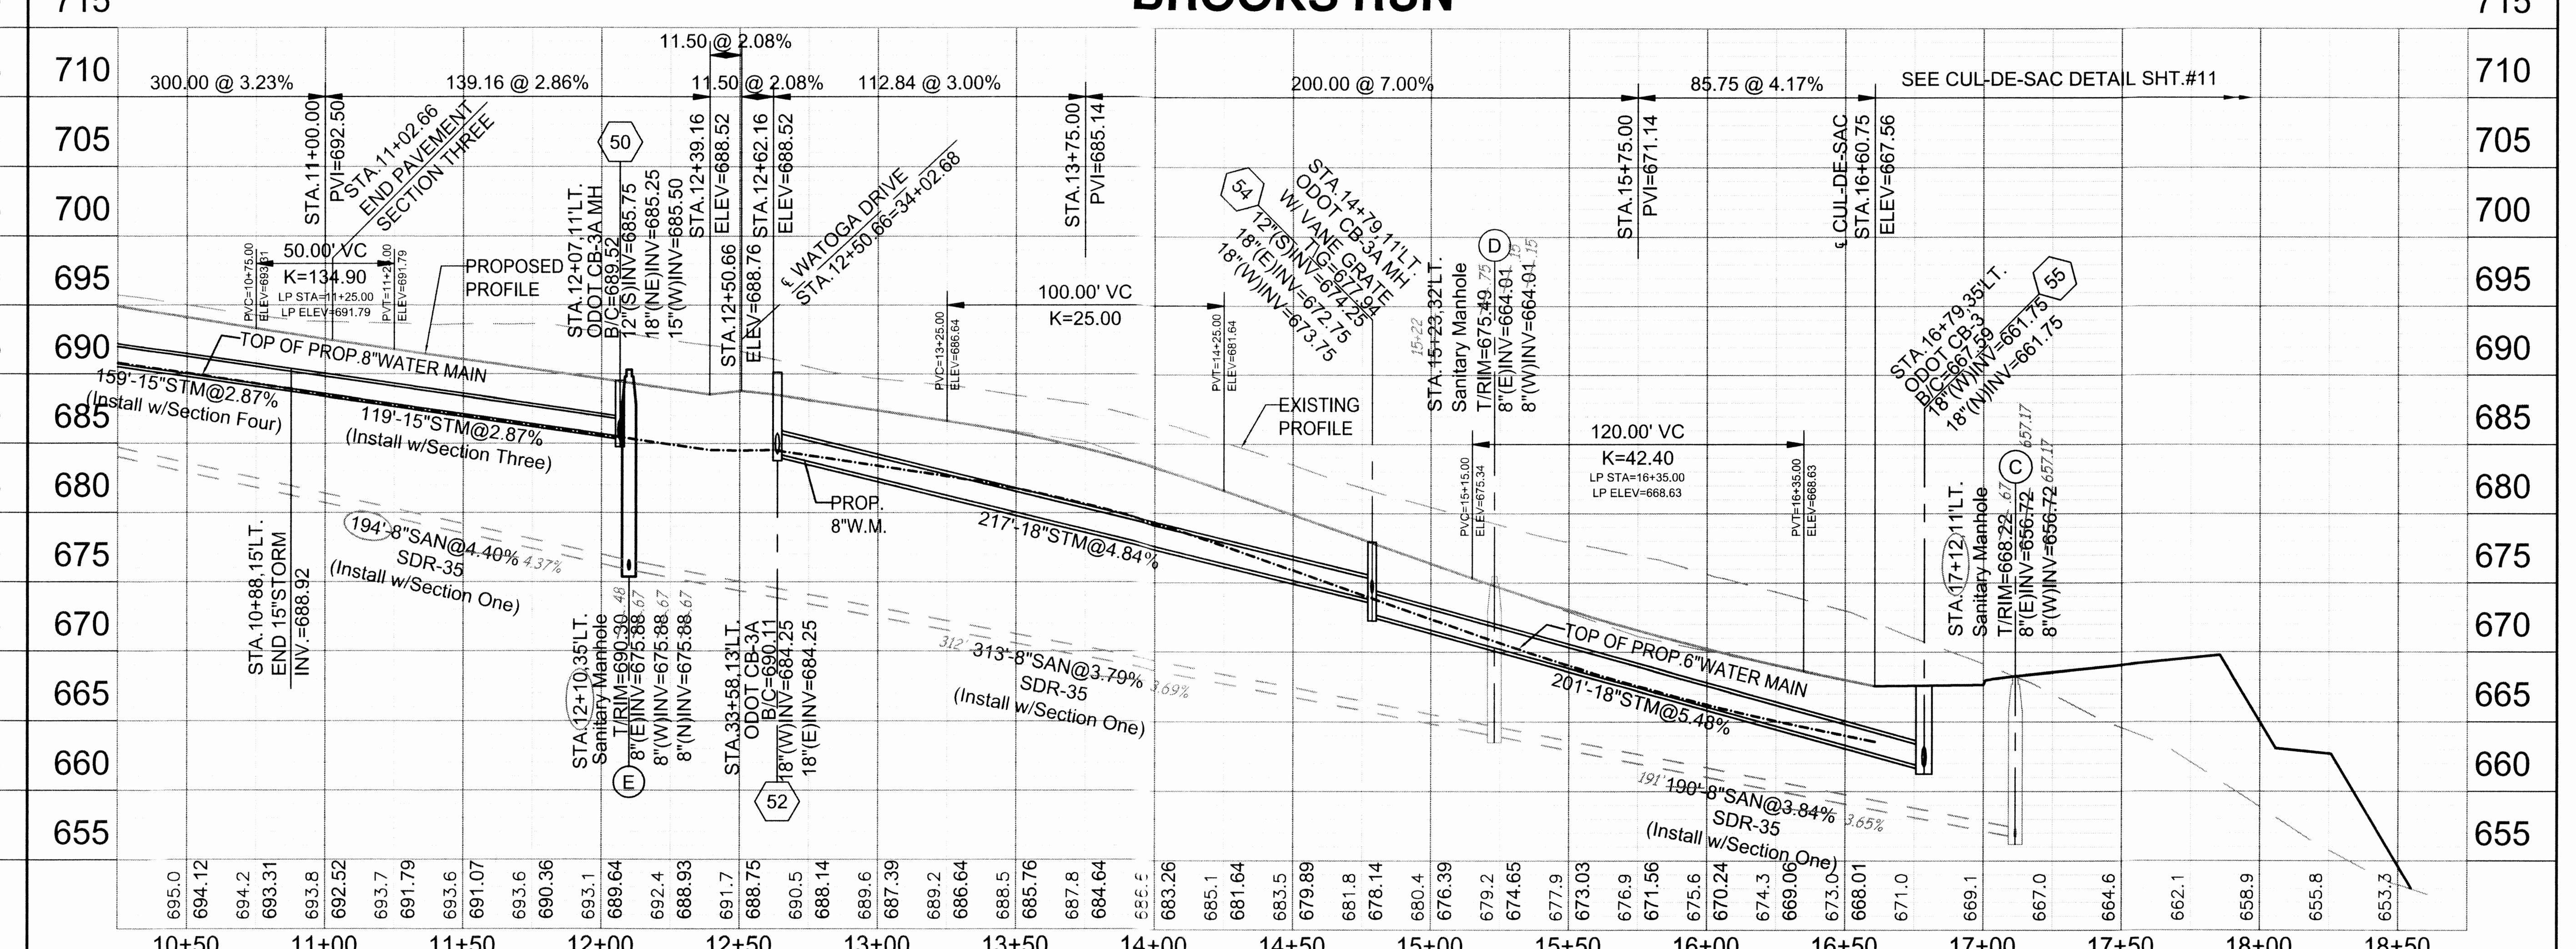

Basis of Bearing: State Plane NAD83 (2011)
SCALE: 1" = 50'

Item	Revision Description	Date	Drwn:	Chk:
1	Revised as per BCWS	2-6-18	TAC	
2	Revised as per BCEO	3-8-18	TAC	
3	Revised as per In House Review	3-9-18	TAC	
4	Revised as per EPA	3-18-18	TAC	
5				
6				
7				
8				
9				

SHANNON RIDGE

SECTION 33, TOWN 3, RANGE 3
LIBERTY TOWNSHIP
BUTLER COUNTY, OHIO

PLAN AND PROFILE

bayer becker
www.bayerbecker.com
6900 Tylersville Road, Suite A
Mason, OH 45040 - 513.336.6600

Drawing: 17-0120 CD2
Drawn by: TAC
Checked By: XXX
Issue Date: 1-24-18
Sheet: 5/15

Plot time: Feb 19, 2019 – 12:25pm
Drawing name: J:\2017\17-0120\CV\DWG\17-0120 CD2.dwg – Layout Tab: PP5

NOTES:

1. 48 hours notice to be given to affected residents before construction begins.
2. All Catch Basin B/C Elevations located within the curb are set to the Back of Curb Elevations.
3. Lower 3/4" Water Services as needed to avoid conflicts with Storm with Min. 4' Cover.
4. Location of existing utilities to be determined in the field prior to work beginning.
5. All lots Sump to Sump Drain unless otherwise noted in plan.
6. Sump Lines to be installed as per Standard Service Detail. Wyes or Tees are to be placed ten feet past lot line, on the low side of specified lots, and marked with Wye poles.
7. Contractors to accept all quantities as correct prior to beginning construction.

NOTE:
At Crossings, the water main shall have a minimum vertical distance of eighteen (18") inches from storm and sanitary sewers. Also, one full length of water main shall be located so the joints are as far from the storm and sanitary sewers as possible. Fittings, not joint deflection, must be used when water main is lowered at crossings.

WATER MAIN RESTRAINT JOINT LOCATION CHART

Water Main Dia.	Horizontal 45°Bends	Vertical 45°Bends Up (Lower Water Under...)	Vertical 45°Bends Down (Lower Water Under...)	Dead Ends (Permanent & Temporary)	Tees (for Tee Branch) 6"	8"	10"
6"	18' both sides	18' both sides	36' both sides	72' Back	54'		
8"	18' both sides	36' both sides	36' both sides	90' Back	54'	72'	
10"	36' both sides	36' both sides	54' both sides	117' Back	54'	72'	90'
12"	36' both sides	54' both sides	72' both sides	180' Back	36'	72'	90'
14"	54' both sides	54' both sides	90' both sides	198' Back	36'	72'	90'
16"	54' both sides	54' both sides	90' both sides	216' Back	36'	54'	90'

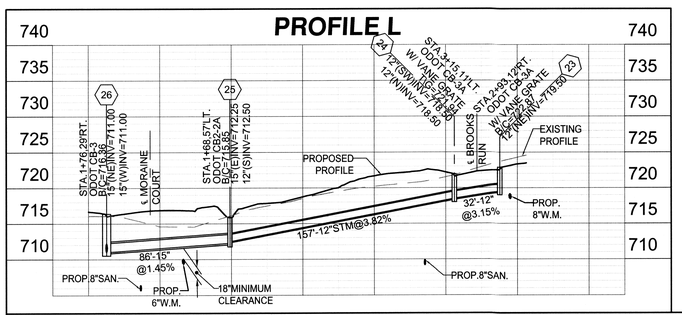

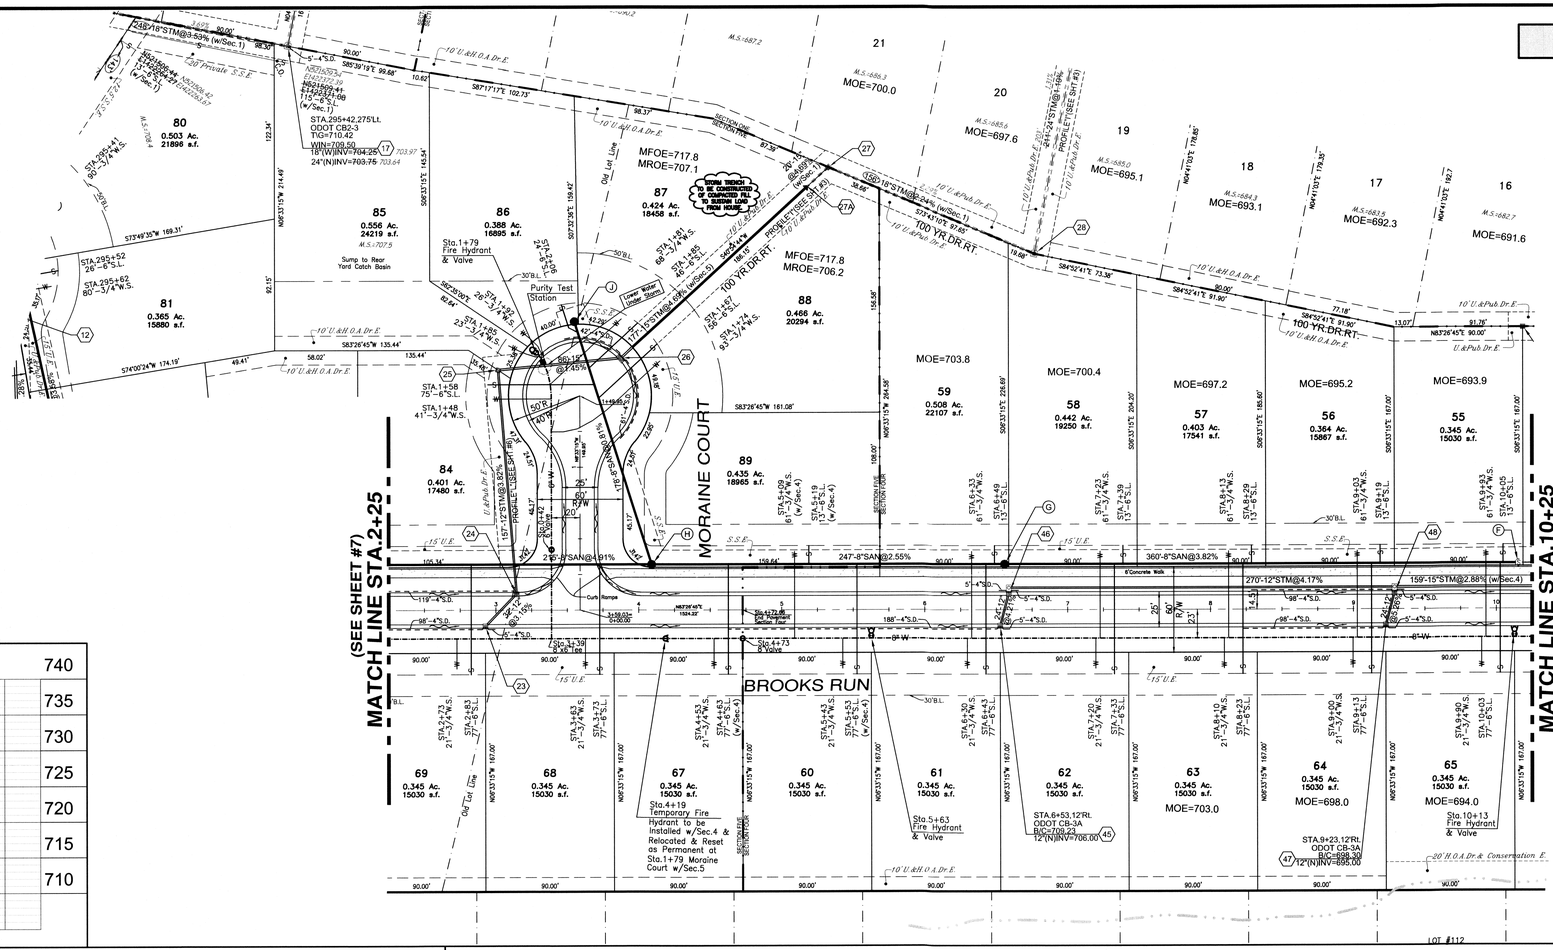

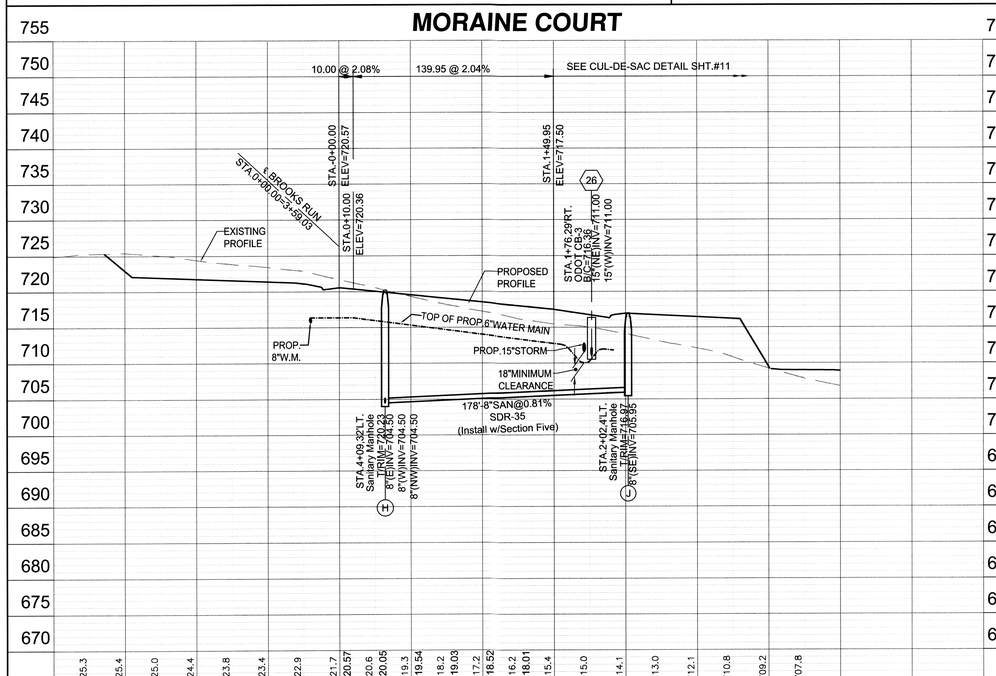

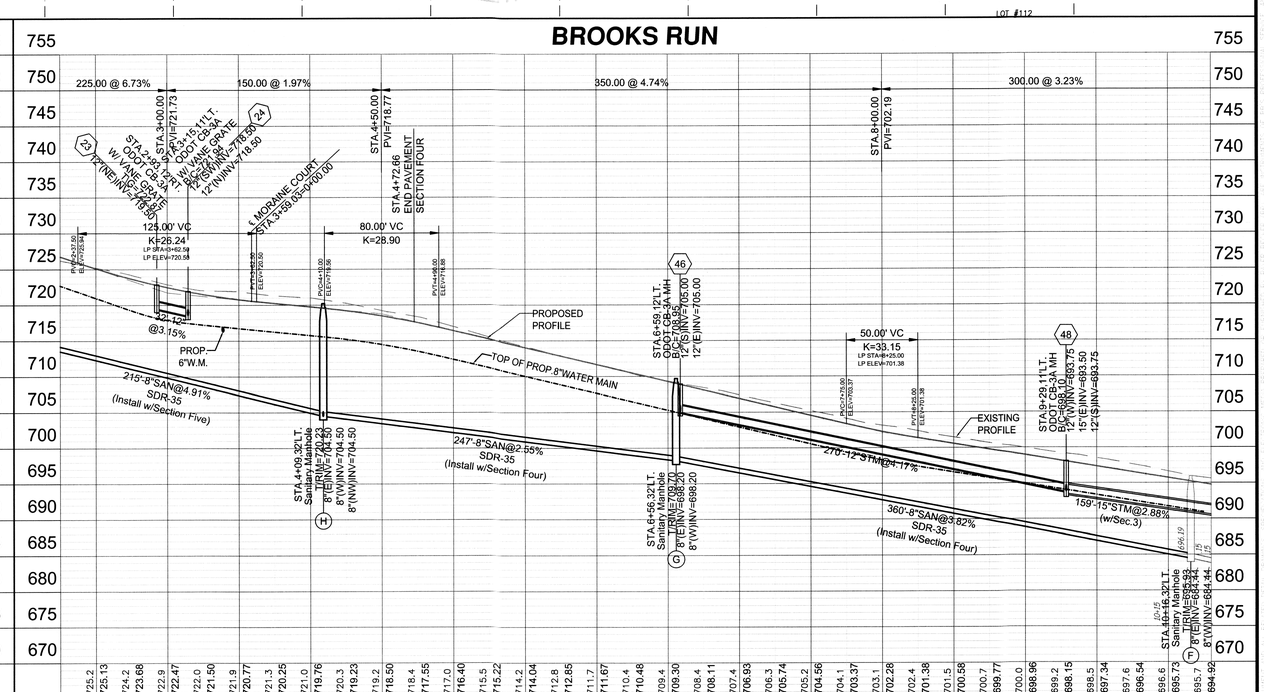

Basis of Bearing: State Plane NAD83 (2011)
0 50 75
SCALE: 1" = 50'

Item	Revision Description	Date	Drwn:	Chk:
1	Revised as per BCWS	2-6-18	TAC	
2	Revised as per In House Review	3-9-18	TAC	
3				
4				
5				
6				
7				
8				
9				

SHANNON RIDGE

SECTION 33, TOWN 3, RANGE 3
LIBERTY TOWNSHIP
BUTLER COUNTY, OHIO

PLAN AND PROFILE

bayer becker
www.bayerbecker.com
6900 Tylersville Road, Suite A
Mason, OH 45040 - 513.336.6600

Drawing: 17-0120 CD2
Drawn by: TAC
Checked By: XXX
Issue Date: 1-24-18
Sheet: 6/15

Plot time: Feb 19, 2019 - 12:31pm
Drawing name: J:\2017\17-0120\CV\DWG\17-0120 CD2.dwg - Layout Tab: PP6

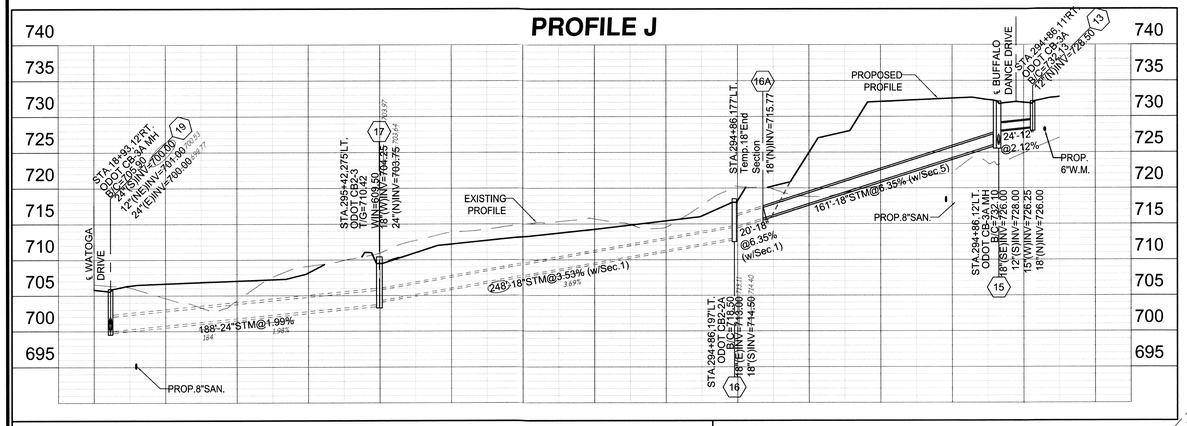

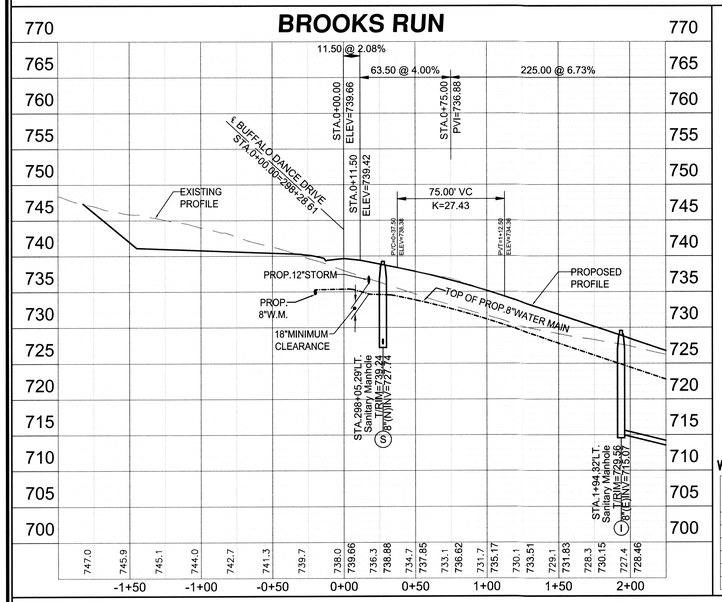

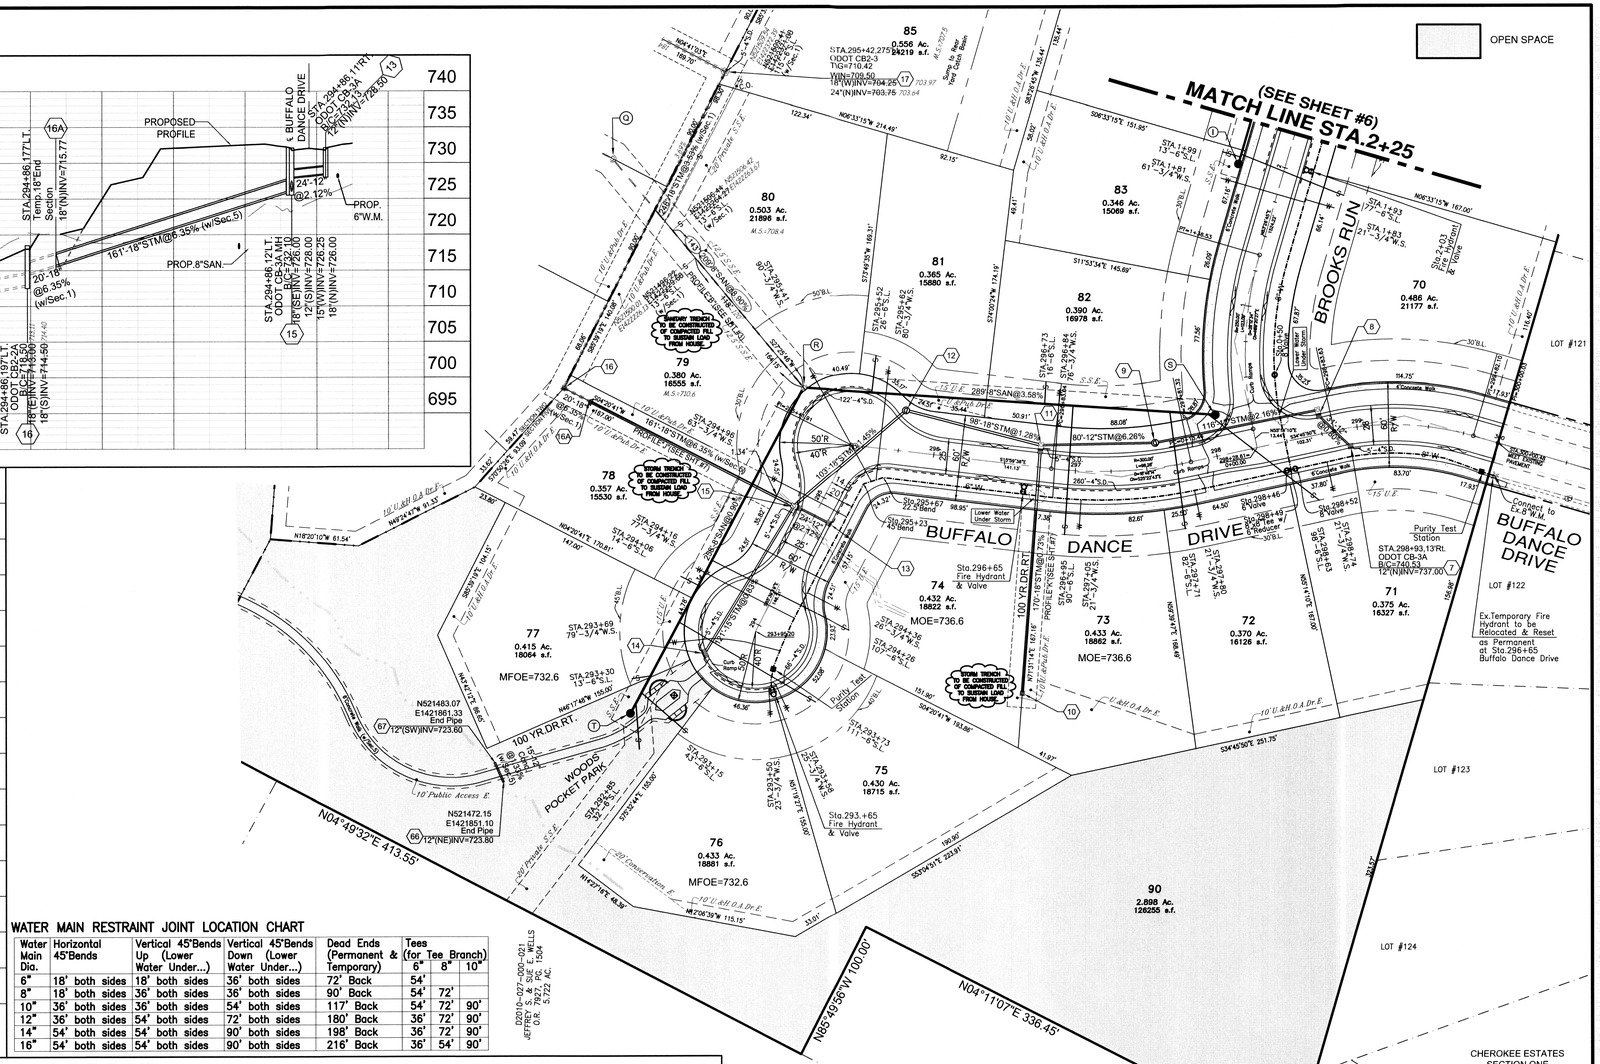

WATER MAIN RESTRAINT JOINT LOCATION CHART

Water Main Dia.	Horizontal 45°Bends	Vertical 45°Bends Up (Lower Water Under...)	Vertical 45°Bends Down (Lower Water Under...)	Dead Ends (Permanent & Temporary)	Tees (for Tee Branch) 6"	8"	10"
6"	18' both sides	18' both sides	36' both sides	72' Back	54'		
8"	18' both sides	36' both sides	36' both sides	90' Back	54'	72'	
10"	36' both sides	36' both sides	54' both sides	117' Back	54'	72'	90'
12"	36' both sides	54' both sides	72' both sides	180' Back	36'	72'	90'
14"	54' both sides	54' both sides	90' both sides	198' Back	36'	72'	90'
16"	54' both sides	54' both sides	90' both sides	216' Back	36'	54'	90'

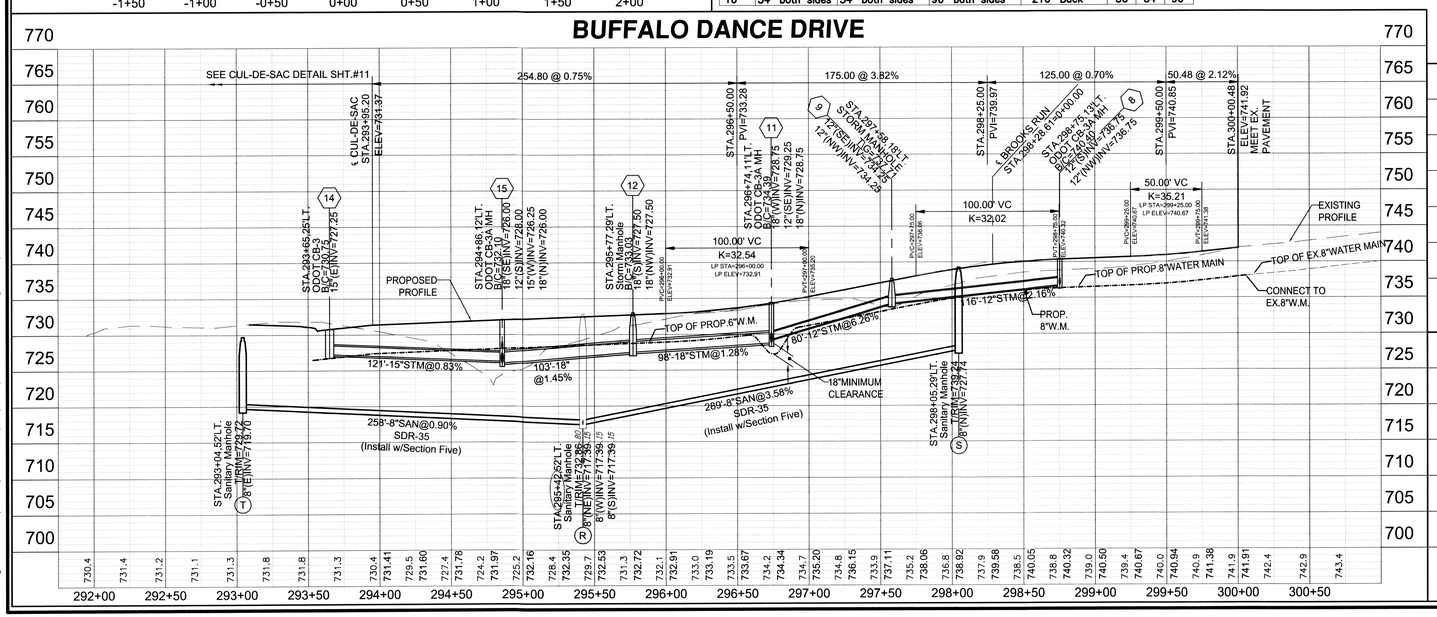

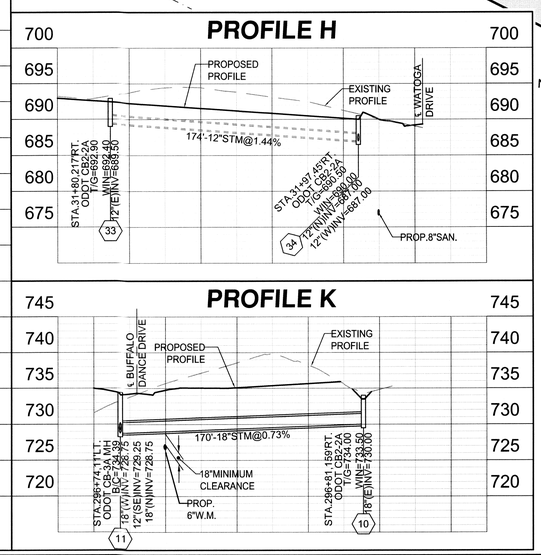

NOTES:

1. 48 hours notice to be given to affected residents before construction begins.
2. All Catch Basin B/C Elevations located within the curb are set to the Back of Curb Elevations.
3. Lower 3/4" Water Services as needed to avoid conflicts with Storm with Min. 4' Cover.
4. Location of existing utilities to be determined in the field prior to work beginning.
5. All lots Sump to Sump Drain unless otherwise noted in plan.
6. Sump Lines to be installed as per Standard Service Detail. Wyes or Tees are to be placed ten feet past lot line, on the low side of specified lots, and marked with Wye poles.
7. Contractors to accept all quantities as correct prior to beginning construction.

NOTE:
At Crossings, the water main shall have a minimum vertical distance of eighteen (18") inches from storm and sanitary sewers. Also, one full length of water main shall be located so the joints are as far from the storm and sanitary sewers as possible. Fittings, not joint deflection, must be used when water main is lowered at crossings.

Basis of Bearing: State Plane NAD83 (2011)
0 50 75
SCALE: 1" = 50'

Item	Revision Description	Date	Drwn.	Chk.
1	Revised as per BCWS	2-6-18	TAC	
2	Revised as per In House Review	3-6-18	TAC	
3				
4				
5				
6				
7				
8				
9				

SHANNON RIDGE
SECTION 33, TOWN 3, RANGE 3
LIBERTY TOWNSHIP
BUTLER COUNTY, OHIO
PLAN AND PROFILE

bayer becker
www.bayerbecker.com
6900 Tylersville Road, Suite A
Mason, OH 45040 - 513.336.6600

Drawing: 17-0120 CD2
Drawn by: TAC
Checked by: XXX
Issue Date: 1-24-18
Sheet: 7/15

Plot time: Feb 19, 2019 – 12:35pm
Drawing name: J:\2017\17-0120\CV\DWG\17-0120 CD2.dwg – Layout Tab: PP7

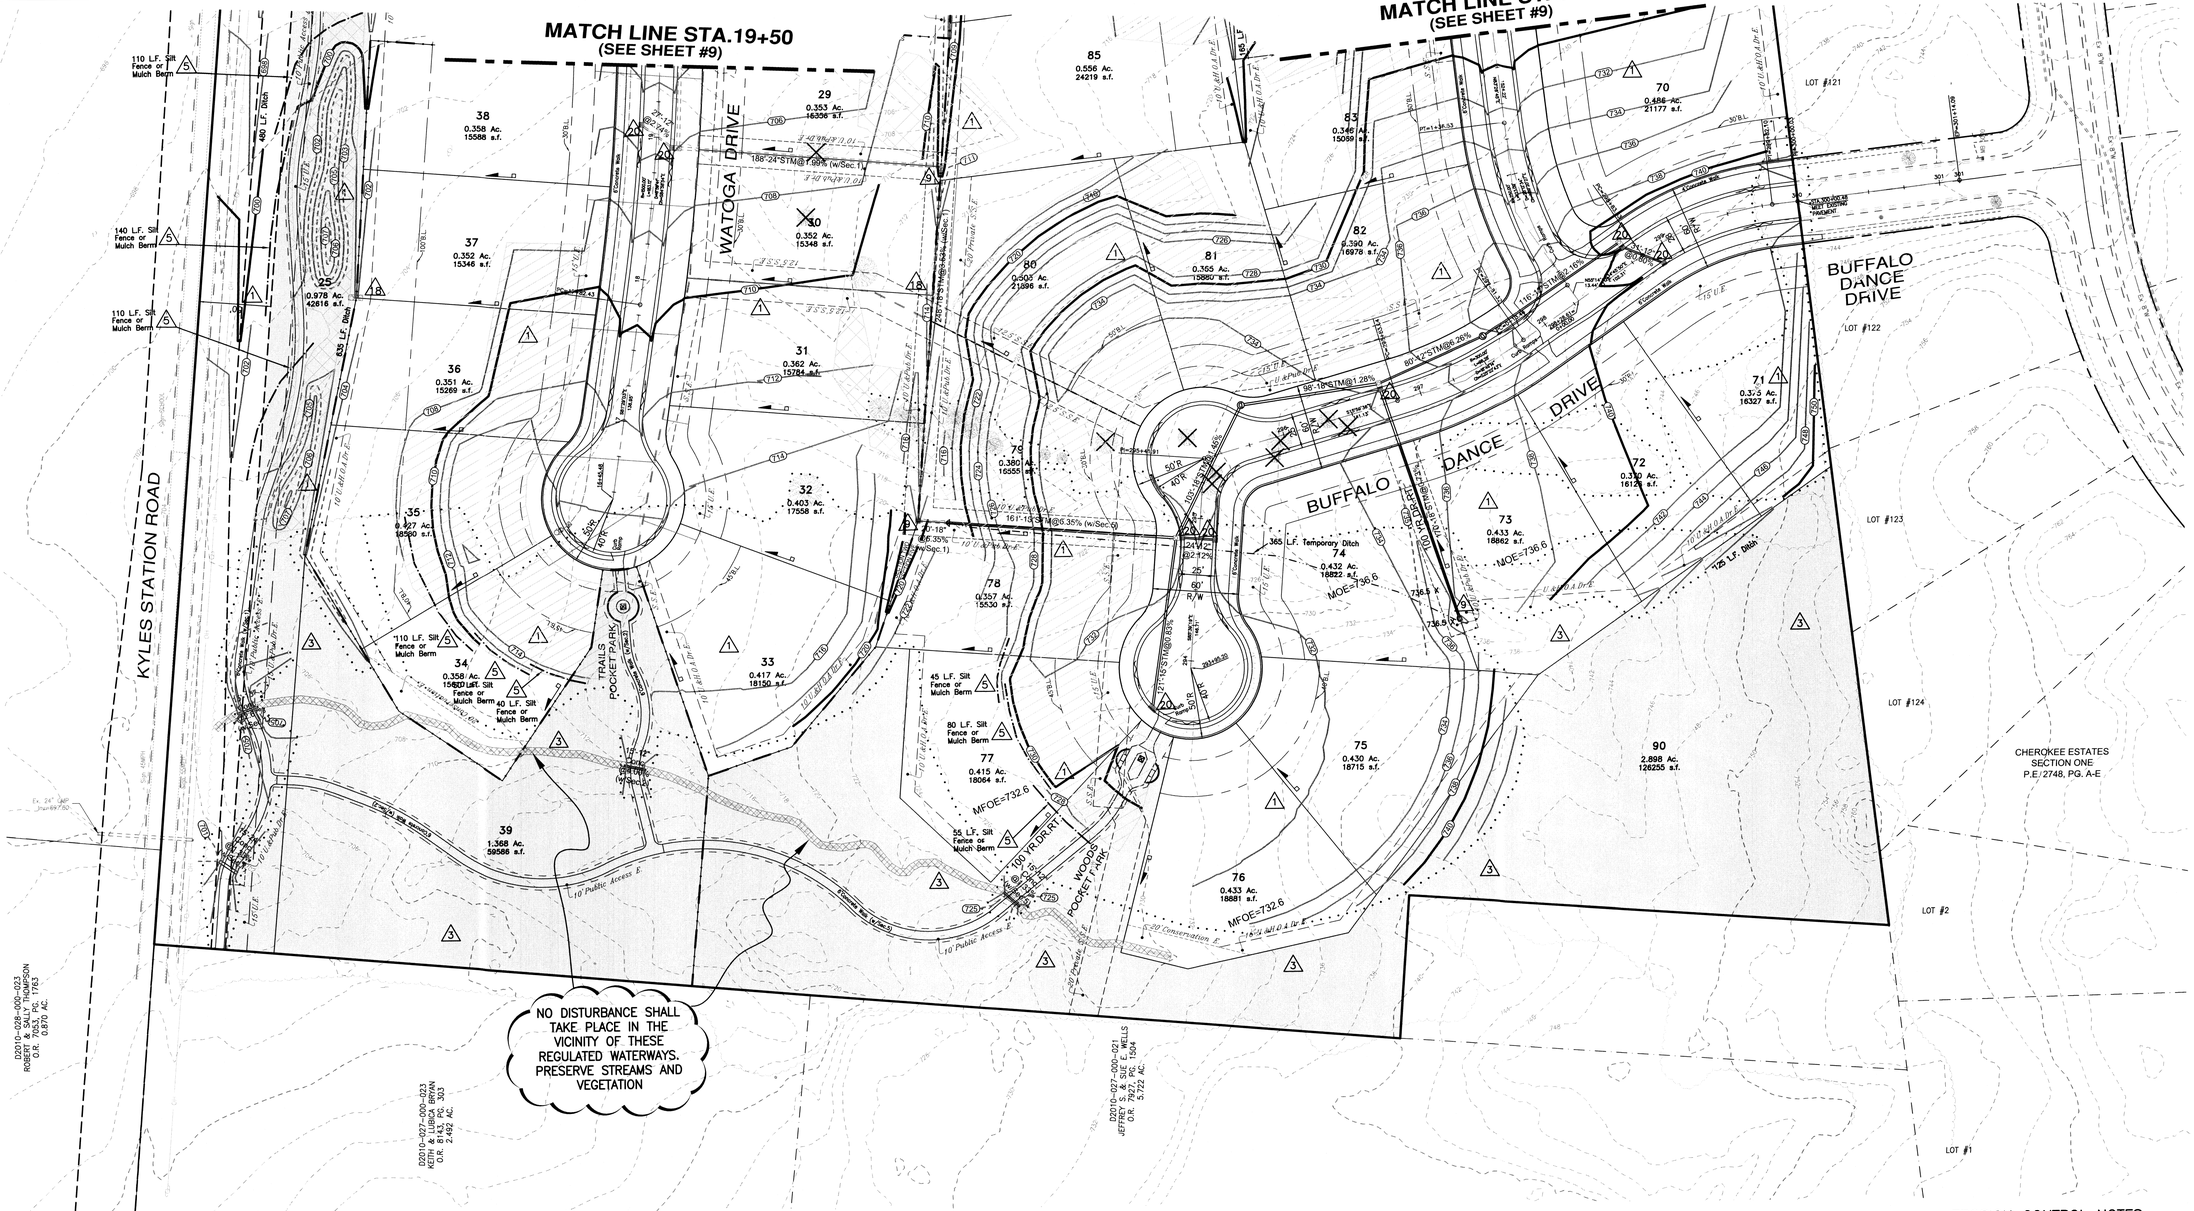

Basis of Bearing:
State Plane NAD83 (2011)

0 50 75

SCALE: 1" = 50'

Item	Revision Description	Date	Drwn.	Chk.

SHANNON RIDGE

SECTION 33, TOWN 3, RANGE 3
LIBERTY TOWNSHIP
BUTLER COUNTY, OHIO

GRADING PLAN

bayer becker
www.bayerbecker.com
6900 Tylersville Road, Suite A
Mason, OH 45040 - 513.336.5600

Drawing:	17-0120 CD2
Drawn by:	TAC
Checked By:	XXX
Issue Date:	1-24-18
Sheet:	8/15

NOTES:

1. Regular inspection and maintenance will be provided for all erosion and sediment control practices. Permanent records of maintenance and inspections must be kept throughout the construction period. Inspections must be made a minimum of once every seven (7) days and immediately after storm events greater than 0.5 inches of rain in a 24 hour period. Provided will be name of inspector, major observations, date of inspection and corrective measures taken.
2. All erosion and sediment control practices must conform to the specifications of Rainwater and Land Development, Ohio's standards for storm water management, land development and urban stream protection.
3. Perimeter Sedimentation control and basins/traps shall be implemented as the first step of grading and within seven (7) days of initial grubbing or grading and shall continue to function until upland areas are stabilized.
4. Disturbed areas which will remain unworked for a period of twenty–one (21) days or more, shall be stabilized with seeding and mulching or other approved means within seven (7) days. All disturbed areas within fifty (50) feet of an intermittent or solid blue line stream shall be stabilized within two (2) days. All areas of a site which are at final grade shall be stabilized with seeding and mulching or other approved means within seven (7) days.
5. Quantities for Erosion Control may vary between detailed plans and field conditions during construction. Plan quantities are a minimum; more erosion control may be necessary due to environmental conditions.
6. Sedimentation control and ditch swales are subject to change upon completion of entire set of construction drawings.
7. No solid or liquid waste shall be discharged into storm water runoff.
8. Home builders are responsible for erosion control on each individual lot.

NOTE:
All existing paved areas, walls, buildings, golf course appurtenances, etc. to be removed. Location of on site bury pits to be disclosed to site engineer for notation on final plat.

NOTE:
Contractors to accept all quantities as correct prior to beginning construction.

NOTE:
Quantities for Erosion Control may vary between detailed plans and field conditions during construction. Plan quantities are a minimum; more erosion control may be necessary due to environmental conditions.

NOTE:
Sedimentation control and ditch swales are subject to change upon completion of entire set of construction drawings.

- CLEARING LIMITS
- SILT FENCE OR MULCH BERM
- 14" TOPSOIL CAP
- WASTE FILL: DO NOT STRIP
- OPEN SPACE
- REGULATED WATERWAY OF UNITED STATES
- RIPARIAN AREA: NO DISTURBANCE PERMITTED

Note: All ditches constructed by the Developer shall be sodded or hydra–seeded.

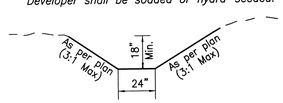

TYPICAL DITCH SECTION

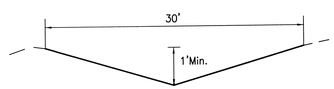

TYPICAL DRAINAGE ROUTE SECTION

EROSION CONTROL NOTES

1. SEEDING AND MULCHING
2. SODDING
3. PRESERVE EXISTING VEGETATION
4. STRAW BALE
5. SILT FENCE OR MULCH BERM
6. SOIL PILES
7. TEMPORARY STREAM CROSSING
8. GRAVEL CURB INLET SEDIMENT FILTER
9. GEOTEXTILE INLET SEDIMENT FILTER
10. GABIONS
11. STRAW BALE DROP INLET SEDIMENT FILTER
12. SOD DROP INLET SEDIMENT FILTER
13. GRAVEL & WIRE MESH DROP INLET SEDIMENT FILTER
14. BLOCK & GRAVEL CURB INLET SEDIMENT FILTER
15. TEMPORARY SEDIMENT TRAPS & DAMS
16. DIKES & SLOPE PROTECTION
17. ROLLED GRAVEL CURB INLET SEDIMENT FILTER
18. CHECK DAM
19. TEMPORARY DETENTION SEDIMENT FILTER/BASIN
20. DANDY BAG/BEAVER DAM® OR EQUAL
21. CONSTRUCTION ENTRANCE
22. CONCRETE WASHOUT AREA

SEE SOIL EROSION & SEDIMENTATION CONTROL DETAIL SHEET (Page #15)

Plot time: Feb 19, 2019 - 1:18pm
Drawing name: J:\2017\17-0120\CIVIL\DWG\17-0120 CD2.dwg - Layout Tab: GR8

Note: All ditches constructed by the Developer shall be sodded or hydra-seeded.

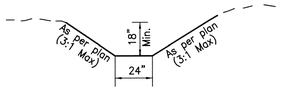

TYPICAL DITCH SECTION

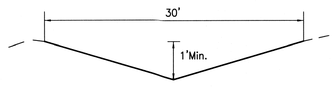

TYPICAL DRAINAGE ROUTE SECTION

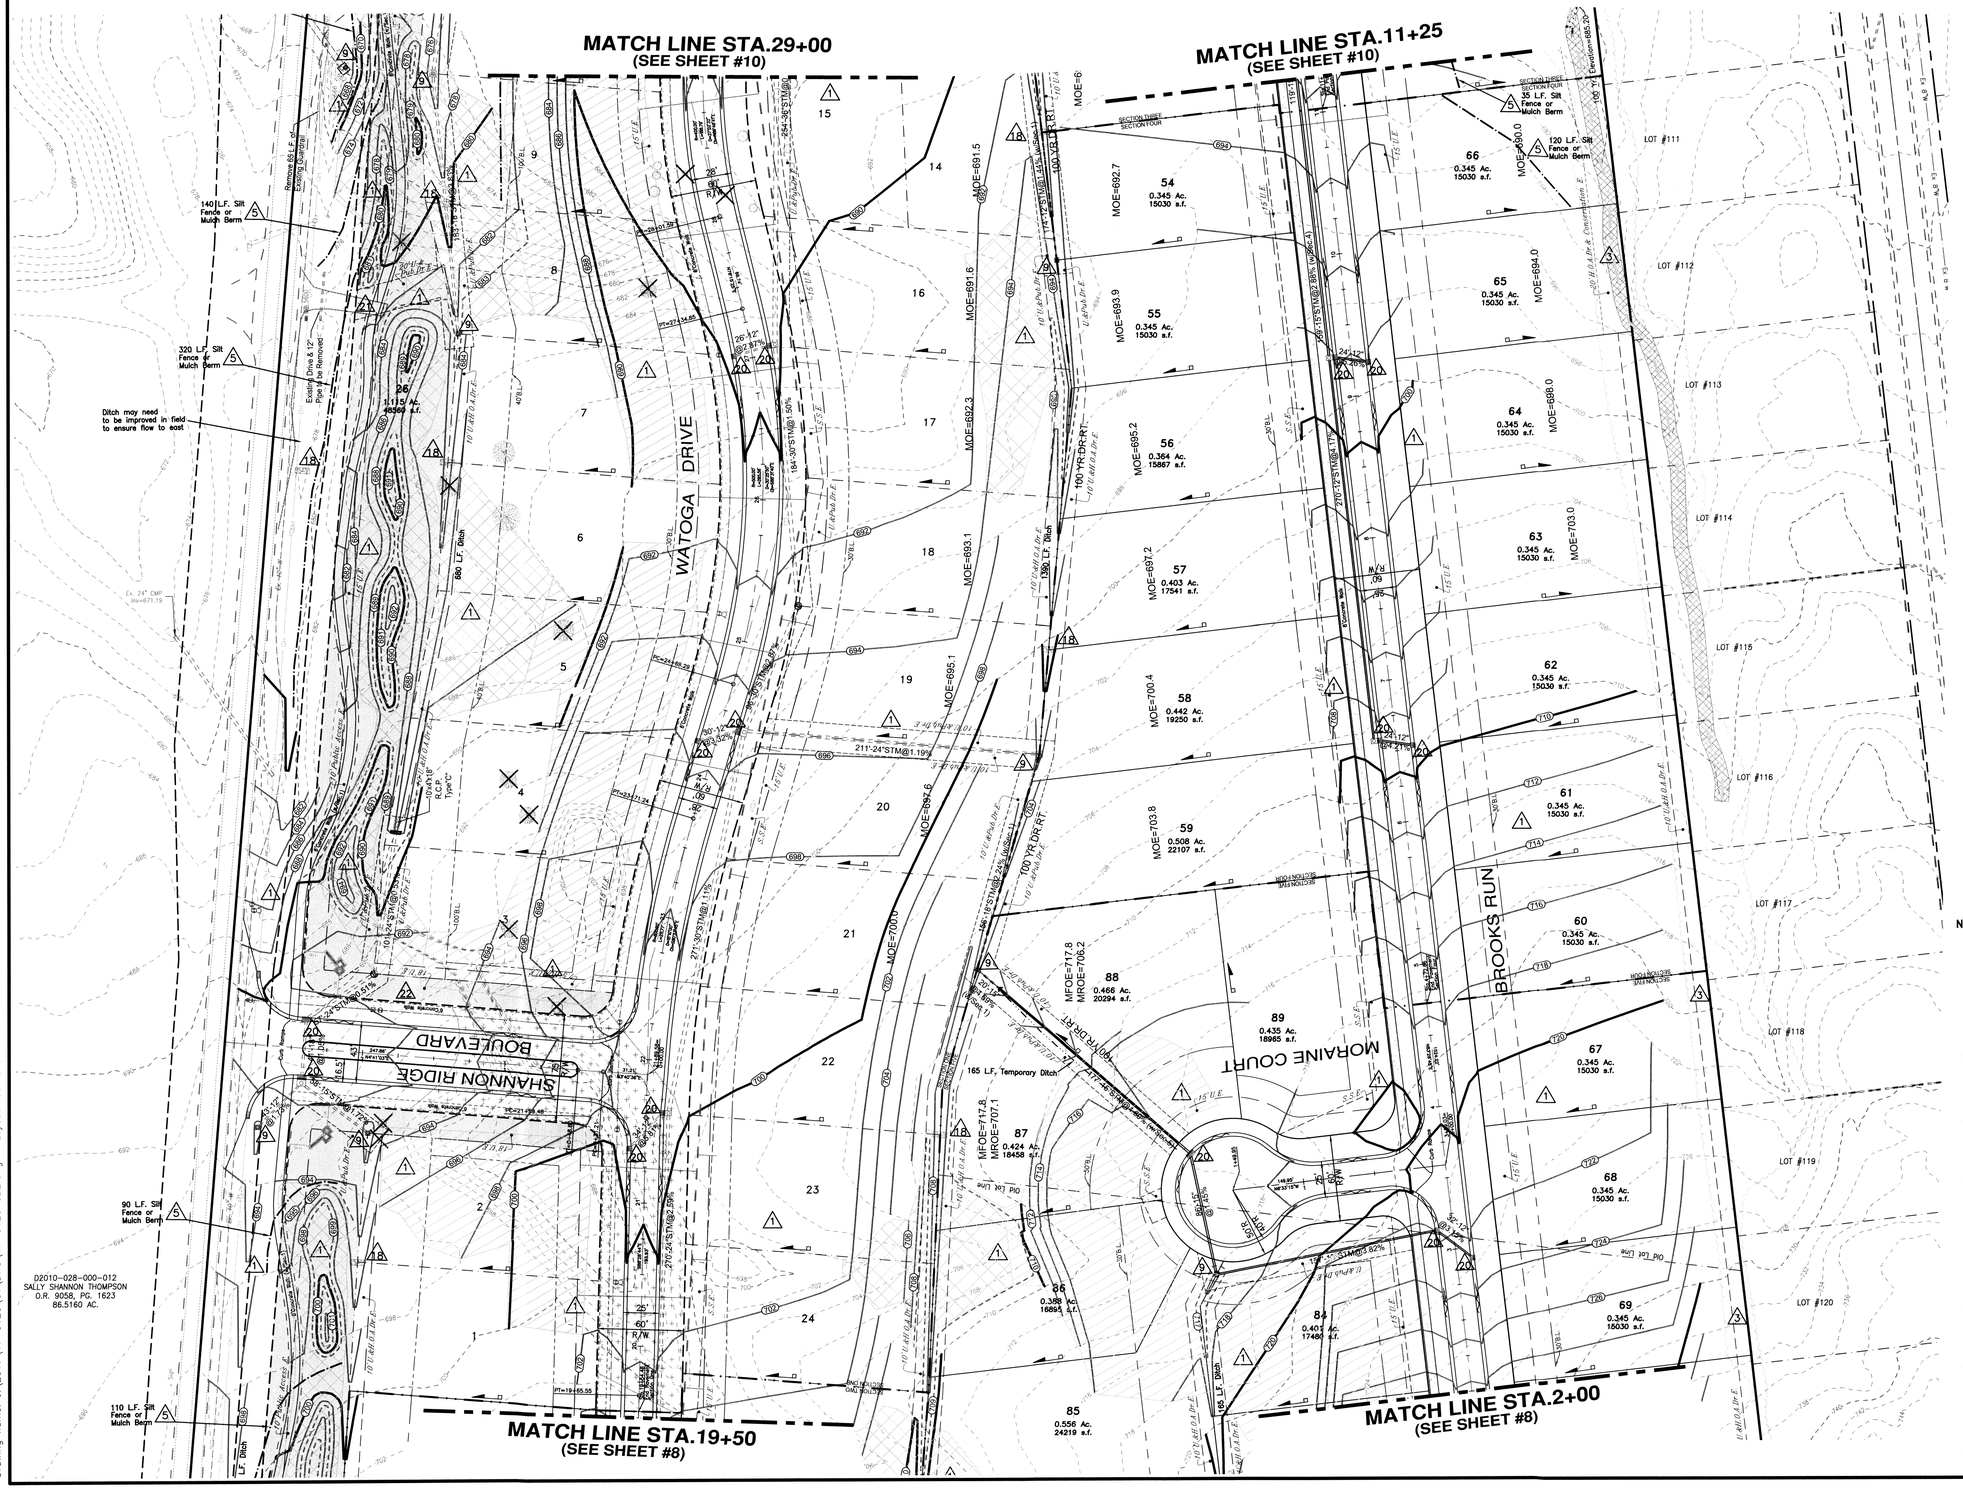

- CLEARING LIMITS
- SILT FENCE OR MULCH BERM
- 14" TOPSOIL CAP
- WASTE FILL: DO NOT STRIP
- OPEN SPACE
- THIS FILL REQUIRES COMPACTION TESTING FULL WIDTH OF RIGHT-OF-WAY
- REGULATED WATERWAY OF UNITED STATES
- RIPARIAN AREA: NO DISTURBANCE PERMITTED

EROSION CONTROL NOTES

1. SEEDING AND MULCHING
2. SODDING
3. PRESERVE EXISTING VEGETATION
4. STRAW BALE
5. SILT FENCE OR MULCH BERM
6. SOIL PILES
7. TEMPORARY STREAM CROSSING
8. GRAVEL CURB INLET SEDIMENT FILTER
9. GEOTEXTILE INLET SEDIMENT FILTER
10. GABIONS
11. STRAW BALE DROP INLET SEDIMENT FILTER
12. SOD DROP INLET SEDIMENT FILTER
13. GRAVEL & WIRE MESH DROP INLET SEDIMENT FILTER
14. BLOCK & GRAVEL CURB INLET SEDIMENT FILTER
15. TEMPORARY SEDIMENT TRAPS & DAMS
16. DIKES & SLOPE PROTECTION
17. ROLLED GRAVEL CURB INLET SEDIMENT FILTER
18. CHECK DAM
19. TEMPORARY DETENTION SEDIMENT FILTER/BASIN
20. DANDY BAG/BEAVER DAM® OR EQUAL
21. CONSTRUCTION ENTRANCE
22. CONCRETE WASHOUT AREA

SEE SOIL EROSION & SEDIMENTATION CONTROL DETAIL SHEET (Page #15)

NOTE:
All existing paved areas, walls, buildings, golf course appurtenances, etc. to be removed. Location of on site bury pits to be disclosed to site engineer for notation on final plat.

NOTE:
Contractors to accept all quantities as correct prior to beginning construction.

NOTE:
Quantities for Erosion Control may vary between detailed plans and field conditions during construction. Plan quantities are a minimum; more erosion control may be necessary due to environmental conditions.

NOTE:
Sedimentation control and ditch swales are subject to change upon completion of entire set of construction drawings.

NOTES:

1. Regular inspection and maintenance will be provided for all erosion and sediment control practices. Permanent records of maintenance and inspections must be kept throughout the construction period. Inspections must be made a minimum of once every seven (7) days and immediately after storm events greater than 0.5 inches of rain in a 24 hour period. Provided will be name of inspector, major observations, date of inspection and corrective measures taken.
2. All erosion and sediment control practices must conform to the specifications of Rainwater and Land Development, Ohio's standards for storm water management, land development and urban stream protection.
3. Perimeter Sedimentation control and basins/traps shall be implemented as the first step of grading and within seven (7) days of initial grubbing or grading and shall continue to function until upland areas are stabilized.
4. Disturbed areas which will remain unworked for a period of twenty-one (21) days or more, shall be stabilized with seeding and mulching or other approved means within seven (7) days. All disturbed areas within fifty (50) feet of an intermittent or solid blue line stream shall be stabilized within two (2) days. All areas of a site which are at final grade shall be stabilized with seeding and mulching or other approved means within seven (7) days.
5. Quantities for Erosion Control may vary between detailed plans and field conditions during construction. Plan quantities are a minimum; more erosion control may be necessary due to environmental conditions.
6. Sedimentation control and ditch swales are subject to change upon completion of entire set of construction drawings.
7. No solid or liquid waste shall be discharged into storm water runoff.
8. Home builders are responsible for erosion control on each individual lot.

Basis of Bearing:
State Plane NAD83 (2011)
0 50 75
SCALE: 1" = 50'

Item	Revision Description	Date	Drwn.	Chk.
1	Revised as per BCEO	3-8-18	TAC	
2				
3				
4				
5				
6				
7				
8				
9				

SHANNON RIDGE
SECTION 33, TOWN 3, RANGE 3
LIBERTY TOWNSHIP
BUTLER COUNTY, OHIO
GRADING PLAN

bayer becker
www.bayerbecker.com
6900 Tylersville Road, Suite A
Mason, OH 45040 - 513.336.6600

Drawing: 17-0120 CD2
Drawn by: TAC
Checked By: XXX
Issue Date: 1-24-18
Sheet: 9/15

Plot time: Feb 19, 2019 - 3:50pm
Drawing name: J:\2017\17-0120\CIV\DWG\17-0120 CD2.dwg - Layout Tab: GR9

NOTE:
Geotechnical Engineer to be on site during construction of Retention Basin.

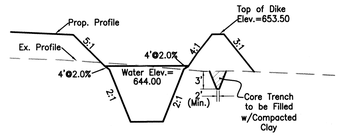

RETENTION POND DAM TYPICAL SECTION
(Not to Scale)

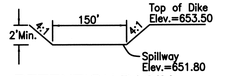

RETENTION BASIN SPILLWAY DETAIL
(Not to Scale)

Note: All ditches constructed by the Developer shall be sodded or hydra-seeded.

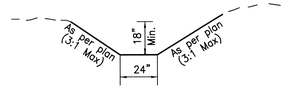

TYPICAL DITCH SECTION

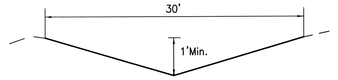

TYPICAL DRAINAGE ROUTE SECTION

- CLEARING LIMITS
- SILT FENCE OR MULCH BERM
- 14" TOPSOIL CAP
- WASTE FILL: DO NOT STRIP
- OPEN SPACE
- REGULATED WATERWAY OF UNITED STATES
- RIPARIAN AREA: NO DISTURBANCE PERMITTED

EROSION CONTROL NOTES

1. SEEDING AND MULCHING
2. SODDING
3. PRESERVE EXISTING VEGETATION
4. STRAW BALE
5. SILT FENCE OR MULCH BERM
6. SOIL PILES
7. TEMPORARY STREAM CROSSING
8. GRAVEL CURB INLET SEDIMENT FILTER
9. GEOTEXTILE INLET SEDIMENT FILTER
10. GABIONS
11. STRAW BALE DROP INLET SEDIMENT FILTER
12. SOD DROP INLET SEDIMENT FILTER
13. GRAVEL & WIRE MESH DROP INLET SEDIMENT FILTER
14. BLOCK & GRAVEL CURB INLET SEDIMENT FILTER
15. TEMPORARY SEDIMENT TRAPS & DAMS
16. DIKES & SLOPE PROTECTION
17. ROLLED GRAVEL CURB INLET SEDIMENT FILTER
18. CHECK DAM
19. TEMPORARY DETENTION SEDIMENT FILTER/BASIN
20. DANDY BAG/BEAVER DAM® OR EQUAL
21. CONSTRUCTION ENTRANCE
22. CONCRETE WASHOUT AREA

SEE SOIL EROSION & SEDIMENTATION CONTROL DETAIL SHEET (Page #15)

NOTE:
All existing paved areas, walls, buildings, golf course appurtenances, etc. to be removed. Location of on site bury pits to be disclosed to site engineer for notation on final plat.

NOTE:
Contractors to accept all quantities as correct prior to beginning construction.

NOTE:
Quantities for Erosion Control may vary between detailed plans and field conditions during construction. Plan quantities are a minimum; more erosion control may be necessary due to environmental conditions.

NOTE:
Sedimentation control and ditch swales are subject to change upon completion of entire set of construction drawings.

NOTES:

1. Regular inspection and maintenance will be provided for all erosion and sediment control practices. Permanent records of maintenance and inspections must be kept throughout the construction period. Inspections must be made a minimum of once every seven (7) days and immediately after storm events greater than 0.5 inches of rain in a 24 hour period. Provided will be name of inspector, major observations, date of inspection and corrective measures taken.
2. All erosion and sediment control practices must conform to the specifications of Rainwater and Land Development, Ohio's standards for storm water management, land development and urban stream protection.
3. Perimeter Sedimentation control and basins/traps shall be implemented as the first step of grading and within seven (7) days of initial grubbing or grading and shall continue to function until upland areas are stabilized.
4. Disturbed areas which will remain unworked for a period of twenty-one (21) days or more, shall be stabilized with seeding and mulching or other approved means within seven (7) days. All disturbed areas within fifty (50) feet of an intermittent or solid blue line stream shall be stabilized within two (2) days. All areas of a site which are at final grade shall be stabilized with seeding and mulching or other approved means within seven (7) days.
5. Quantities for Erosion Control may vary between detailed plans and field conditions during construction. Plan quantities are a minimum; more erosion control may be necessary due to environmental conditions.
6. Sedimentation control and ditch swales are subject to change upon completion of entire set of construction drawings.
7. No solid or liquid waste shall be discharged into storm water runoff.
8. Home builders are responsible for erosion control on each individual lot.

STREAM CROSSING DETAILS

The Ohio E.P.A. has concerns about any sanitary sewer which cross or run parallel to any flowing streams. For streams which drain one square mile or greater, communities are required to implement control practices in these areas as much as possible. For streams with less than one square mile of drainage, communities must implement control practices as much as practical. The area of concern include 2.5 times the full bank width of the stream on both sides of the stream (riparian area). For these stream crossings or other areas where the sewers are in this riparian area, the entity should specify the means for mitigating any impacts on these streams which could result from this activity. These factors would include the following:

a. The construction easements for the clearing activities should be as narrow as possible or practical depending on the size of the stream. A maximum of a 20 foot clearing limit is all that will be allowed in the riparian area. For all sanitary sewers running proposed along a stream, the clearing limit should be shifted as far from the stream as possible.
b. The construction of the stream crossing should be completed as soon as possible but should not exceed more than one day.
c. The material removed from the trench excavation should be stored outside of the riparian area. This area should be enclosed by a siltation fence.
d. Trees within the riparian area should be avoided as much as possible. Older trees along the stream should be given the greatest level of protection possible. In the event that a tree must be removed so that the sewers can be constructed, the tree should be either cut at the ground or 1 or 2 feet above the ground so that the root mass is maintained and that the tree may regrow after the project. All other vegetation in the riparian area should be cut at the ground surface.
e. Intended for trench water.
e. Coffer dams should be used to bypass the trench excavation during the construction of the stream crossing.
f. Final bank stabilization should be completed immediately after completion of the stream crossing. The banks shall be stabilized with seeding and mulching as soon as disturbance of the area is complete. In the event that a stream bank is severely steep, jute matting may be utilized to provide bank stabilization. In most cases, the stream bank should be stabilized within one day of completion of the stream crossing.
g. The stockpile location for the materials used for the pipe bedding material and the backfill material should be shown on the detailed plans. This area should be located outside of the riparian area. (See plans for stockpile location)
h. Any locations where equipment will cross the stream should have a temporary stream crossing constructed. Construction equipment crossings should only be used when there is no other feasible method such as constructing sewers from both sides of the stream. For situations where this may not be practical, two common ways to construct a stream crossing are using tree trunks removed from other locations of the project lold lengthwise in the stream or constructing a culvert in the stream with bank fill placed on top of it. The temporary stream culverts should be designed in accordance to the Ohio Department of Natural Resources, Division of Soil and Water Conservation's "Rainwater and Land Development" manual.
i. All trench dewatering shall be passed through a sediment impoundment structure. Adequate outlet protection must be provided for each impoundment. If any groundwater dewatering should occur, the contractor shall contact the Ohio Department of Nature Resources, Division of Water, to assure proper well installation and abandonment of wells. The contractor shall not direct the groundwater to the impoundment intended for trench water.

Basis of Bearing:
State Plane NAD83 (2011)
0 50 75
SCALE: 1" = 50'

Item	Revision Description	Date	Drwn.	Chk.
1	Revised as per BCEO	3-8-18	TAC	

SHANNON RIDGE
SECTION 33, TOWN 3, RANGE 3
LIBERTY TOWNSHIP
BUTLER COUNTY, OHIO
GRADING PLAN

bayer becker
www.bayerbecker.com
6900 Tylersville Road, Suite A
Mason, OH 45040 - 513.336.6600

Drawing: 17-0120 CD2
Drawn by: TAC
Checked By: XXX
Issue Date: 1-24-18
Sheet: 10/15

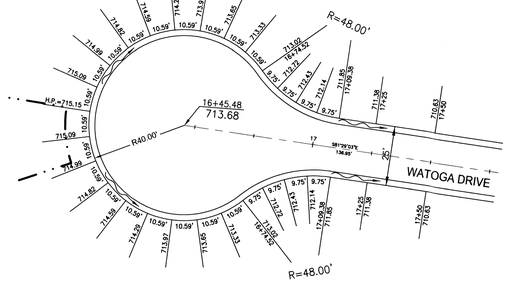

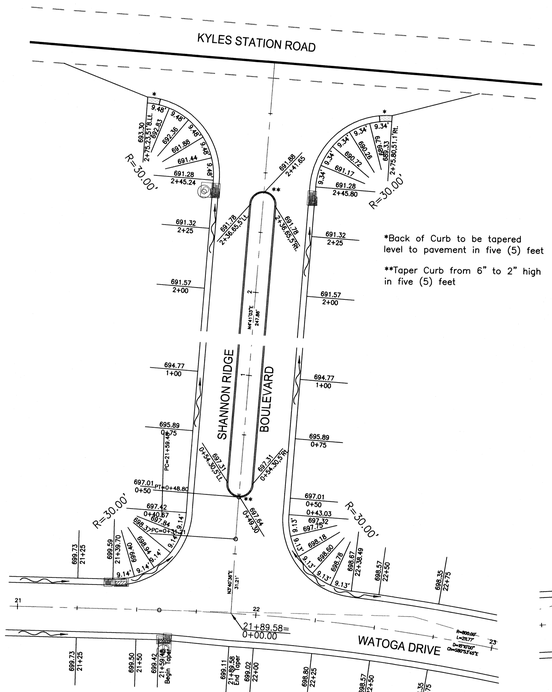

*Back of Curb to be tapered level to pavement in five (5) feet

**Taper Curb from 6" to 2" high in five (5) feet

USPS APPROVED SPECIFICATIONS – CONCRETE PAD (SINGLE UNIT)
(All measurements are in inches)

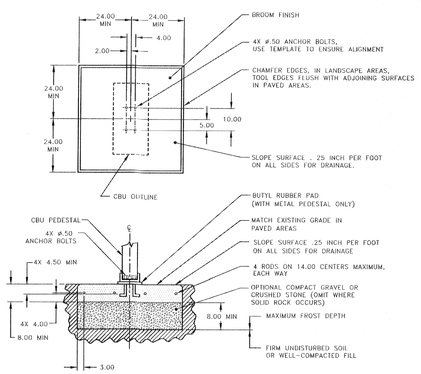

NOTES:
1. CONCRETE SHALL HAVE A COMPRESSIVE STRENGTH OF 3000 PSI @ 28 DAYS, CONTAIN 4% MIN – 6% MAX AIR ENTRAINMENT AND BE PLACED WITH A 3.50 – 4.50 SLUMP IN ACCORDANCE WITH ACI 301.
2. REINFORCING STEEL RODS SHALL CONFORM TO ASTM A615, GRADE 60.
3. ANCHOR BOLTS SHALL CONFORM TO ASTM A193, GRADE B8M, TYPE 316 STAINLESS STEEL.

USPS APPROVED SPECIFICATIONS – CONCRETE PAD (MULTIPLE UNIT)

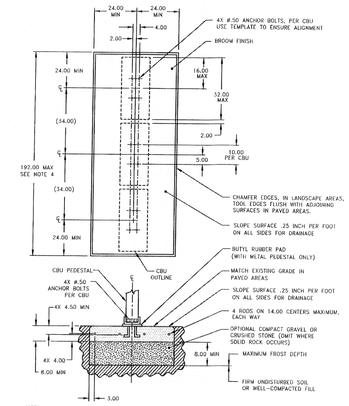

NOTES:
1. CONCRETE SHALL HAVE A COMPRESSIVE STRENGTH OF 3000 PSI @ 28 DAYS, CONTAIN 4% MIN – 6% MAX AIR ENTRAINMENT AND BE PLACED WITH A 3.50 – 4.50 SLUMP IN ACCORDANCE WITH ACI 301.
2. REINFORCING STEEL RODS SHALL CONFORM TO ASTM A615, GRADE 60.
3. ANCHOR BOLTS SHALL CONFORM TO ASTM A193, GRADE B8M, TYPE 316 STAINLESS STEEL.
4. A 3 CBU CONFIGURATION IS DEPICTED. A 2 OR 4 CBU CONFIGURATION MAY BE USED AS LONG AS THEY ARE ARRANGED IN GROUPS SUCH THAT THE OVERALL DIMENSION OF THE CONCRETE BASE DOES NOT EXCEED 192 INCHES.

CLUSTER MAILBOX CONCRETE PAD DETAIL

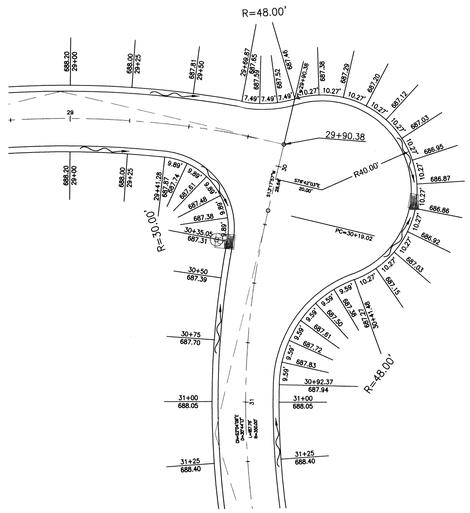

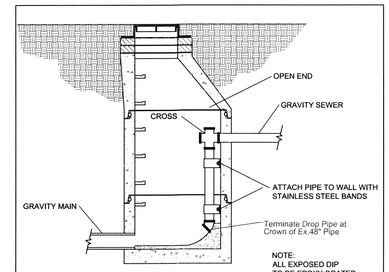

INSIDE DROP MANHOLE DETAIL FOR GRAVITY SEWERS

BUTLER COUNTY
WATER AND SEWER
130 HIGH STREET
HAMILTON, OH 45011
TELEPHONE: 513-887-3066
FAX: 513-887-3777
6165

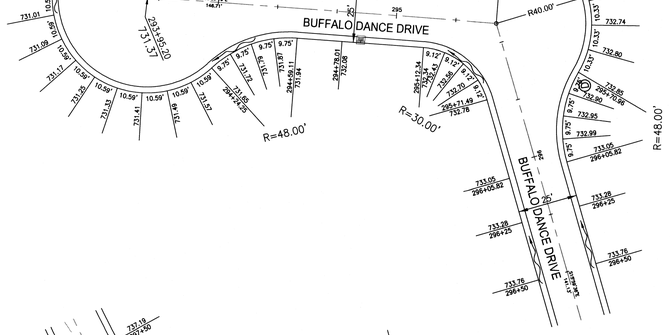

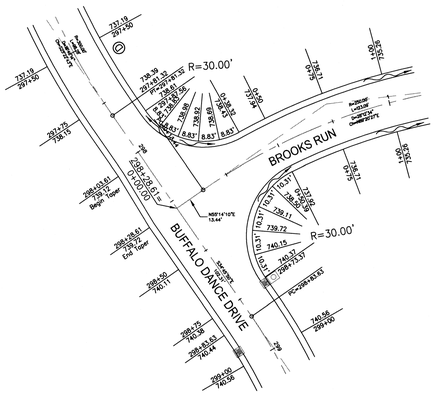

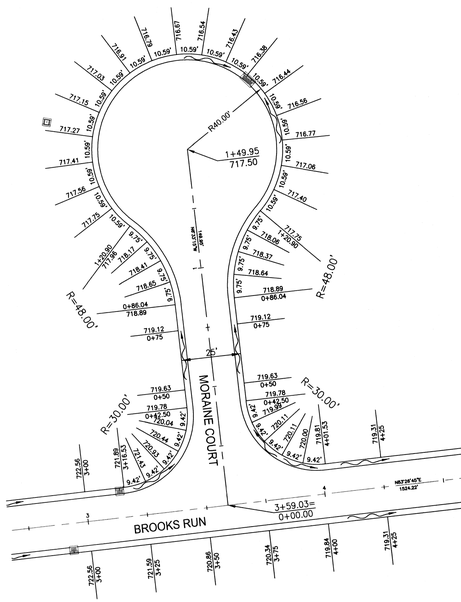

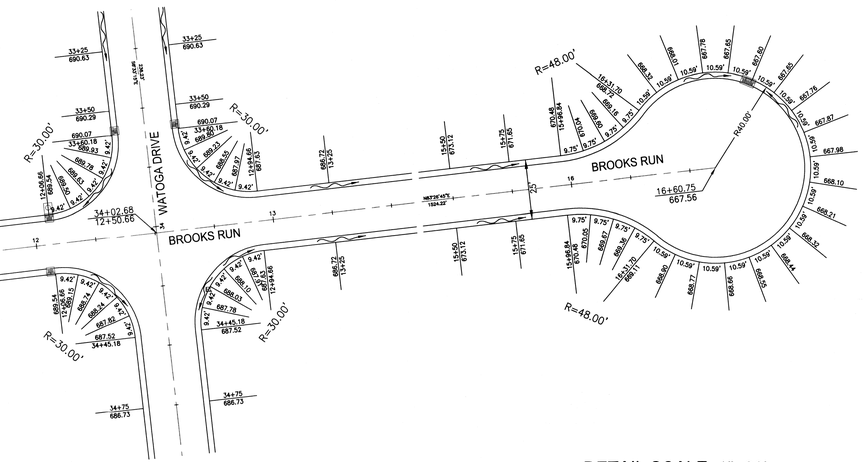

DETAIL SCALE: 1"=30'

Item	Revision Description	Date	Drwn.	Chk.
1	Revised as per EPA	3-16-18	TAC	
2				
3				
4				
5				
6				
7				
8				
9				

SHANNON RIDGE
SECTION 33, TOWN 3, RANGE 3
LIBERTY TOWNSHIP
BUTLER COUNTY, OHIO

INTERSECTION DETAILS

bayer becker
www.bayerbecker.com
6800 Tylersville Road, Suite A
Mason, OH 45040 - 513.336.6600

Drawing:	17-0120 CD2
Drawn by:	TAC
Checked By:	XXX
Issue Date:	1-24-18
Sheet:	11/15

Plot time: Feb 19, 2019 – 1:47pm
Drawing name: J:\2017\17-0120\CV\DWG\17-0120 CD2.dwg – Layout Tab: INT11

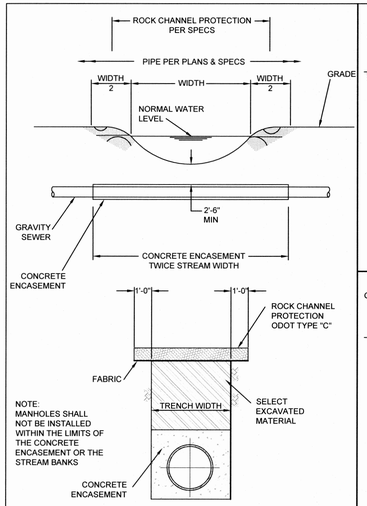

TYPICAL CREEK CROSSING FOR GRAVITY SEWERS

6260

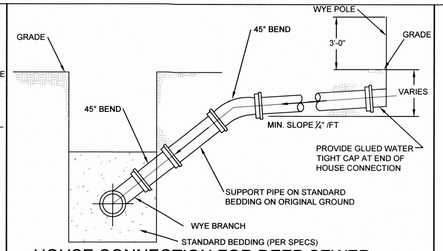

HOUSE CONNECTION FOR DEEP SEWER

6280

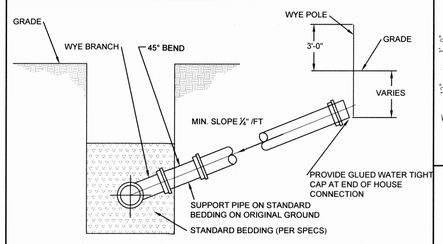

HOUSE CONNECTION FOR SHALLOW SEWER

6290

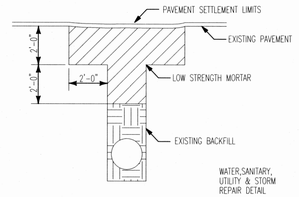

TRENCH 4' OR GREATER IN DEPTH

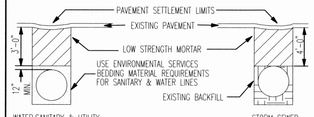

TRENCH 4' OR LESS IN DEPTH

SETTLEMENT REPAIR

ITEM SPECIAL – LOW STRENGTH MORTAR BACKFILL MATERIAL

DESCRIPTION: THIS WORK SHALL CONSIST OF THE PLACEMENT OF A FLOWABLE MIXTURE OF PORTLAND CEMENT, FLY ASH, AND SAND FOR BACK-FILLING CONDUIT OR AT OTHER LOCATIONS AS SHOWN ON THE PLANS OR AS SPECIFIED. THE WORK SHALL BE IN ACCORDANCE WITH ODOT ITEMS 603 AND 499 UNLESS OTHERWISE SPECIFIED HEREIN.

MATERIALS: MATERIALS SHALL BE:
A. CEMENT 701.01 OR 701.04
B. FLY ASH SHALL MEET ASTM C-618
C. FINE AGGREGATE SHALL BE NEUTRAL SAND OR SAND MANUFACTURED FROM STONE, GRAVEL, OR AIR-COOLED SLAG. THE GRADUATION OF THE SAND SHALL MEET THE REQUIREMENTS OF 703.05. THE SAND SHALL BE FINE ENOUGH TO STAY IN SUSPENSION IN THE MIXTURE TO THE EXTENT REQUIRED FOR PROPER FLOW. THE ENGINEER RESERVES THE RIGHT TO REJECT THE SAND IF THE FLOWABLE MIXTURE CANNOT BE PRODUCED.
D. WATER USED FOR MORTAR BACKFILL SHALL BE FREE FROM OIL, ACID, STRONG ALKALOIDES OR VEGETABLE MATTER.
E. SLUMPS MEASURED IN THE ORDINARY WAY WILL BE 8" OR HIGHER FOR PROPER PLACEMENT OF THE FLOWABLE MATERIAL.

MORTAR MIX PROPORTIONING: THE INITIAL TRIAL MIXTURE SHALL CONSIST OF THE FOLLOWING QUANTITIES OF MATERIALS PER CUBIC YARD:

CLASS LSM – 50	
CEMENT	50 LBS.
FLY ASH	250 LBS.
SAND	2910 LBS.
WATER (TARGET)	500 LBS.

ADJUSTMENTS TO THE PROPORTIONS MAY BE MADE BY THE ENGINEER PROVIDING THE TOTAL ABSOLUTE VOLUME OF THE MATERIALS IS MAINTAINED. THIS ITEM WILL BE INCLUDED IN THE STANDARD 603 INSULATION, THIS WILL NOT BE AN ADDITIONAL PAY ITEM, BUT REPLACEMENT FOR THE NORMAL BACKFILL.

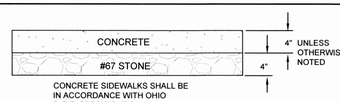

SIDEWALK RESTORATION DETAIL

4010

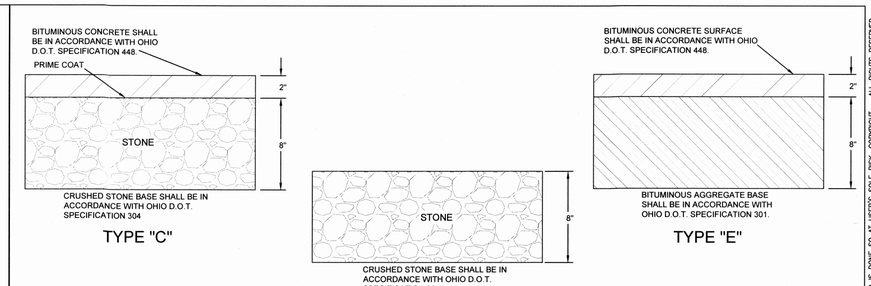

PAVEMENT REPLACEMENT DETAILS

4120

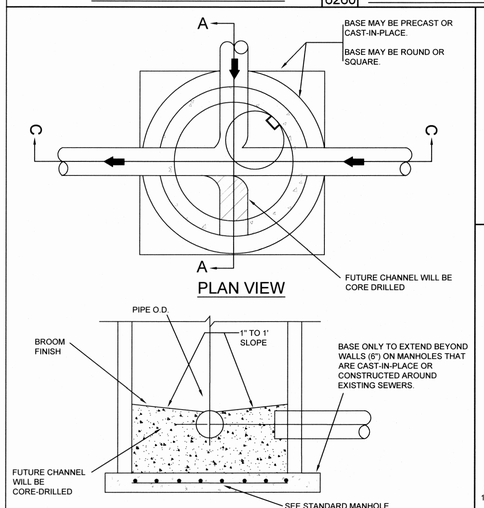

6130

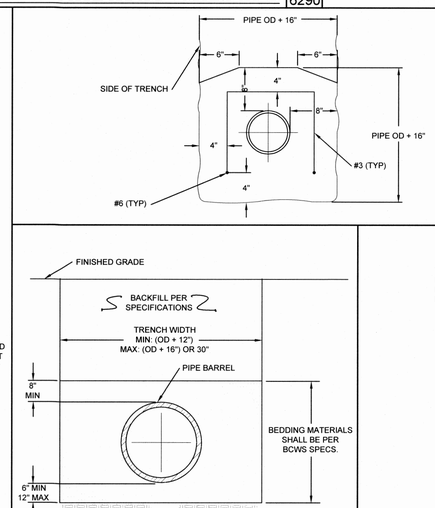

6270

CONCRETE ENCASEMENT DETAIL

PIPE SIZE	CY CONC PER LIN FT	LENGTH OF NO 3 BARS	SPACING (FT) BETWEEN NO 3 BARS
6"	0.121	3'-9"	1.64
8"	0.139	4'-3"	1.25
10"	0.157	4'-9"	1.12
12"	0.177	5'-3"	1.02
16"	0.200	6'-3"	0.85
18"	0.247	6'-10"	0.78
20"	0.270	7'-5"	0.72
24"	0.315	8'-6"	0.63
30"	0.540	10'-0"	0.57

6240

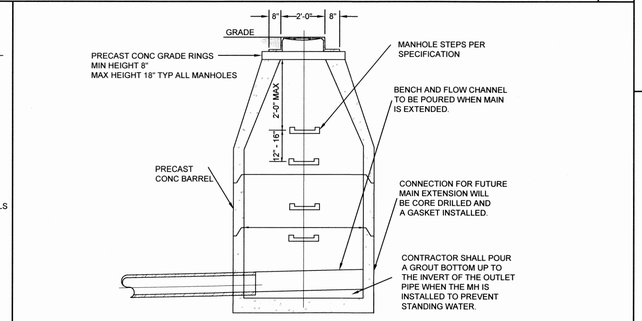

6190

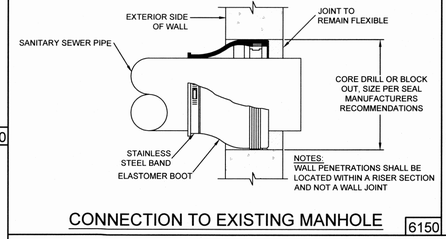

6150

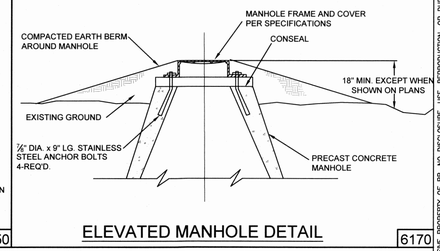

6170

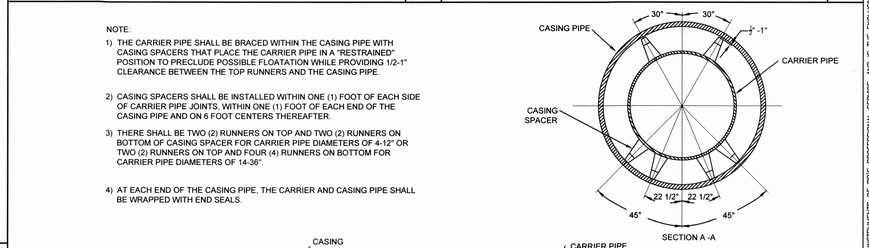

4370

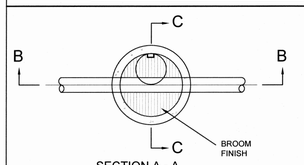

M.H. DEPTH	SLAB & DOWELL RESTEEL SQ. IN./FT. E.W.
0'-10'	0.17
11'-20'	0.22
21'-30'	0.27
31'-40'	0.32

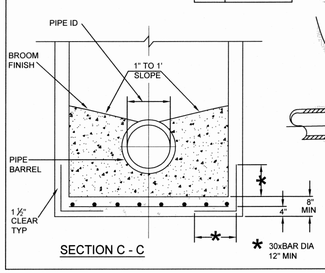

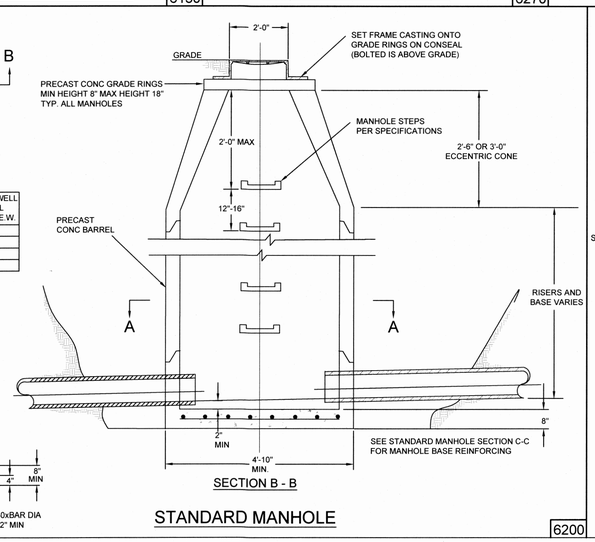

6200

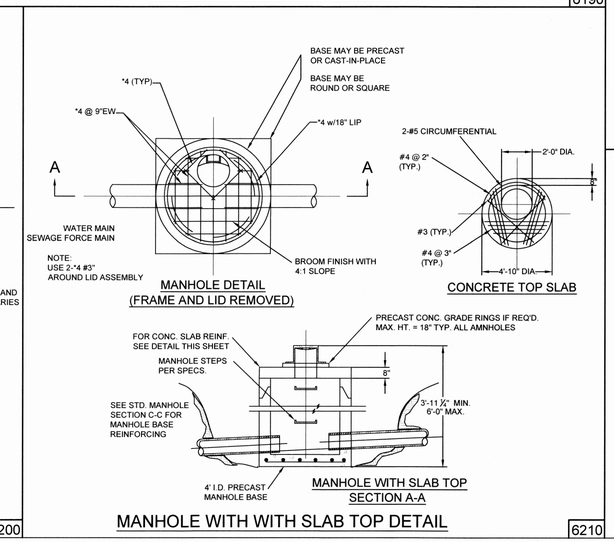

6210

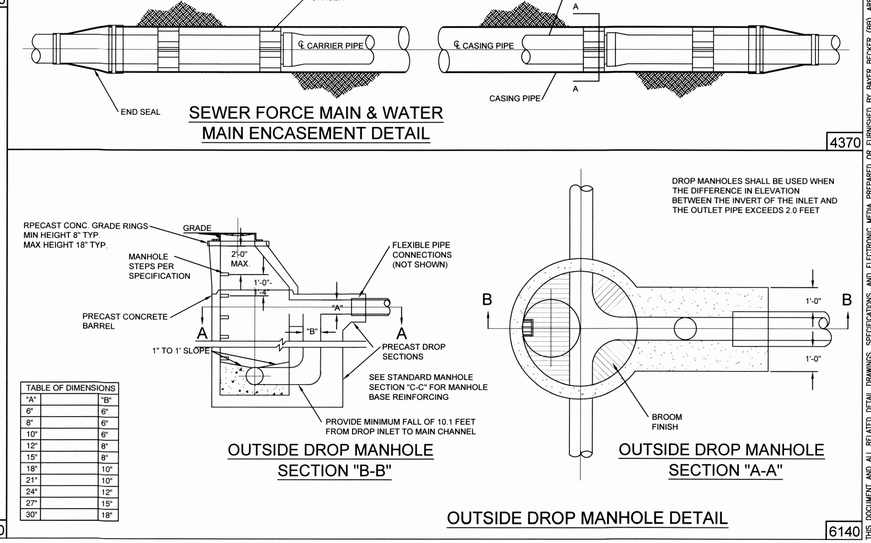

TABLE OF DIMENSIONS	
"A"	"B"
6"	6"
8"	6"
10"	6"
12"	8"
15"	8"
18"	10"
21"	10"
24"	12"
27"	15"
30"	18"

OUTSIDE DROP MANHOLE DETAIL

6140

THIS DOCUMENT AND ALL RELATED DETAIL DRAWINGS, SPECIFICATIONS, AND ELECTRONIC MEDIA PREPARED OR FURNISHED BY BAYER BECKER (BB), ARE INSTRUMENTS OF BB'S PROFESSIONAL SERVICE, AND IS THE EXCLUSIVE PROPERTY OF BB. NO DISCLOSURE, USE, REPRODUCTION, OR DUPLICATION IN WHOLE, OR IN PART, MAY BE MADE WITHOUT WRITTEN PERMISSION OF BB, AND IS DONE SO AT USER'S SOLE RISK. COPYRIGHT – ALL RIGHTS RESERVED.

Item	Revision Description	Date	Drwn:	Chk:

BUTLER COUNTY, OHIO

MISCELLANEOUS & SANITARY DETAILS

bayer becker
www.bayerbecker.com
8900 Tylersville Road Suite A
Mason, Ohio 45040 - 513.336.6600

Drawing: BC SAN
Drawn by:
Checked By:
Issue Date: 12-28-17

Sheet: 12/15

Plot time: Jan 24, 2018 – 2:21 pm
Drawing name: K:\~FF\BLOCKS\DETAILS\BUTLER\BC SAN.dwg – Layout Tab: SAN

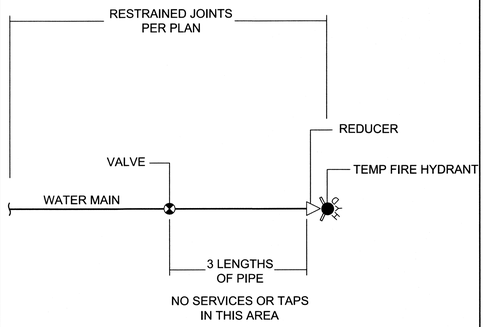

DEAD END DETAIL
WITH TEMPORARY FIRE HYDRANT

5140

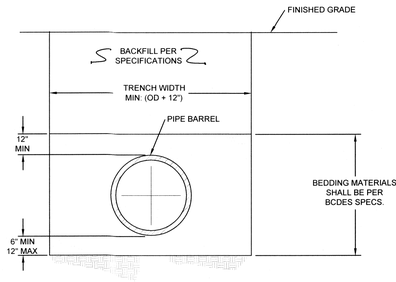

TYPICAL TRENCH DETAIL
WATER MAIN INSTALLATION

5280

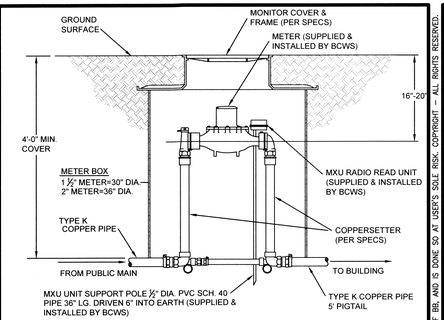

METER TYPE	LAYING LENGTH
1 ½" C2 OMNI	13"
1 ½" T2 OMNI	13"
2" C2 OMNI AS SUPPLIED BY BUTLER COUNTY SEE NOTE 3	17"
2" C2 OMNI FACTORY ORDERED	15 ½"
2" T2 OMNI	17"

NOTE:
1) FOR METERS 3" AND LARGER, REFER TO THE STD. INSTALLATION FOR 3" AND LARGER WATER METERS.

2) ALL DOMESTIC WATER METERS SHALL BE SENSUS OMNI C2 TYPES FOR SIZES OF 1 1/2" AND LARGER. NON-DOMESTIC , (IE. DEDUCT, IRRIGATION), MAY BE EITHER SENSUS OMNI T2 OR C2 TYPES FOR SIZES OF 1 1/2" AND LARGER.

3) BUTLER COUNTY ORDERS 2" C2 OMNI METERS WITH A 17" LAYING LENGTH TO ACCOMODATE THE STANDARD COPPERSETTER. IF THE FACTORY ORDERED SIZE IS UTILIZED AN ADAPTER FLANGE PLATE WILL BE REQUIRED

STANDARD INSTALLATION FOR
1-1/2" & 2" WATER METER SETTINGS

5170

NOTE:
FOR WATER MAINS ONLY:
MODIFICATIONS FROM THIS DETAIL
MAY BE NECCESSARY IF WATER WIDTH
IS GREATER THAN 15'-0" (SEE SPECS)

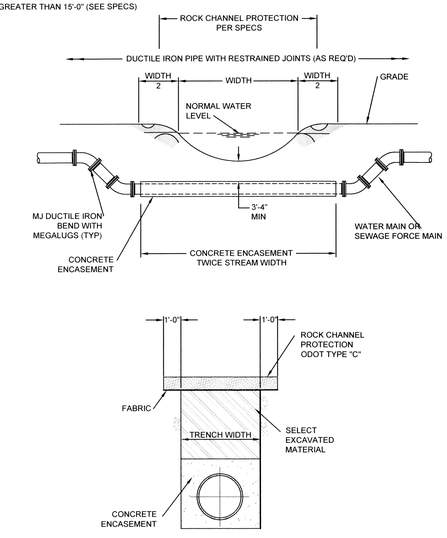

TYPICAL CREEK CROSSING &
TRENCH DETAIL FOR WATER &
SEWER FORCE MAINS

4170

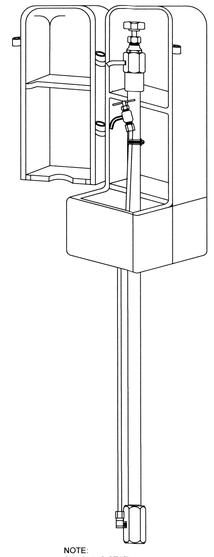

STATION SHALL BE ENCLOSED IN A LOCKABLE, NON-REMOVABLE ALUMINUM BOX WITH HINGED OPENINGS.

ALL WORKING PARTS SHALL BE OF STAINLESS STEEL AND SERVICABLE FROM ABOVE GROUND WITH NO DIGGING OR REPLACEMENT NEEDED.

THE STATION SHALL BE MODEL #88-SS AS MANUFACTURED BY THE KUPFERLE FOUNDARY, ST. LOUIS MO. OR APPROVED EQUAL.

NOTE:
SAMPLING STATIONS SHALL BE
INSTALLED PER BCWS SPECS.

PERMANENT LAB SAMPLING STATION

5270

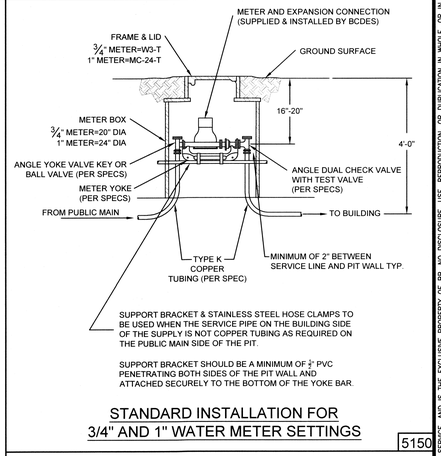

SUPPORT BRACKET & STAINLESS STEEL HOSE CLAMPS TO BE USED WHEN THE SERVICE PIPE ON THE BUILDING SIDE OF THE SUPPLY IS NOT COPPER TUBING AS REQUIRED ON THE PUBLIC MAIN SIDE OF THE PIT.

SUPPORT BRACKET SHOULD BE A MINIMUM OF ¾" PVC PENETRATING BOTH SIDES OF THE PIT WALL AND ATTACHED SECURELY TO THE BOTTOM OF THE YOKE BAR.

STANDARD INSTALLATION FOR
3/4" AND 1" WATER METER SETTINGS

5150

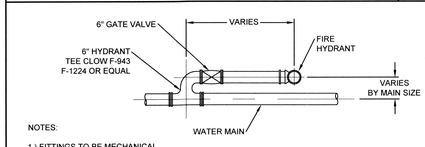

NOTES:

1.) FITTINGS TO BE MECHANICAL JOINT HYDRANT ANCHOR FITTINGS.

2.) SEE TYPICAL FIRE HYDRANT INSTALLATION DETAIL FOR ADDITIONAL DETAILS (#5110)

SETTING FOR HYDRANT
ADJACENT TO MAIN

5120

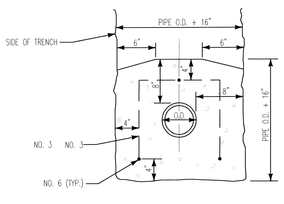

PIPE SIZE	C.Y. CONC. PER LIN. FT.	LENGTH OF NO. 3 BARS	SPACING (FT) BETWEEN NO. 3 BARS
6"	0.121	3'-9"	1.64
8"	0.139	4'-3"	1.25
10"	0.157	4'-9"	1.12
12"	0.177	5'-3"	1.02
16"	0.200	6'-3"	0.85
18"	0.247	6'-10"	0.78
20"	0.270	7'-5"	0.72
24"	0.315	8'-6"	0.63
30"	0.540	10'-0"	0.57

CONCRETE ENCASEMENT

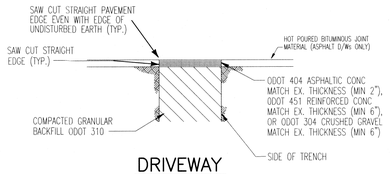

DRIVEWAY

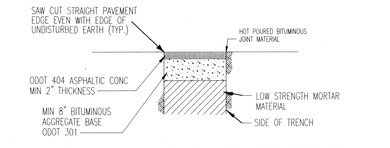

ASPHALTIC CONCRETE ROADWAY

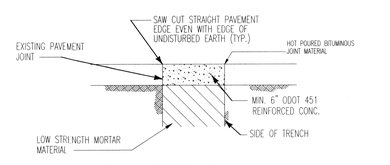

CONCRETE ROADWAY

PAVEMENT REPLACEMENT DETAILS

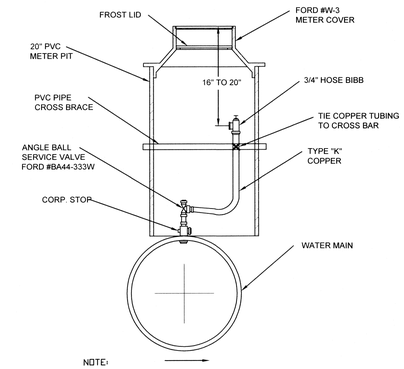

NOTE:
1) PIPE LESS THAN OR EQUAL TO 12"ø MUST USE 3/4" CORP. STOP, ANGLE BALL VALVE AND SERVICE PIPE.

2) PIPE GREATER THAN 12"ø TO USE 1" CORP. STOP, ANGLE BALL VALVE AND SERVICE PIPE.

AIR RELEASE VALVE DETAIL

5290

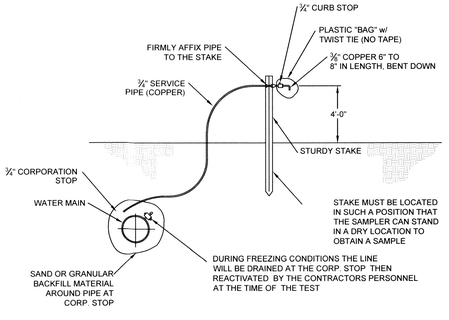

TEMPORARY PURITY TEST STATION

5260

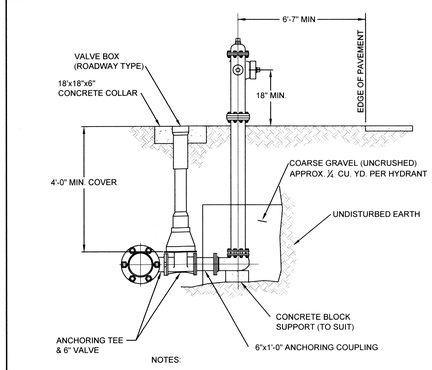

NOTES:

1.) VERIFY LOCATION OF F.H. RELATIVE TO WATER MAIN ON PLANS.

2.) CHECK STREET DETAILS FOR RELATIONSHIP BETWEEN MAIN, STREET AND F.H.

TYPICAL FIRE
HYDRANT INSTALLATION

5110

THIS DOCUMENT AND ALL RELATED DETAIL DRAWINGS, SPECIFICATIONS, AND ELECTRONIC MEDIA PREPARED OR FURNISHED BY BAYER BECKER (BB), ARE INSTRUMENTS OF BB'S PROFESSIONAL SERVICE, AND IS THE EXCLUSIVE PROPERTY OF BB. NO DISCLOSURE, USE, REPRODUCTION, OR DUPLICATION IN WHOLE, OR IN PART, MAY BE MADE WITHOUT WRITTEN PERMISSION OF BB. AND IS DONE SO AT USER'S SOLE RISK. COPYRIGHT – ALL RIGHTS RESERVED.

Item	Revision Description	Date	Drwn:	Chk:

BUTLER COUNTY, OHIO

WATER DETAILS

bayer becker
www.bayerbecker.com
6677 Tri-County Blvd., A
Mason, Ohio 45040 - 513.336.6800

Drawing: BC WAT
Drawn by:
Checked By:
Issue Date: 12-28-17
Sheet: 13/15

Plot time: Jan 24, 2018 – 2:22pm
Drawing name: K:\~FF\BLOCKS\DETAILS\BUTLER\BC WAT.DWG – Layout Tab: WAT

Plot time: Jan 24, 2018 – 2:23pm
Drawing name: K:\~FF\BLOCKS\DETAILS\BUTLER\Bcstmdet.dwg – Layout Tab: NewBorderStorm

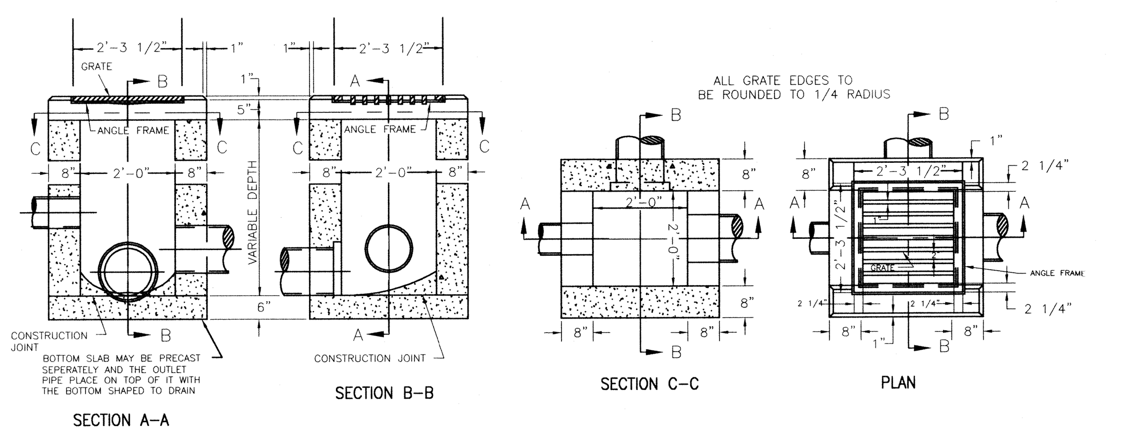

SECTION A-A — SECTION B-B — SECTION C-C — PLAN

STANDARD 2-2A CATCH BASIN

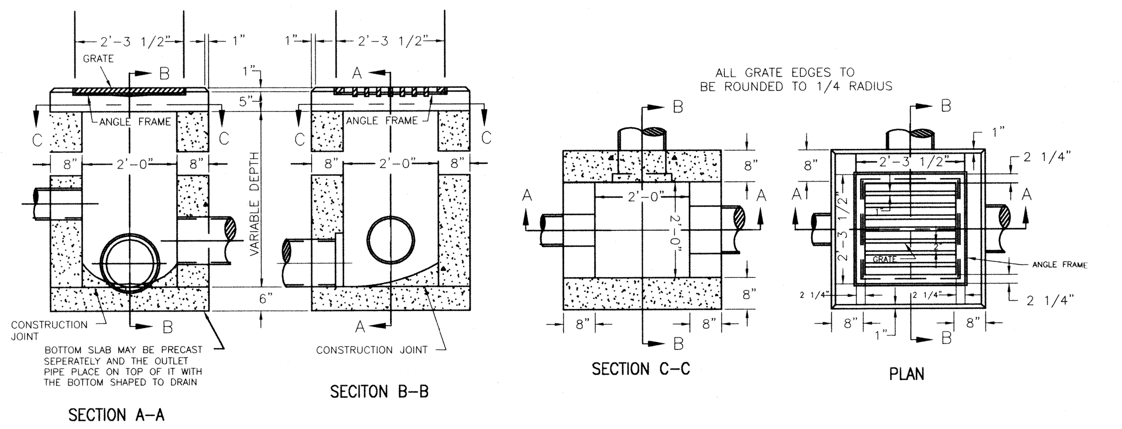

SECTION A-A — SECITON B-B — SECTION C-C — PLAN

STANDARD NO. 2-2B CATCH BASIN

NOTES

GRATING AND FRAME: Shall meet the requirements of 604. The design shall be essentially the same and equally as strong as the one shown hereon.
Weight of grate, minimum , 120 lbs.
Weight of frame, minimum, 40 lbs.
CONCRETE: Cast in place to be class "C".
BRICK OR CONCRETE BLOCK: Side walls, when used in place of concrete, shall be 8 inches nominal thickness. When catch basin above the flow line of the side opening shall be constructed of Portland Cement Concrete.
No. 2-2A: Side inlets to be placed 4 to 6 inches below normal elevations of median or ditch flow line, returning to normal 10 feet each side of the basin.
No. 2-2B: Grate elevation to be placed 4 to 6 inches below normal ditch returning to normal 10 feet each side of basin.
SIDE INLETS: Shall be provided on both sided of the No. 2-2A catch basin in sags and on upstream side only where the ditch has a continuous down grade past the catch basin.
MAXIMUM PIPE SIZE IS 21".
MAXIMUM DEPTH IS 4 FEET.
STEPS: Steps are to be installed in storm structures over 4' in depth and shall meet the requirements of drawing MH-1.

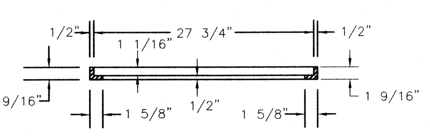

SECTION THROUGH ANGLE FRAME
FOR STANDARD 2-2A CATCH BASIN

REVISIONS	DATE	C-10
		CATCH BASIN CB 2-2A CB 2-2B
		CHK. BY: C.A.H. EFFECTIVE DATE: 1-1-94
		BUTLER COUNTY ENGINEERS OFFICE AND OPERATIONS FACILITY 1921 FAIRGROVE AVENUE – HAMILTON, OHIO 45011 PHONE 867-5744

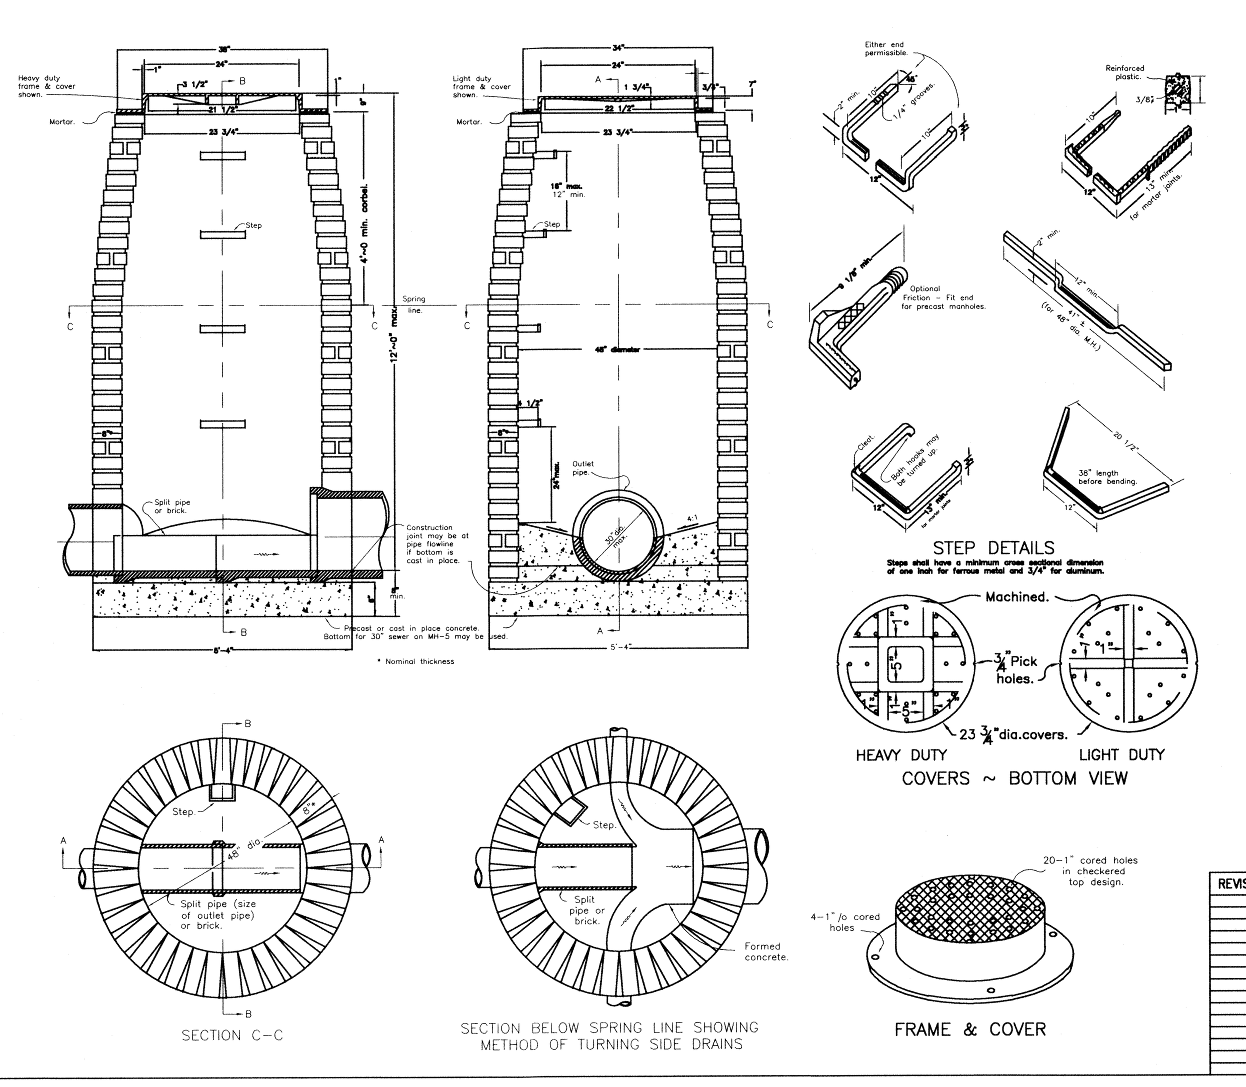

STEP DETAILS
Steps shall have a minimum cross sectional dimension of one inch for ferrous metal and 3/4" for aluminum.

HEAVY DUTY — LIGHT DUTY
COVERS ~ BOTTOM VIEW

SECTION C-C — SECTION BELOW SPRING LINE SHOWING METHOD OF TURNING SIDE DRAINS — FRAME & COVER

NOTES

CONSTRUCTION: No.1 manhole is for sewers 30" diameter or less. The design shown is for brick construction with every sixth course a stretcher course. The 6" bottom may be precast or cast in place concrete. The bottom channel sections shall be built with concrete and lined with split pipe or brick except curved channels may be formed in the concrete.
Precast solid concrete radial blocks or cast in place concrete reinforced with No.4 bars on 12" centers both vertically and horizontally, may be used with a wall thickness of 6" or greater. Precast manholes detailed on MH-3 or MH-5 may be used in lieu of the design shown hereon unless otherwise required by the plans.
FRAME AND COVERS shall be of heavy design (475 lbs. min. total weight) when the manhole is placed within the limits of the pavement or shoulder, otherwise the light design shall be finished smooth and fitted so as to provide a firm and even seat to all portions of the cover in the frame. Each cover shall seat in its frame without rocking and shall be marked as a matched frame and cover before delivery to the project. The base of the frame shall be set in a full bed of Portland cement mortar, and so adjusted to conform to the finished pavement or shoulder elevation and slope. Castings meeting Item 604 requirements and designed essentially the same and equally as strong those shown hereon shall be provided.
STEPS shall conform to the material requirements of specification 604. All steps shall have a depressed tread or a 1/2" minimum cleat height at the ends. Steps installed in fresh concrete shall be embedded to minimum depth of 4". Steps installed in mortar joints shall be embedded to a minimum depth of 7". Friction-fit steps meeting the requirements of 711.31 with a 1/2" diameter rebar may be used in precast manholes. The receiving holes for friction-fit steps shall not penetrate the manhole wall.
The Engineer may require the contractor to test load a maximum of one step per manhole to a proof load of 400 lbs. in direct pull. The equipment and method used shall meet the approval of the Engineer. If the selected step fails the pullout test, the remaining steps in that manhole shall also be tested. All steps not passing the pullout test shall be removed and a new step installed and tested to the satisfaction of the Engineer. Cost of testing shall be incidental to the unit price bid for the manhole.
DROP PIPE, when specified on the plans, shall be constructed as shown on MH-2.
SANITARY SEWER COVERS shall be without the pick and vent holes shown hereon and shall include a sealing gasket affixed to the bearing surface. Bolt-down covers shall not be used unless specified in the plans.

REVISIONS	DATE	
		TYPICAL MANHOLE DETAIL MH-1
		CHK. BY: C.A.H. EFFECTIVE DATE: 1-1-94
		BUTLER COUNTY ENGINEERS OFFICE AND OPERATIONS FACILITY 1921 FAIRGROVE AVENUE – HAMILTON, OHIO 45011 PHONE 867-5744

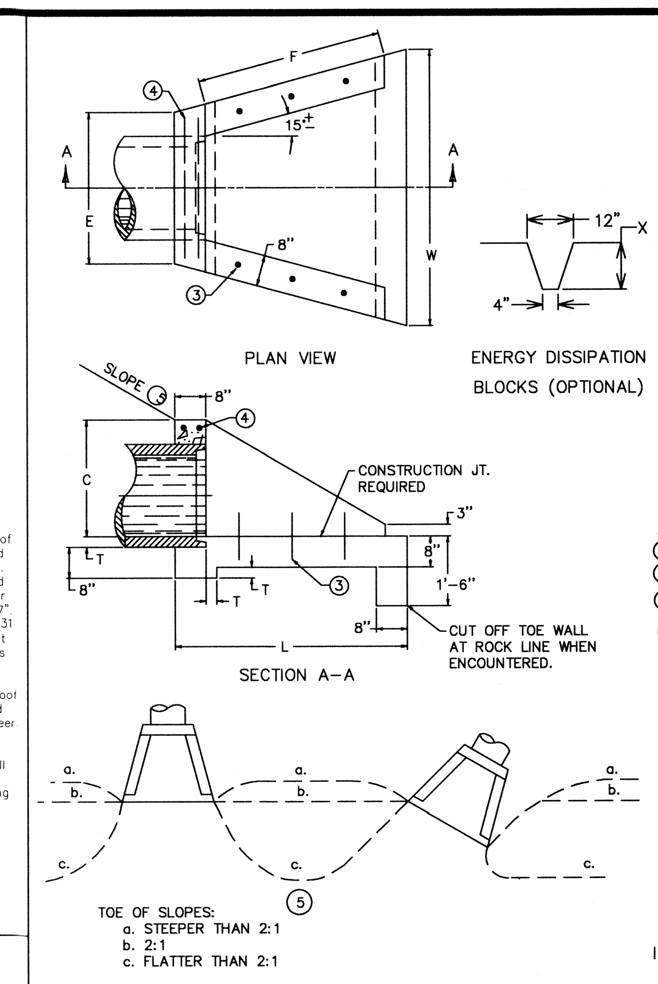

PLAN VIEW — ENERGY DISSIPATION BLOCKS (OPTIONAL) — SECTION A-A

TOE OF SLOPES:
a. STEEPER THAN 2:1
b. 2:1
c. FLATTER THAN 2:1

PIPE DIA. OR EQUIV. DIA.	SHAPE ⑨	C	E	F	L	W	T	X	CLASS A CONC C.Y.	REINF STEEL LBS.
12"	○	1'-9"	2'-6"	2'-3"	3'-6"	4'-0"	2"	12"	0.58	7
15"	○	2'-0"	2'-9"	2'-9"	4'-0"	4'-9"	2 1/4"	13 1/2"	0.75	
	⌓	1'-9"	3'-0"	2'-6"	3'-6"	4'-9"			0.68	
18"	○	2'-3"	3'-0"	3'-6"	4'-6"	5'-3"	2 1/2"	15"	0.93	8
	⌓ / ⬭	2'-0"	3'-6"	3'-0"	4'-0"	5'-6"	2 3/4"		0.89	
21"	○	2'-6"	3'-3"	4'-0"	5'-0"	6'-0"			1.14	
	⌓	2'-3"	3'-0"	3'-6"	4'-6"	6'-0"			1.07	9
24"	○	2'-9"	3'-6"	4'-6"	5'-6"	6'-6"	3"	18"	1.35	8
	⌓ / ⬭	2'-6"	4'-0"	4'-0"	5'-0"	6'-9"	3 1/4"		1.30	9
27"	○	3'-0"	3'-9"	5'-0"	6'-0"	7'-0"			1.57	
	⬭	2'-9"	4'-6"	4'-3"	5'-3"	7'-3"	3 1/2"		1.51	10

NOTES
1. DIMENSIONS AND QUANTITIES ARE BASED ON CONCRETE PIPE AND WILL VARY INSIGNIFICANTLY FOR CORRUGATED METAL PIPE.
2. REINFORCING STEEL : MINIMUM GRADE 40, BARS EVENLY SPACED.
③ 6 – NO. 4 x 1'-0" DOWEL BARS.
④ 2 – NO. 4 x (E DIMENSION MINUS 4").
⑤ SLOPES SHALL BE WARPED TO FIT HEADWALL WHEN PIPE IS SKEWED AND/OR NORMAL SLOPE VARIES FROM 2:1.
6. VOLUME DISPLACED BY PIPE COMPUTED USING INSIDE DIAMETER OF PIPE.
7. WING ANGLES AND/OR DIMENSIONS MAY BE ALTERED DURING CONSTRUCTION TO ACCOMMODATE FLOW OF WATER.
8. APRON BETWEEN WINGS SHALL BE SLOPED IN DIRECTION OF FLOW EQUAL TO SLOPE OF PIPE. FRONT FACE OF HEADWALL SHALL REMAIN VERTICAL.

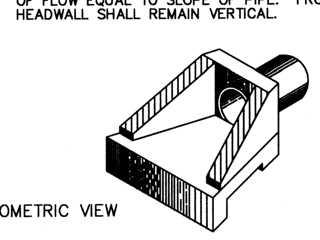

ISOMETRIC VIEW

12" – 27"
SLOPE/HILLSIDE
1921 FAIRGROVE AVENUE – HAMILTON, OHIO 45011 PHONE 867-5744 SHEET 1 OF 6

BILL OF REINFORCEMENT
30" TO 66" DIAMETER
CIRCULAR PIPE HEADWALLS
0°SKEW
CHK. BY: EJP EFFECTIVE DATE: 1-1-2010
BUTLER COUNTY ENGINEERS OFFICE AND OPERATIONS FACILITY
USE WITH SHEET 2 OF 6

MARK	SIZE	NO ①	LGTH FT	LGTH IN	K FT	K IN
30"						
A	5	4	4	8		
C1	4	2	2	4		
C2	4	2	4	2		
E1	5	2	6	4	3	4
E2	5	2	6	8	3	8
F	4	3	1	3	0	4
G1	4	2	3	10		
G2	4	3	6	2		
H	4	4	5	1	3	5
N	4	6	4	2		
Q	4	2	2	9		
R	4	3	0	8		
V1	5	4	3	1	1	10
V2	5	4	4	1	2	10
36"						
A	5	4	5	5		
C1	4	2	1	7		
C2	4	2	3	8		
C3	4	2	4	10		
E1	5	2	6	11	3	11
E2	5	2	7	3	4	3
F	4	4	1	3	0	4
G1	4	3	5	0		
G2	4	3	7	4		
H	4	5	5	8	4	0
N	4	6	4	10		
Q	4	2	3	4		
R	4	4	0	8		
V1	5	4	3	4	2	1
V2	5	4	4	4	3	1
V3	5	2	5	4	4	1
42"						
A	5	4	6	2		
C1	4	2	2	9		
C2	4	2	4	9		
C3	4	2	5	6		
E1	5	2	7	6	4	6
E2	5	2	7	10	4	10
F	4	4	1	3	0	4
G1	4	3	6	4		
G2	4	3	8	7		
H	4	5	6	3	4	7
N	4	6	5	6		
Q	4	2	3	11		
R	4	4	0	9		
V1	5	4	3	6	2	3
V2	5	4	4	6	3	3
V3	5	4	5	6	4	3
48"						
A	5	4	6	11		
C1	4	2	1	10		
C2	4	2	3	10		
C3	4	2	5	10		
C4	4	2	6	2		
E1	5	2	8	1	5	1
E2	5	2	8	5	5	5
F	4	5	1	3	0	4
G1	4	1	4	0		
G2	4	3	7	5		
G3	4	3	9	9		
H	4	6	6	10	5	2
N	4	6	6	2		
Q	4	2	4	6		
R	4	5	0	9		
V1	5	4	3	9	2	6
V2	5	4	4	9	3	6
V3	5	4	5	9	4	6
MARK	SIZE	NO ①	LGTH FT	LGTH IN	K FT	K IN
54"						
A	5	4	7	7		
C1	4	2	0	11		
C2	4	2	3	0		
C3	4	2	5	1		
C4	4	4	6	10		
E1	5	2	8	8	5	8
E2	5	2	9	0	6	0
F	4	6	1	3	0	4
G1	4	1	5	3		
G2	4	3	8	9		
G3	4	3	11	0		
H	4	6	7	5	5	9
N	4	6	6	10		
Q	4	2	5	1		
R	4	6	0	10		
V1	5	4	4	0	2	9
V2	5	4	5	0	3	9
V3	5	4	6	0	4	9
V4	5	2	7	0	5	9
60"						
A	5	4	8	4		
C1	4	2	2	1		
C2	4	2	4	2		
C3	4	2	6	3		
C4	4	4	7	7		
E1	5	2	9	3	6	3
E2	5	2	9	7	6	7
F	4	6	1	3	0	4
G1	4	2	6	6		
G2	4	3	10	0		
G3	4	3	12	4		
H	4	7	8	0	6	4
N	4	6	7	7		
Q	4	2	5	8		
R	4	6	0	10		
V1	5	4	4	3	3	0
V2	5	4	5	3	4	0
V3	5	4	6	2	4	11
V4	5	4	7	2	5	11
66"						
A	5	4	9	4		
B1	5	8	2	10		
B2	5	8	3	10		
B3	5	8	4	9		
B4	5	8	5	9		
C1	4	4	1	5		
C2	4	4	3	5		
C3	4	4	5	6		
C4	4	4	7	7		
C5	4	8	8	4		
E1	5	2	11	9	6	10
E2	5	2	12	3	7	4
F	4	7	1	9	0	6
G1	4	3	8	0		
G2	4	3	11	4		
G3	4	3	13	10		
H	4	7	9	3	7	1
M	4	16	3	9		
N	4	14	8	4		
P	5	16	5	0	3	3
Q	5	3	6	2		
R	5	7	2	7		

NOTES
①NUMBER OF BARS IN ONE HEADWALL.
2 DIMENSIONS ARE O. TO O. OF BARS.
3 ALL BARS ARE STRAIGHT EXCEPT THOSE SHOWN BELOW.

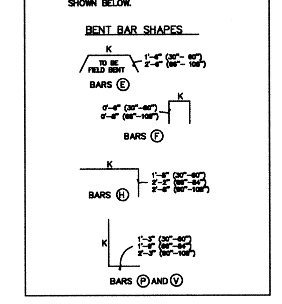

BENT BAR SHAPES — BARS Ⓔ — BARS Ⓕ — BARS Ⓗ — BARS Ⓟ AND Ⓥ

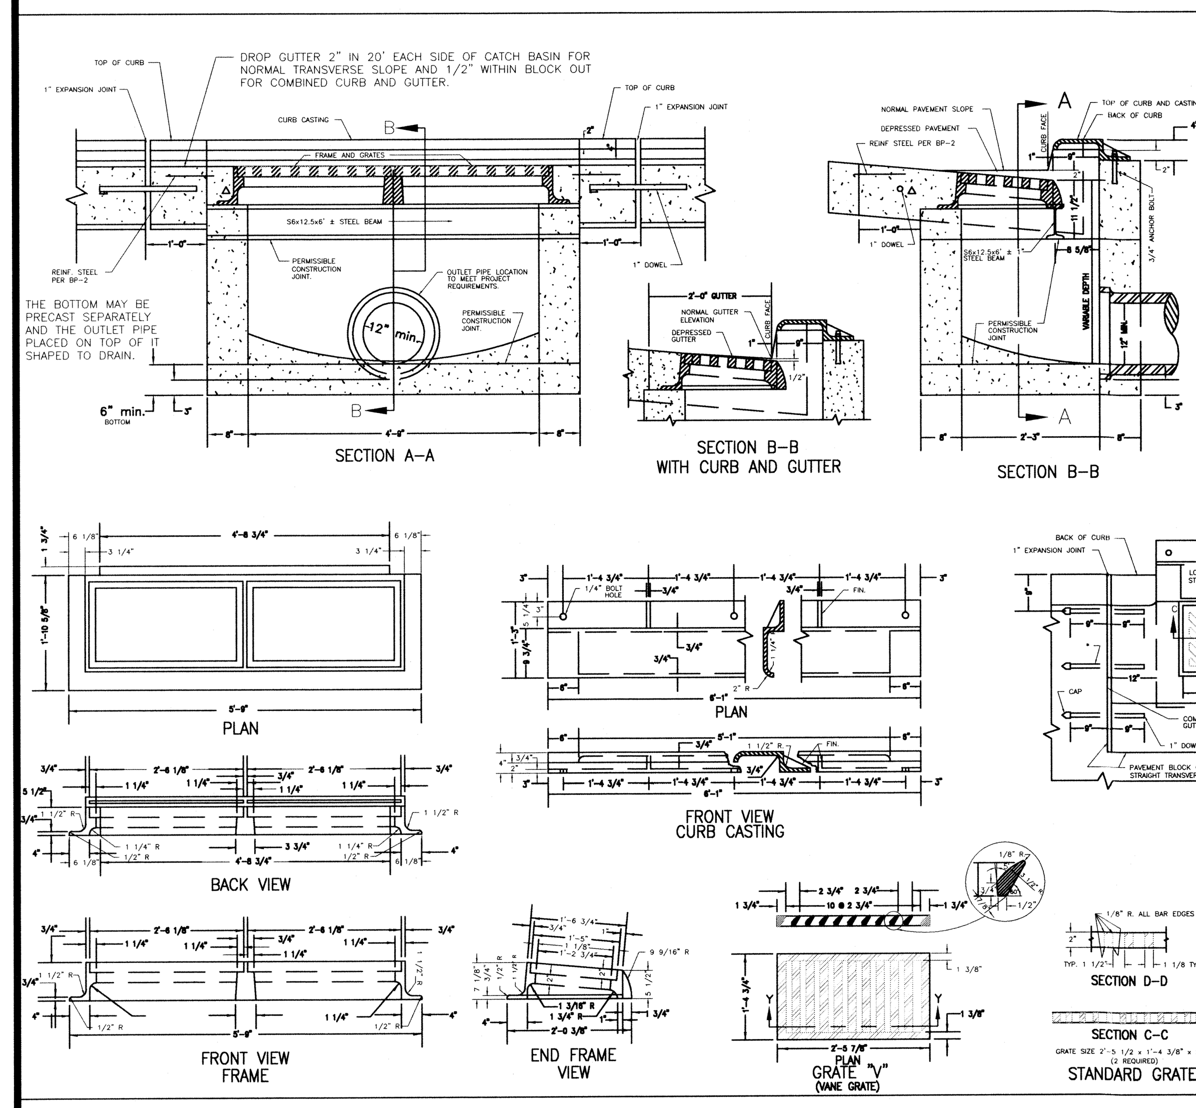

SECTION A-A — SECTION B-B — SECTION B-B WITH CURB AND GUTTER — PLAN — BACK VIEW — FRONT VIEW CURB CASTING — FRONT VIEW FRAME — END FRAME VIEW — GRATE "V" (VANE GRATE) — SECTION D-D — SECTION C-C — STANDARD GRATE
GRATE SIZE 2'-5 1/2 x 1'-4 3/8" x 2" (2 REQUIRED)

PLAN OF CATCH BASIN AND PAVEMENT JOINTS
* DOWEL LOCATION FOR CURB AND GUTTER

NOTES

GRATES:
STANDARD GRATE AS SHOWN IN THE PLAN VIEW SHALL BE PROVIDED UNLESS THE PLANS SPECIFICALLY REQUIRE GRATE "V". PLACE GRATE SO THE DIAGONAL BARS DIRECT DRAINAGE FLOW TOWARD THE CURB. ALL BAR EDGES TO BE ROUNDED 1/8" RADIUS.
CASTINGS:
THE DESIGN SHALL BE ESSENTIALLY THE SAME AND EQUALLY AS STRONG AS THOSE SHOWN HERON. MINIMUM WEIGHTS ARE: CURB CASTING 305 LBS., TWO GRATES 254LBS., FRAME 590 LBS., AND TWO "V" GRATES 210 LBS. BEARING AREAS OF FRAME AND GRATE SHALL BE SO FITTED AND FINISHED, WITHOUT PROJECTIONS, AS TO PROVIDE A FIRM AND EVEN SEAT FOR ALL PORTIONS OF THE GRATE IN THE FRAME WITHOUT ROCKING.
DOWELS: FOUR 1" x 18" ARE REQUIRED FOR CONCRETE PAVEMENT OF GUTTER BLOCKOUT. SEE ODOT BP-4 FOR DOWEL DETAILS.
BRICK OR CONCRETE BLOCK: SIDE WALLS WHEN USED IN PLACE OF CONCRETE, SHALL BE 8" NOMINAL THICKNESS.
BLOCKOUT: SHALL BE PAVED WITH CLASS C CONCRETE IN PCC PAVEMENT OR GUTTER AND PAID FOR AS PART OF THE PAVEMENT OR GUTTER WITH NO DEDUCTION IN PAVEMENT, CURB OR GUTTER QUANTITIES BECAUSE OF CASTINGS. A CLASS C CONCRETE APRON THE SIZE OF THE 2' GUTTER BLOCKOUT SHALL BE CAST IN PLACE IN ASPHALT PAVEMENT (NO DOWELS REQUIRED) WITH THE COST INCLUDED IN THE CATCH BASIN BID PRICE. NO DEDUCTIN TO BE MADE IN CURB QUANTITIES.
PRECAST: CONSTRUCTION IS PERMITTED, EXCEPT FOR APRON, AND CONCRETE SHALL MEET REQUIREMENTS OF 706.13 WITH 6± 2% AIR VOID CONTENT IN THE HARDENED CONCRETE. PRECAST WALLS SHALL HAVE A MINIMUM THICKNESS OF 6" AND REINFORCING SHALL BE SUFFICIENT TO PERMIT SHIPPING AND PLACEMENT WITHOUT DAMAGE.
STEPS: STEPS ARE TO BE INSTALLED IN STORM STRUCTURES OVER 4' IN DEPTH AND SHALL MEET THE REQUIREMENTS OF DRAWINGS MH-1.

REVISIONS	DATE	C-6
		CATCH BASIN NO. 3
		CHK. BY: C.A.H. EFFECTIVE DATE: 1-1-94
		BUTLER COUNTY ENGINEERS OFFICE AND OPERATIONS FACILITY 1921 FAIRGROVE AVENUE – HAMILTON, OHIO 45011 PHONE 867-5744

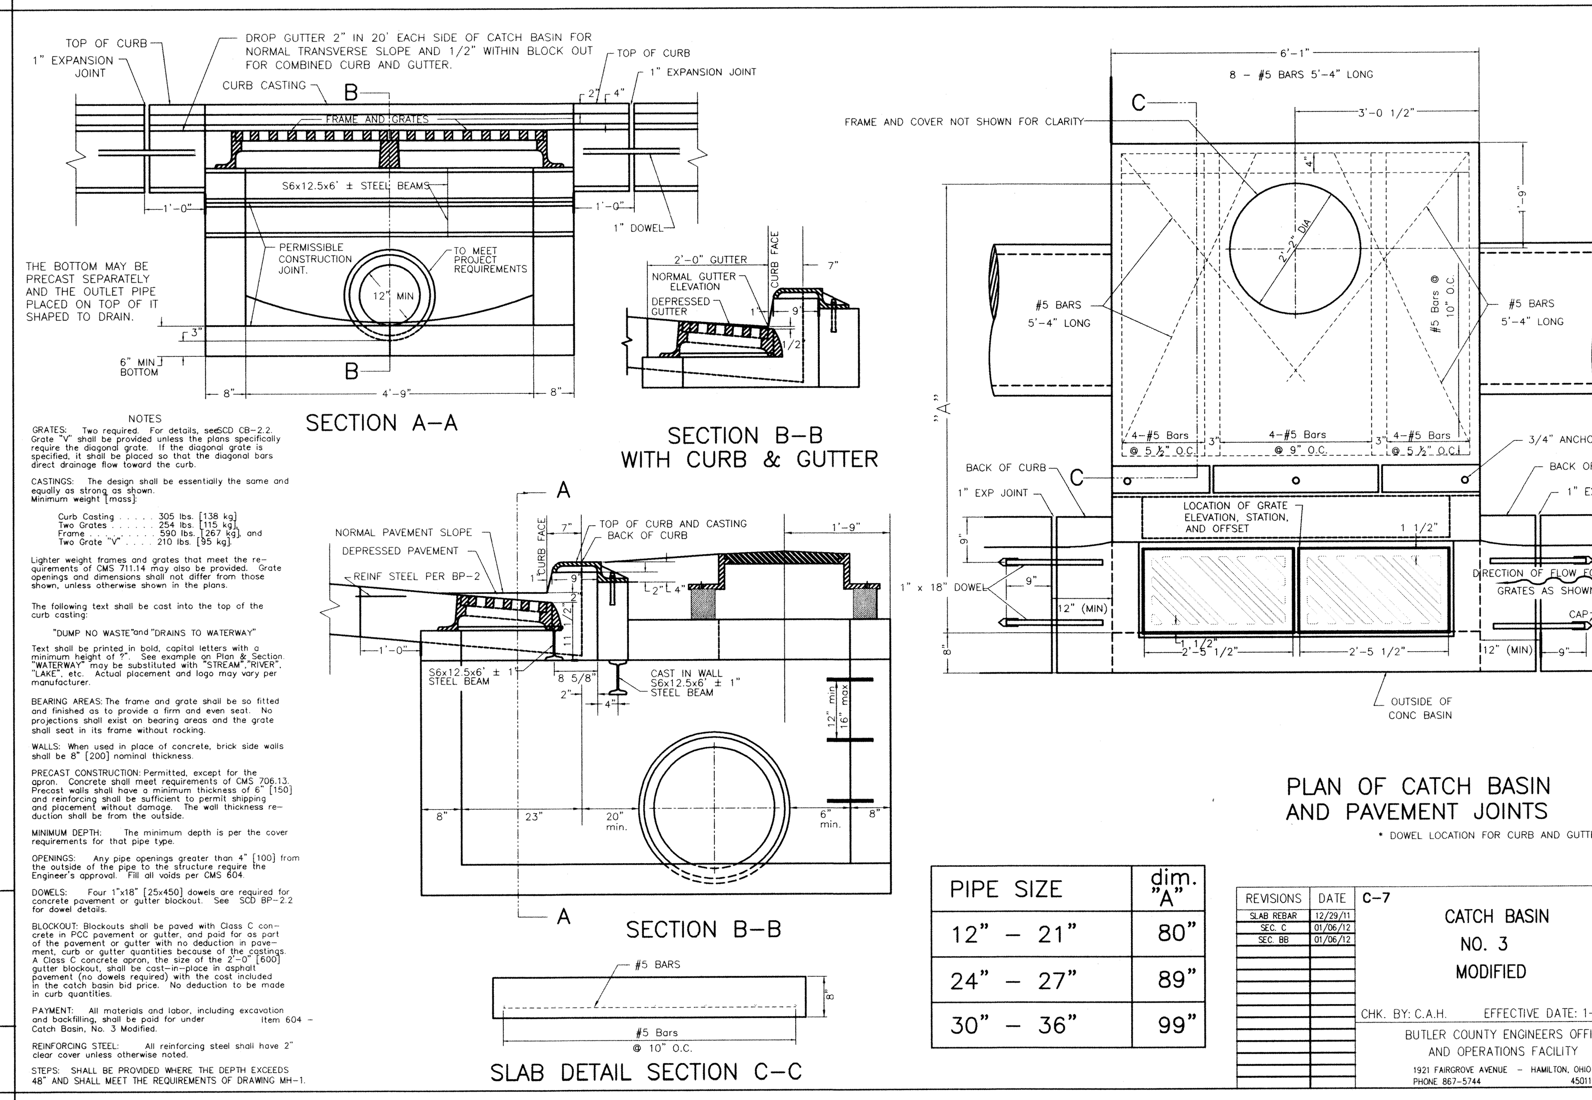

SECTION A-A — SECTION B-B WITH CURB & GUTTER — SECTION B-B — SLAB DETAIL SECTION C-C

PLAN OF CATCH BASIN AND PAVEMENT JOINTS
* DOWEL LOCATION FOR CURB AND GUTTER

NOTES
GRATES: Two required. For details, seeSCD CB-2.2. Grate "V" shall be provided unless the plans specifically require the diagonal grate. If the diagonal grate is specified, it shall be placed so that the diagonal bars direct drainage flow toward the curb.
CASTINGS: The design shall be essentially the same and equally as strong as shown. Minimum weight [mass]:
Curb Casting . . . . . 305 lbs. [138 kg]
Two Grates . . . . . 254 lbs. [115 kg]
Frame . . . . . 590 lbs. [267 kg], and
Two Grate "V" . . . . 210 lbs. [95 kg]
Lighter weight frames and grates that meet the requirements of CMS 711.14 may also be provided. Grate openings and dimensions shall not differ from those shown, unless otherwise shown in the plans.
The following text shall be cast into the top of the curb casting:
"DUMP NO WASTE" and "DRAINS TO WATERWAY"
Text shall be printed in bold, capital letters with a minimum height of ?". See example on Plan & Section. "WATERWAY" may be substituted with "STREAM", "RIVER", "LAKE", etc. Actual placement and logo may vary per manufacturer.
BEARING AREAS: The frame and grate shall be so fitted and finished as to provide a firm and even seat. No projections shall exist on bearing areas and the grate shall seat in its frame without rocking.
WALLS: When used in place of concrete, brick side walls shall be 8" [200] nominal thickness.
PRECAST CONSTRUCTION: Permitted, except for the apron. Concrete shall meet requirements of CMS 706.13. Precast walls shall have a minimum thickness of 6" [150] and reinforcing shall be sufficient to permit shipping and placement without damage. The wall thickness reduction shall be from the outside.
MINIMUM DEPTH: The minimum depth is per the cover requirements for that pipe type.
OPENINGS: Any pipe openings greater than 4" [100] from the outside of the pipe to the structure require the Engineer's approval. Fill all voids per CMS 604.
DOWELS: Four 1"x18" [25x450] dowels are required for concrete pavement or gutter blockout. See SCD BP-2.2 for dowel details.
BLOCKOUT: Blockouts shall be paved with Class C concrete in PCC pavement or gutter, and paid for as part of the pavement or gutter with no deduction in pavement, curb or gutter quantities because of the castings. A Class C concrete apron, the size of the 2'-0" [600] gutter blockout, shall be cast-in-place in asphalt pavement (no dowels required) with the cost included in the catch basin bid price. No deduction to be made in curb quantities.
PAYMENT: All materials and labor, including excavation and backfilling, shall be paid for under Item 604 – Catch Basin, No. 3 Modified.
REINFORCING STEEL: All reinforcing steel shall have 2" clear cover unless otherwise noted.
STEPS: SHALL BE PROVIDED WHERE THE DEPTH EXCEEDS 48" AND SHALL MEET THE REQUIREMENTS OF DRAWING MH-1.

PIPE SIZE	dim. "A"
12" – 21"	80"
24" – 27"	89"
30" – 36"	99"

REVISIONS	DATE	C-7
SLAB REBAR	12/29/11	CATCH BASIN NO. 3 MODIFIED
SEC. C	01/06/12	
SEC. BB	01/06/12	
		CHK. BY: C.A.H. EFFECTIVE DATE: 1-1-94
		BUTLER COUNTY ENGINEERS OFFICE AND OPERATIONS FACILITY 1921 FAIRGROVE AVENUE – HAMILTON, OHIO 45011 PHONE 867-5744

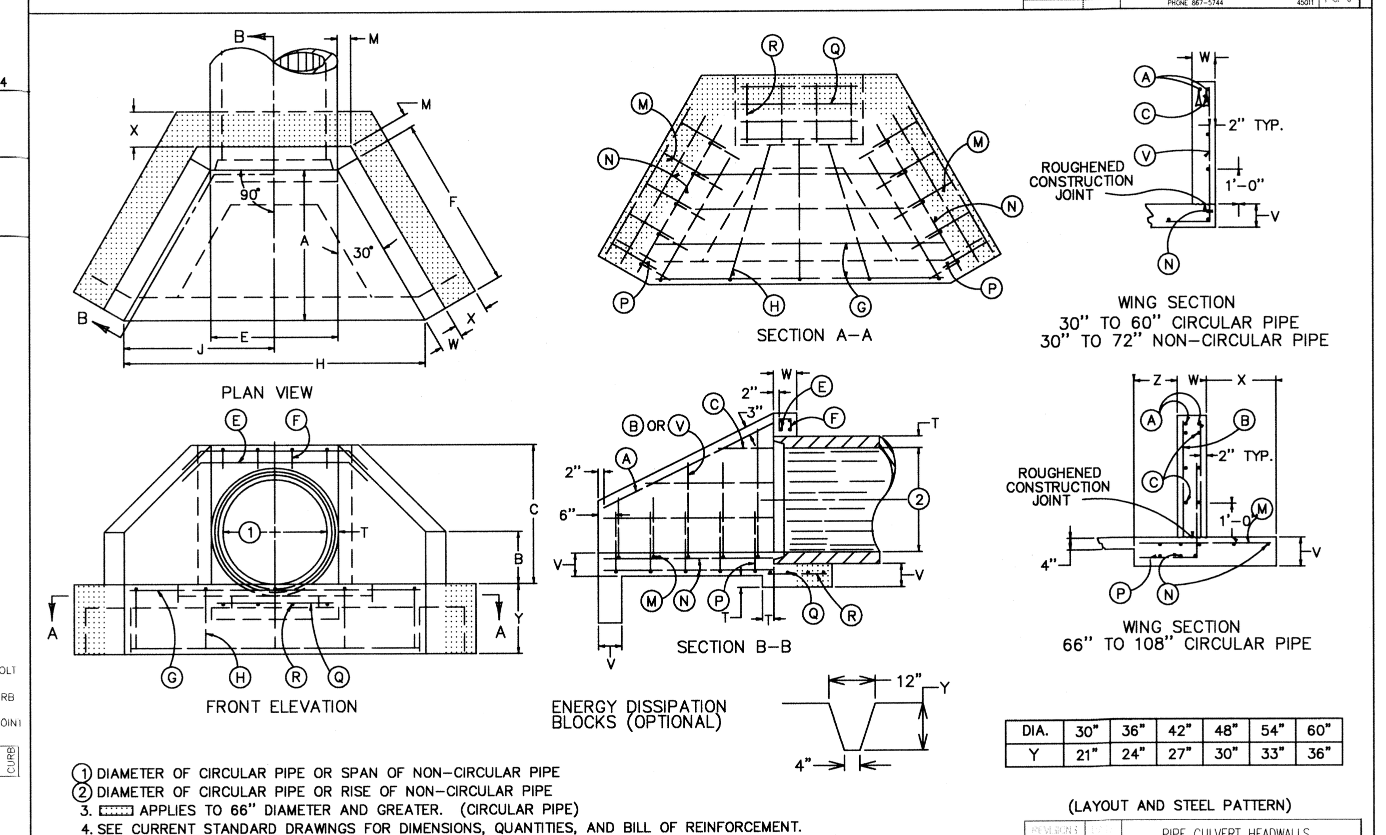

PLAN VIEW — SECTION A-A — FRONT ELEVATION — SECTION B-B — WING SECTION 30" TO 60" CIRCULAR PIPE 30" TO 72" NON-CIRCULAR PIPE — WING SECTION 66" TO 108" CIRCULAR PIPE — ENERGY DISSIPATION BLOCKS (OPTIONAL)

DIA.	30"	36"	42"	48"	54"	60"
Y	21"	24"	27"	30"	33"	36"

① DIAMETER OF CIRCULAR PIPE OR SPAN OF NON-CIRCULAR PIPE
② DIAMETER OF CIRCULAR PIPE OR RISE OF NON-CIRCULAR PIPE
3. ⬚ APPLIES TO 66" DIAMETER AND GREATER. (CIRCULAR PIPE)
4. SEE CURRENT STANDARD DRAWINGS FOR DIMENSIONS, QUANTITIES, AND BILL OF REINFORCEMENT.
5. DIMENSIONS FROM FACE OF CONCRETE TO STEEL SHALL BE 2" CLEAR DISTANCE.
6. ENCIRCLED LETTERS, ◯, INDICATE STEEL BAR LOCATIONS
7. BARS Ⓑ, Ⓒ, Ⓖ, Ⓟ, Ⓜ, Ⓥ ARE SPACED 1'-0" O.C. ALL OTHER BARS SHALL BE EVENLY SPACED.
8. BARS Ⓑ AND Ⓥ ARE PLACED IN ORDER OF INCREASING LENGTHS, BEGINNING AT THE END OF EACH WING.
9. BARS Ⓒ ARE PLACED IN ORDER OF INCREASING LENGTHS, BEGINNING AT THE TOP OF EACH WING.
10. HEADWALLS LOCATED AT EDGE OF SHOULDER SHALL BE PARALLEL TO CENTERLINE OF THE ROAD.
11. APRON BETWEEN WINGS SHALL BE SLOPED IN DIRECTION OF FLOW EQUAL TO SLOPE OF PIPE. FRONT FACE OF HEADWALL AND ENDS OF WINGS SHALL REMAIN VERTICAL.

(LAYOUT AND STEEL PATTERN)
PIPE CULVERT HEADWALLS
0 SKEW
30" – 66"
1921 FAIRGROVE AVENUE – HAMILTON, OHIO 45011 PHONE 867-5744 SHEET 2 OF 6

DIMENSION	30"	36"	42"	48"	54"	60"	66"	DIMENSION
A	3'-9"	4'-4"	4'-11"	5'-6"	6'-1"	6'-8"	7'-5"	A
B	1'-3"	1'-6"	1'-9"	2'-0"	2'-3"	2'-6"	2'-9"	B
C	3'-6"	4'-0"	4'-7"	5'-1"	5'-8"	6'-2"	7'-0"	C
E	3'-1"	3'-8"	4'-3"	4'-10"	5'-5"	6'-0"	6'-7"	E
F	4'-4"	5'-0"	5'-8"	6'-4"	7'-0"	7'-8"	8'-7"	F
H	7'-6"	8'-8"	10'-0"	11'-2"	12'-6"	13'-8"	15'-2"	H
J	3'-9"	4'-4"	5'-0"	5'-7"	6'-3"	6'-10"	7'-7"	J
M	0'-5"						0'-6"	M
T	0'-3.5"	0'-4.0"	0'-4.5"	0'-5.0"	0'-5.5"	0'-6.0"	0'-6.5"	T
V	0'-8"						1'-0"	V
W	0'-8"						0'-10"	W
X	----						2'-0"	X
Y	2'-0"						2'-6"	Y
Z	----						1'-3"	Z
CU.YDS.CONC. 2 HEADWALLS	3.36	4.30	5.35	6.53	7.82	9.22	18.76	CU.YDS.CONC. 2 HEADWALLS
LBS.STEEL 2 HEADWALLS	281	363	430	496	583	687	1320	LBS.STEEL 2 HEADWALLS

DIMENSIONS AND QUANTITIES ARE BASED ON CONCRETE PIPE AND WILL VARY SLIGHTLY FOR CORRUGATED METAL PIPE.

USE WITH SHEET 2 OF 6
DIMENSIONS & QUANTITIES
30"-66" HEADWALLS
CIRCULAR PIPE, 0 SKEW
CHK. BY: EJP EFFECTIVE DATE: 1-1-2010
BUTLER COUNTY ENGINEERS OFFICE AND OPERATIONS FACILITY
SHEET 3 OF 6

NOTE:
FOR ADDITIONAL SPECIFICATIONS ON SIZING AND BILL OF REINFORCEMENT FOR NON-CIRCULAR PIPES, SEE COMPLETE 6 PAGE DETAIL C-13A IN APPENDIX C OF THE BUTLER COUNTY SUBDIVISION REGULATIONS

REVISIONS	DATE	C-13A
		HILLSIDE HEADWALLS
		BUTLER COUNTY ENGINEERS OFFICE AND OPERATIONS FACILITY 1921 FAIRGROVE AVENUE – HAMILTON, OHIO 45011 PHONE 867-5744

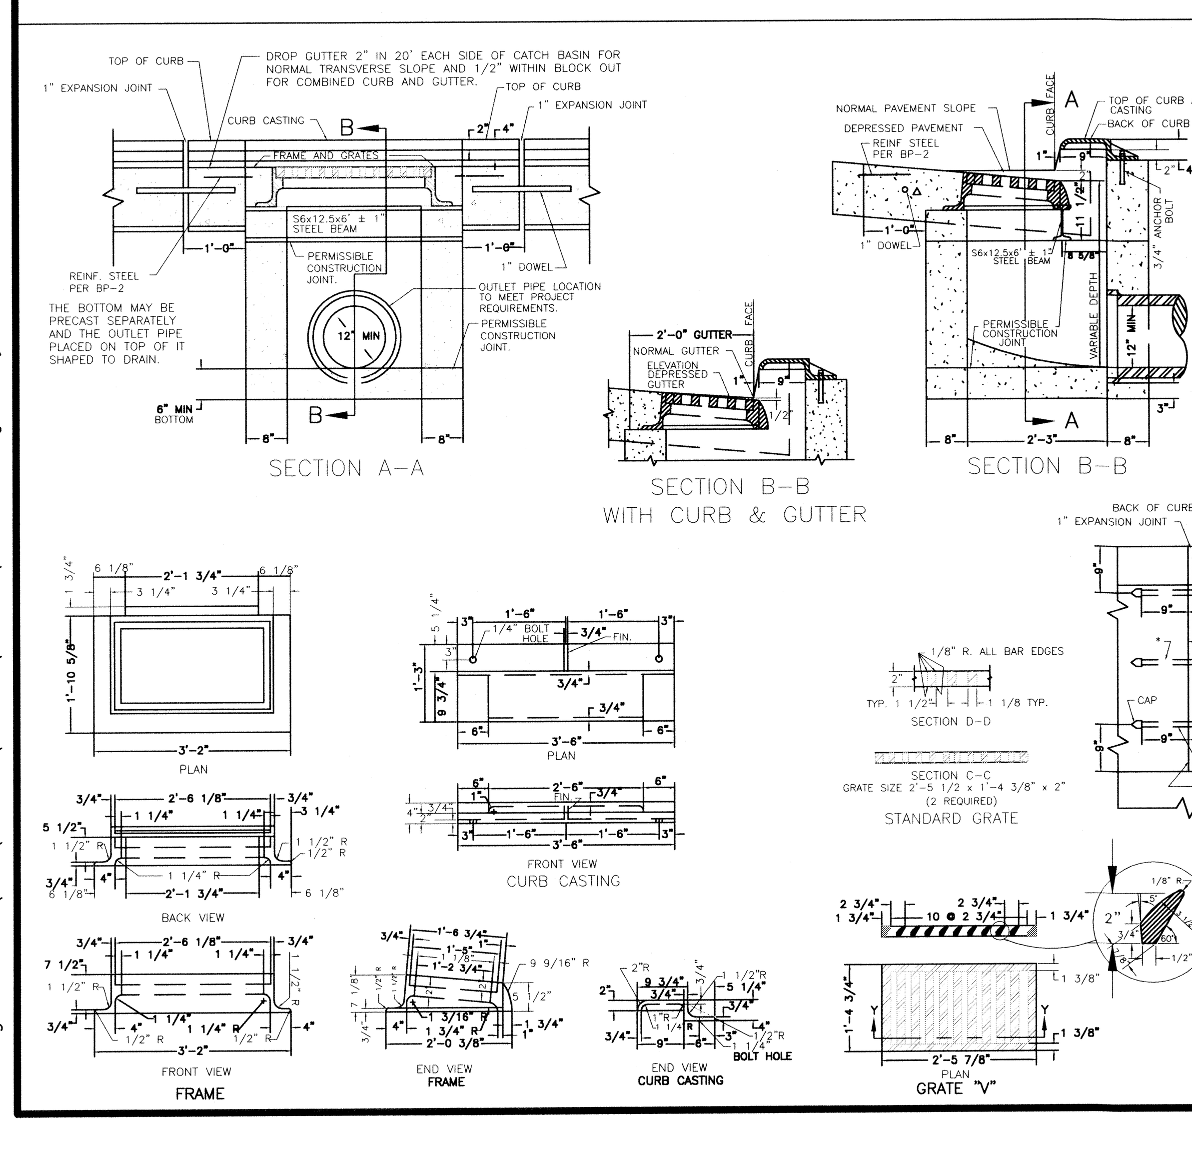

SECTION A-A — SECTION B-B WITH CURB & GUTTER — SECTION B-B — PLAN — BACK VIEW — FRONT VIEW CURB CASTING — FRONT VIEW FRAME — END VIEW FRAME — END VIEW CURB CASTING — PLAN GRATE "V" — SECTION D-D — SECTION C-C — STANDARD GRATE
GRATE SIZE 2'-5 1/2 x 1'-4 3/8" x 2" (2 REQUIRED)

PLAN OF CATCH BASIN AND PAVEMENT JOINTS
* DOWEL LOCATION FOR CURB AND GUTTER

NOTES

GRATES:
STANDARD GRATE AS SHOWN IN THE PLAN VIEW SHALL BE PROVIDED UNLESS THE PLANS SPECIFICALLY REQUIRE GRATE "V". PLACE GRATE SO THE DIAGONAL BARS DIRECT DRAINAGE FLOW TOWARD THE CURB. ALL BAR EDGES TO BE ROUNDED 1/8" RADIUS.
CASTINGS:
THE DESIGN SHALL BE ESSENTIALLY THE SAME AND EQUALLY AS STRONG AS THOSE SHOWN HERON. MINIMUM WEIGHTS ARE: CURB CASTING 170 LBS., STANDARD GRATE 127 LBS., FRAME 320 LBS., AND "V" GRATE 105 LBS. BEARING AREAS OF FRAME AND GRATE SHALL BE SO FITTED AND FINISHED AS TO PROVIDE A FIRM AND EVEN SEAT FOR ALL PORTIONS OF THE GRATE IN THE FRAME NO PROJECTIONS SHALL EXIST ON BEARING AREAS OF EITHER CASTING AND THE GRATE WITHOUT ROCKING.
DOWELS: FOUR 1" x 18" ARE REQUIRED FOR CONCRETE PAVEMENT OF GUTTER BLOCKOUT. SEE ODOT BP-4 FOR DOWEL DETAILS.
BRICK OR CONCRETE BLOCK SIDE WALLS WHEN USED IN PLACE OF CONCRETE, SHALL BE 8" NOMINAL THICKNESS.
BLOCKOUT SHALL BE PAVED WITH CLASS C CONCRETE IN PCC PAVEMENT OR GUTTER AND PAID FOR AS PART OF THE PAVEMENT OR GUTTER WITH NO DEDUCTION IN PAVEMENT, CURB OR GUTTER QUANTITIES BECAUSE OF CASTINGS. A CLASS C CONCRETE APRON THE SIZE OF THE 2' GUTTER BLOCKOUT SHALL BE CAST IN PLACE IN ASPHALT PAVEMENT (NO DOWELS REQUIRED) WITH THE COST INCLUDED IN THE CATCH BASIN BID PRICE. NO DEDUCTIN TO BE MADE IN CURB QUANTITIES.
PRECAST CONSTRUCTION IS PERMITTED, EXCEPT FOR APRON, AND CONCRETE SHALL MEET REQUIREMENTS OF 706.13 WITH 6± 2% AIR VOID CONTENT IN THE HARDENED CONCRETE. PRECAST WALLS SHALL HAVE A MINIMUM THICKNESS OF 6" AND REINFORCING SHALL BE SUFFICIENT TO PERMIT SHIPPING AND PLACEMENT WITHOUT DAMAGE.
STEPS STEPS ARE TO BE INSTALLED IN STORM STRUCTURES OVER 4' IN DEPTH AND SHALL MEET THE REQUIREMENTS OF DRAWING MH-1.

REVISIONS	DATE	C-8
		CATCH BASIN NO. 3A
		CHK. BY: C.A.H. EFFECTIVE DATE: 1-1-94
		BUTLER COUNTY ENGINEERS OFFICE AND OPERATIONS FACILITY 1921 FAIRGROVE AVENUE – HAMILTON, OHIO 45011 PHONE 867-5744

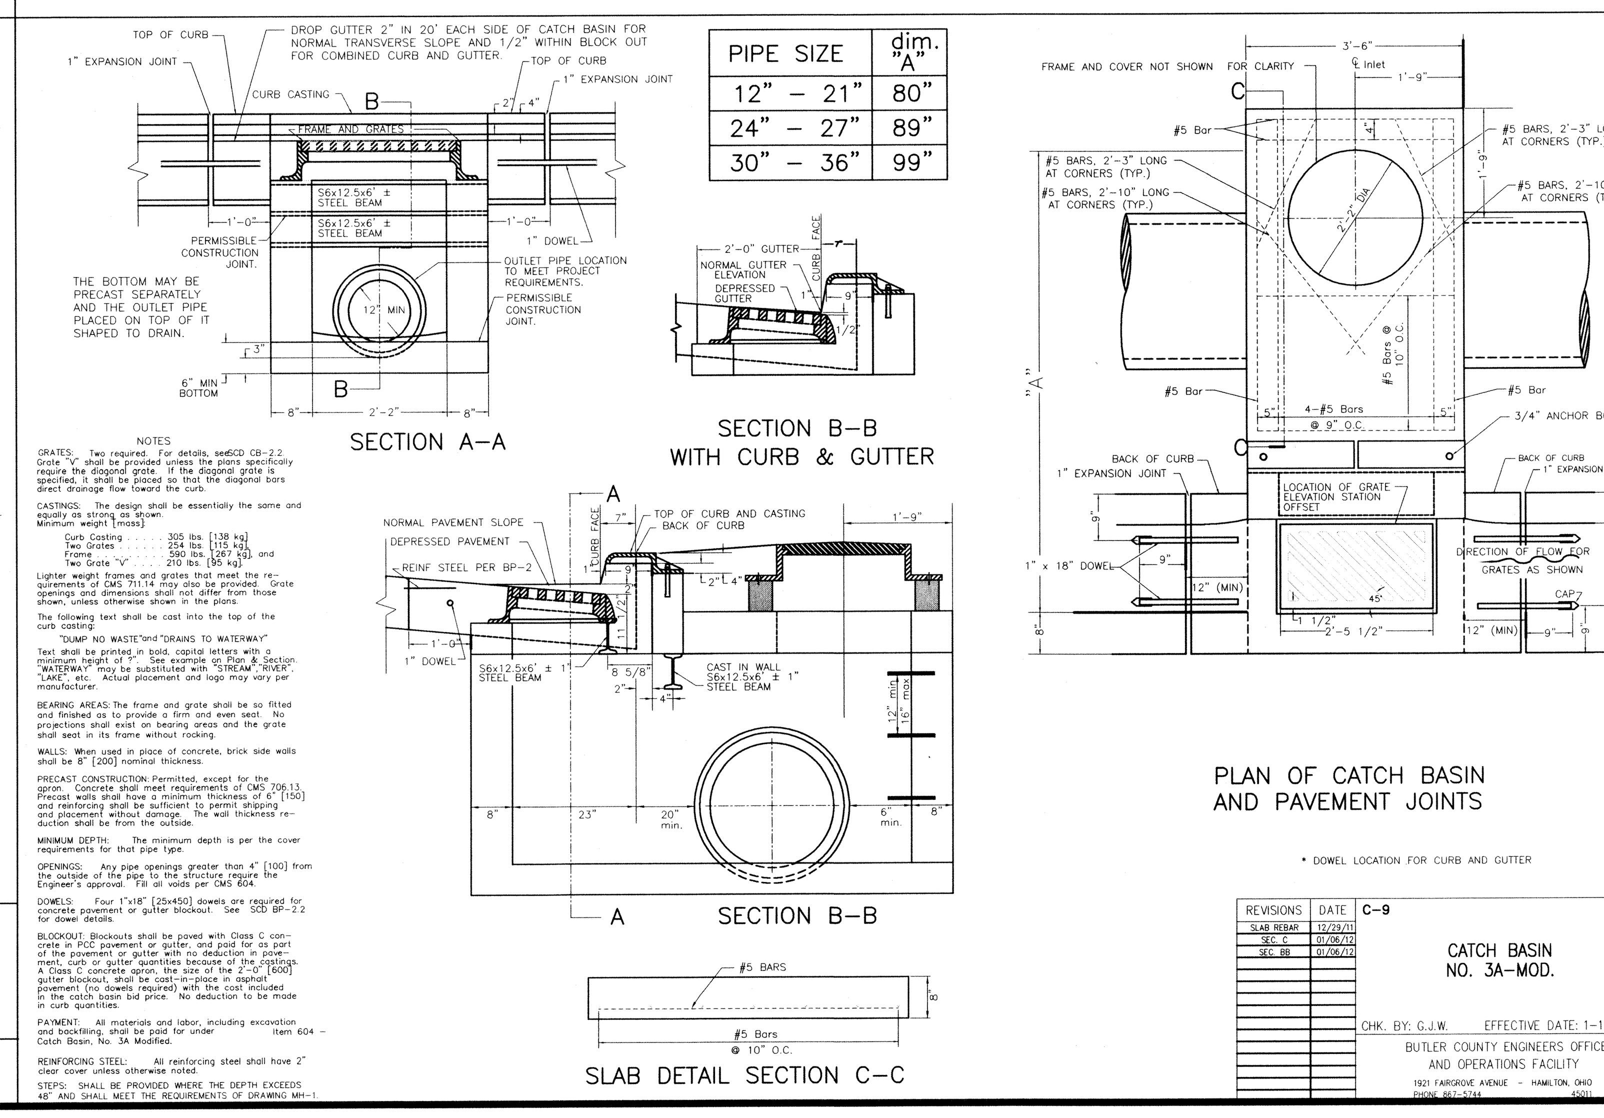

SECTION A-A — SECTION B-B WITH CURB & GUTTER — SECTION B-B — SLAB DETAIL SECTION C-C

PIPE SIZE	dim. "A"
12" – 21"	80"
24" – 27"	89"
30" – 36"	99"

PLAN OF CATCH BASIN AND PAVEMENT JOINTS
* DOWEL LOCATION FOR CURB AND GUTTER

NOTES
GRATES: Two required. For details, seeSCD CB-2.2. Grate "V" shall be provided unless the plans specifically require the diagonal grate. If the diagonal grate is specified, it shall be placed so that the diagonal bars direct drainage flow toward the curb.
CASTINGS: The design shall be essentially the same and equally as strong as shown. Minimum weight [mass]:
Curb Casting . . . . . 305 lbs. [138 kg]
Two Grates . . . . . 254 lbs. [115 kg]
Frame . . . . . 590 lbs. [267 kg], and
Two Grate "V" . . . . 210 lbs. [95 kg]
Lighter weight frames and grates that meet the requirements of CMS 711.14 may also be provided. Grate openings and dimensions shall not differ from those shown, unless otherwise shown in the plans.
The following text shall be cast into the top of the curb casting:
"DUMP NO WASTE" and "DRAINS TO WATERWAY"
Text shall be printed in bold, capital letters with a minimum height of ?". See example on Plan & Section. "WATERWAY" may be substituted with "STREAM", "RIVER", "LAKE", etc. Actual placement and logo may vary per manufacturer.
BEARING AREAS: The frame and grate shall be so fitted and finished as to provide a firm and even seat. No projections shall exist on bearing areas and the grate shall seat in its frame without rocking.
WALLS: When used in place of concrete, brick side walls shall be 8" [200] nominal thickness.
PRECAST CONSTRUCTION: Permitted, except for the apron. Concrete shall meet requirements of CMS 706.13. Precast walls shall have a minimum thickness of 6" [150] and reinforcing shall be sufficient to permit shipping and placement without damage. The wall thickness reduction shall be from the outside.
MINIMUM DEPTH: The minimum depth is per the cover requirements for that pipe type.
OPENINGS: Any pipe openings greater than 4" [100] from the outside of the pipe to the structure require the Engineer's approval. Fill all voids per CMS 604.
DOWELS: Four 1"x18" [25x450] dowels are required for concrete pavement or gutter blockout. See SCD BP-2.2 for dowel details.
BLOCKOUT: Blockouts shall be paved with Class C concrete in PCC pavement or gutter, and paid for as part of the pavement or gutter with no deduction in pavement, curb or gutter quantities because of the castings. A Class C concrete apron, the size of the 2'-0" [600] gutter blockout, shall be cast-in-place in asphalt pavement (no dowels required) with the cost included in the catch basin bid price. No deduction to be made in curb quantities.
PAYMENT: All materials and labor, including excavation and backfilling, shall be paid for under Item 604 – Catch Basin, No. 3A Modified.
REINFORCING STEEL: All reinforcing steel shall have 2" clear cover unless otherwise noted.
STEPS: SHALL BE PROVIDED WHERE THE DEPTH EXCEEDS 48" AND SHALL MEET THE REQUIREMENTS OF DRAWING MH-1.

REVISIONS	DATE	C-9
SLAB REBAR	12/29/11	CATCH BASIN NO. 3A-MOD.
SEC. C	01/06/12	
SEC. BB	01/06/12	
		CHK. BY: G.J.W. EFFECTIVE DATE: 1-1-94
		BUTLER COUNTY ENGINEERS OFFICE AND OPERATIONS FACILITY 1921 FAIRGROVE AVENUE – HAMILTON, OHIO 45011 PHONE 867-5744

STANDARD

D DIAM OF PIPE	L LENGTH HEAD WALL	A BARS NO.	A BARS LENGTH	B BARS NO.	B BARS LENGTH	LBS.	REINF. C.Y.	PLAIN C.Y.
12"	4'-0"	8	4'-0"	8	3'-6"	40	1.3	2.1
15"	5'-0"	8	4'-3"	8	4'-6"	47	1.7	2.7
18"	5'-9"	8	4'-6"	8	5'-3"	52	2.0	3.3
21"	6'-9"	8	4'-9"	8	6'-3"	59	2.4	4.0
24"	7'-6"	8	5'-0"	8	7'-0"	64	2.8	4.6
27"	8'-6"	8	5'-3"	8	8'-0"	71	3.3	5.5
30"	9'-3"	8	5'-6"	8	8'-9"	76	3.8	6.2
33"	10'-3"	8	5'-9"	8	9'-9"	83	4.3	7.2
36"	11'-0"	8	6'-0"	8	10'-6"	88	4.8	8.0

(QUANTITIES IN TWO HEADWALLS)

HEADWALLS FOR PIPES HAVING A DIAMETER GREATER THAN 36 INCHES SHALL BE DESIGNED AS A CANTILEVER OR GRAVITY TYPE WALL.

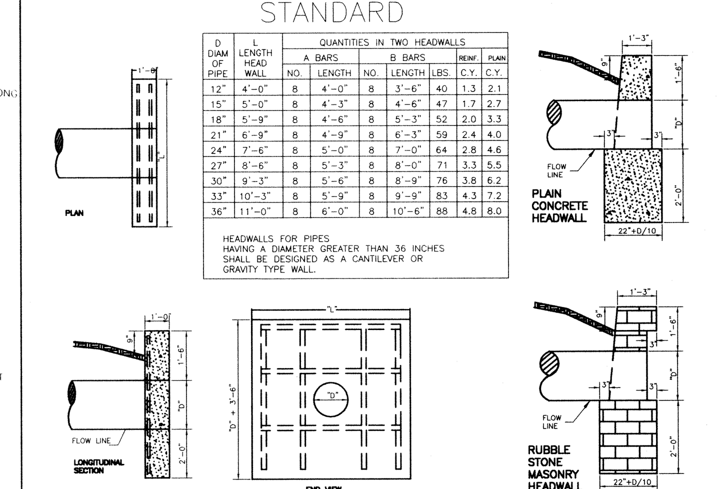

PLAN — LONGITUDINAL SECTION — END VIEW — PLAIN CONCRETE HEADWALL — RUBBLE STONE MASONRY HEADWALL ALTERNATE DESIGN

REINFORCED CONCRETE HEADWALL

HILLSIDE

D DIAM OF PIPE	Inlet A BARS NO.	Inlet A BARS LENGTH	Inlet B BARS NO.	Inlet B BARS LENGTH	Inlet D BARS NO.	Inlet D BARS LENGTH	Inlet STEEL LBS.	Inlet CONC. C.Y.	Outlet A BARS NO.	Outlet A BARS LENGTH	Outlet B BARS NO.	Outlet B BARS LENGTH	Outlet C BARS NO.	Outlet C BARS LENGTH	Outlet STEEL LBS.	Outlet CONC. C.Y.
12"	4	3'-6"	2	4'-0"	1	12'-6"	23	1.8	2	3'-6"	3	4'-0"	1	6'-0"	17	0.9
15"	4	3'-9"	2	4'-3"	1	12'-6"	24	1.9	2	3'-9"	3	4'-3"	1	6'-0"	18	1.0
18"	4	4'-0"	2	4'-6"	1	12'-6"	25	2.0	2	4'-0"	3	4'-6"	1	6'-0"	18	1.0
21"	4	4'-3"	2	4'-9"	1	12'-6"	26	2.1	2	4'-3"	3	4'-9"	1	6'-0"	19	1.1
24"	4	4'-6"	2	5'-0"	1	12'-6"	27	2.2	2	4'-6"	3	5'-0"	1	6'-0"	20	1.1

(Inlet = QUANTITIES IN ONE INLET WALL; Outlet = QUANTITES IN ONE OUTLET WALL)

NOTES
REINFORCING STEEL PROVIDED FOR ON THIS DRAWING SHALL BE 1/2" ROUND BARS OR BARS OF EQUIVLENT AREA.
CONCRETE FOR HEADWALLS SHALL BE CLASS "C".

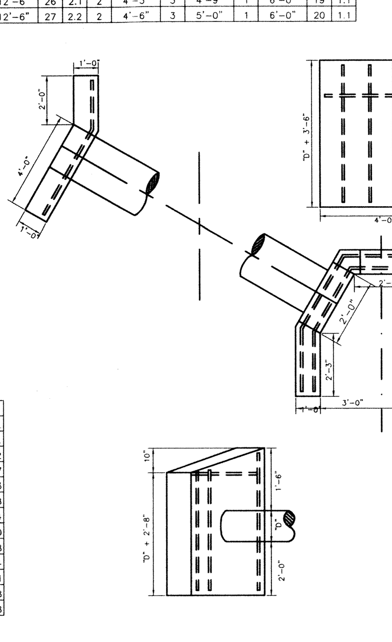

SIDE ROAD

D DIAM OF PIPE	L-1	L-2	H	A BARS NO.	A BARS LENGTH	B BARS NO.	B BARS LENGTH	C BARS NO.	C BARS LENGTH	STEEL LBS.	CONC. C.Y.
12"	2'-6"	1'-6"	4'-6"	2	6'-0"	2	7'-0"	16	4'-0"	60	2.2
15"	3'-0"	2'-0"	4'-9"	2	7'-0"	2	8'-0"	16	4'-3"	65	2.7
18"	3'-9"	2'-9"	5'-0"	2	8'-6"	2	9'-6"	16	4'-6"	72	3.3
21"	4'-3"	3'-3"	5'-3"	2	9'-6"	2	10'-6"	16	4'-9"	78	3.8
24"	4'-9"	3'-9"	5'-6"	2	10'-6"	2	11'-6"	16	5'-0"	83	4.4
27"	5'-3"	4'-3"	5'-9"	2	11'-6"	2	12'-6"	16	5'-3"	88	5.0
30"	6'-0"	5'-0"	6'-0"	2	13'-0"	2	14'-0"	16	5'-6"	95	5.8
33"	6'-6"	5'-6"	6'-3"	2	14'-0"	2	15'-0"	16	5'-9"	100	6.4
36"	7'-0"	6'-0"	6'-6"	2	15'-0"	2	16'-0"	16	6'-0"	106	7.1
39"	7'-6"	6'-6"	6'-9"	2	16'-0"	2	17'-0"	16	6'-3"	111	7.8
42"	8'-3"	7'-3"	7'-0"	2	17'-6"	2	18'-6"	16	6'-6"	118	8.8

(QUANTITIES IN TWO HEADWALLS)

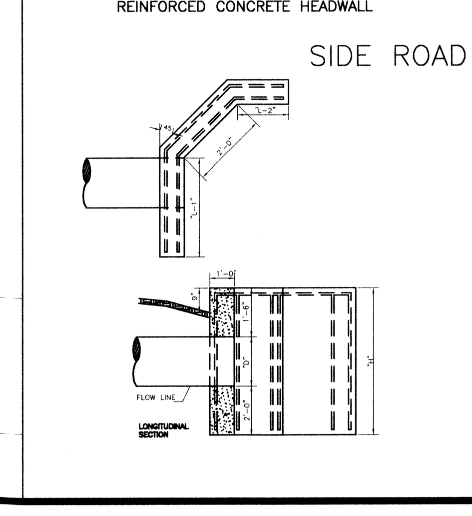

END VIEW

REVISIONS	DATE	
		HEADWALLS HW-D
		CHK. BY: C.A.H. EFFECTIVE DATE: 1-1-94
		BUTLER COUNTY ENGINEERS OFFICE AND OPERATIONS FACILITY 1921 FAIRGROVE AVENUE – HAMILTON, OHIO 45011 PHONE 867-5744

THIS DOCUMENT AND ALL RELATED DETAIL DRAWINGS, SPECIFICATIONS, AND ELECTRONIC MEDIA PREPARED OR FURNISHED BY BAYER BECKER (BB), ARE INSTRUMENTS OF BB'S PROFESSIONAL SERVICE, AND IS THE EXCLUSIVE PROPERTY OF BB. NO DISCLOSURE, USE, REPRODUCTION, OR DUPLICATION IN WHOLE, OR IN PART, MAY BE MADE WITHOUT WRITTEN PERMISSION OF BB, AND IS DONE SO AT USER'S SOLE RISK. COPYRIGHT – ALL RIGHTS RESERVED.

Item	Revision Description	Date	Drwn:	Chk:

BUTLER COUNTY, OHIO
STORM DETAILS

bayer becker
www.bayerbecker.com
6900 Tylersville Road, Suite A
Mason, OH 45040 - 513.336.6600

Drawing: BCSTMDET
Drawn by:
Checked By:
Issue Date: 8-13-12
Sheet:

GENERAL NOTES

EROSION AND SEDIMENT CONTROLS

Vegetative practices

Such practices may include: temporary seeding, permanent seeding, mulching, matting, sod stabilization, vegetative buffer strips, phasing and protection of trees. The contractor shall initiate appropriate vegetative practices on all disturbed areas within seven (7) days if they are to remain dormant (undisturbed) for more than fourteen (14) days. Permanent or temporary soil stabilization shall be applied to disturbed areas within seven (7) days after final grade is reached on any portion of the site.

Structural Practices

Structural practices shall be used to control erosion and trap sediment from all sites remaining disturbed for more than fourteen (14) days.

Timing

Sediment control structures shall be functional throughout earth disturbing activity. Sediment ponds and perimeter sediment barriers shall be implemented as the first step of grading and within seven days from the start of grubbing. They shall continue to function until the upslope development area is restabilized.

Sediment Barriers

Sheet flow runoff from denuded areas shall be intercepted by sediment barriers. Sediment barriers, such as sediment fences or diversions direction runoff to settling facilities, shall protect adjacent properties and water resources from sediment transported by sheet flow.

Erosion and sediment control practices used to satisify the conditions of this plan shall meet the standards and specifications in the current edition of Water Management and Sediment Control in Urbanized Areas (Soil Conservation Service.)

Waste Disposal

No solid or liquid waste, including building materials, shall be discharged in storm water runoff. Off-site vehicle tracking of sediments shall be minimized. The plan shall ensure and demonstrate compliance and applicable State of local waste disposal, sanitary sewer or septic system regulations.

Maintenance

All temporary and permanent control practices shall be maintained and repaired as needed to assure continued performance of their intended function.

Dormant Seedings

1. Seedings shall not be planted from October 1 through November 20. During this period the seeds are likely to germinate but probably will not be able to survive the winter.

2. The following methods may be used for "Dormant Seeding":

From October 1 through November 20, prepare the seedbed, add the required amounts of lime and fertilizer, then mulch and anchor. After November 20 and before March 15, broadcast the selected seed mixture. Increase the seeding rates by 50% for this type of seeding.

From November 20 through March 15, when soil conditions permit, prepare the seedbed, lime and fertilize, apply the selected seed mixture, mulch and anchor. Increase the seeding rates by 50% for this type of seeding.

Apply seed uniformly with a cyclone seeder, drill, cultipacker seeder, or hydro-seeder (slurry may include seed and fertilizer) on a firm, moist seedbed.

Where feasible, except when a cultipacker type seeder is used, the seedbed should be firmed following seeding operations with a cultipacker, roller, or light drag. On sloping land, seeding operations should be on the contour where feasible.

1 REVEGETATION

Seed, sod or mulch bare soil as soon as possible

SEEDING AND MULCHING

Spread 4 to 6 inches of topsoil. Fertilize according to soil test (or apply 10 lb./1000 sq. ft. of 20–10–10 or 10–10–10 fertilizer.) Seed with an appropriate mix for the site (see table.) Rake lightly to cover seed with 1/4" of soil. Roll lightly. Mulch with straw (70–90 lb. or one bale per 1000 sq. ft.) Anchor mulch by punching 2 inches into the soil with a dull, weighted disk or by using netting or other measures on steep slopes, or windy areas. Water gently every day or two to keep soil moist. Less watering is needed once grass is 2 inches tall.

SODDING

2 Spread 4 to 6 inches of topsoil. Fertilize according to soil test (or apply 10lb./1000 sq. ft. of 20–10–10 or 10–10–10 fertilizer.) Lightly water the soil. Lay sod. Tamp or roll lightly. On slopes, lay sod starting at the bottom and work toward the top. Peg each piece down in several places. Initial watering should wet soil 6 inches deep (or until water stands 1 inch deep in a straight-sided container.) Then water lightly every day or two for 2 weeks. If construction is completed after October 31, seeding or sodding may be delayed. Applying mulch or temporary seed (such as rye or winter wheat) is recommended if weather permits. Straw bale or silt fences must be maintained until final seeding or sodding is completed in spring March 15– May 31.

4 STRAW BALE DETAILS

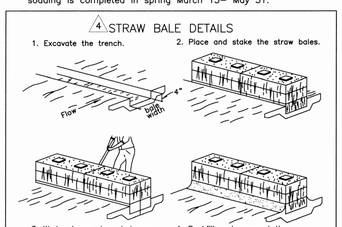

CONSTRUCTION OF A STRAW BALE BARRIER.

Source: Adapted from Installation of Straw and Filter Barriers for Sediment control, Sherwood and Wyant.

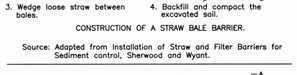

Points A should be higher than point B

PROPER PLACEMENT OF A STRAW BALE BARRIER IN DRAINAGE WAY

Source: Installation of Straw and Filter Barriers for Sediment Control, Sherwood and Wyant.

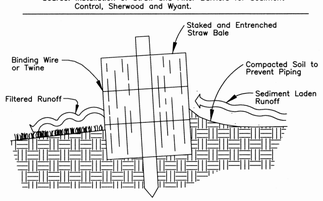

CROSS SECTION OF A PROPERLY INSTALLED STRAW BALE

Source: Michigan Soil Erosion and Sediment Control Guidebook, 1975

5 SILT FENCE OR MULCH BERM DETAILS

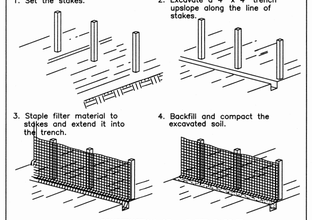

CONSTRUCTION OF A FILTER BARRIER

Source: Installation of Straw and Fabric Filter Barriers for Sediment Control, Sherwood and Wyant

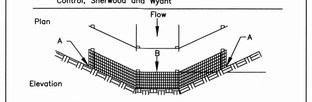

Points A should be higher than point B

PROPER PLACEMENT OF A STRAW BALE BARRIER IN DRAINAGE WAY

Source: Adapted from Installation of Straw and Fabric Filter Barriers for Sediment Control, Sherwood and Wyant

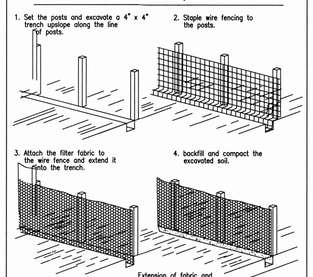

Source: Adapted from Installation of Straw and Fabric Filter Barriers for Sediment Control, Sherwood and Wyant

INSTALLATION NOTES AND SPECIFICATIONS FOR MULCH BERM:

1. Mulch berm should be placed along a level contour so that it will not channel runoff and create concentrated flows.
2. Upland drainage limitaions (sheet flow)
3. Design Criteria:
   - —particle sizes (99% passing 1 inch sieve etc.)
   - —moisture content
   - —no less than 70% organdies
4. Planning considerations: most effective when combined with vegetated buffer.

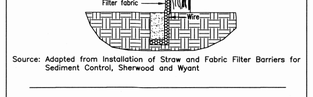

CROSS-SECTION VIEW

3 PRESERVING EXISTING VEGETATION

Wherever possible, preserve existing trees, shrubs, and other vegetation. To prevent root damage, do not grade, place soil piles, or park vehicles near trees marked for preservation. Place plastic mesh or snow fence barriers around trees to protect the area below their branches.

4 STRAW BALE, SILT FENCE or MULCH BERM
or Put up before any other work is done. Install on
5 downslope side(s) of site with ends extended up sideslopes a short distance. Place parallel to the contour of the land to allow water to pond behind fence. Entrench 4 inches deep (see back page.) Stake (2 stakes per bale OR 1 stake every 3 feet for silt fence.) Leave no gaps between bales or sections of silt fence. Inspect and repair once a week and after every 1/2 inch rain. Remove sediment if deposits reach half the fence or straw bale height. Maintain until a lawn is established.

6 SOIL PILES

Located away from any downslope street, driveway, stream, lake, wetland, ditch or drainageway. Temporary seed such as annual rye is recommended for topsoil piles. Surround with straw bales or silt fence.

GRAVEL DRIVE

Install a single access drive using 3 to 5 inch aggregate over a geotextile material. Lay gravel 6 inches deep and 10 feet wide from the foundation to the street. Use to prevent tracking dirt onto the road by all vehicles. Maintain throughout construction until driveway is paved. Park all construction vehicles on the street and off of the site.

SEDIMENT CLEANUP

By the end of each work day, sweep or scrape up soil tracked onto the road. By the end of the next work day after a storm, clean up soil washed off-site, and check straw bales and silt fence for damage or sediment buildup. DOWNSPOUT EXTENDERS

Not required, but highly recommended. Install as soon as gutters and downspouts are completed. Route water to a grassed or paved area. Maintain until a lawn is established.

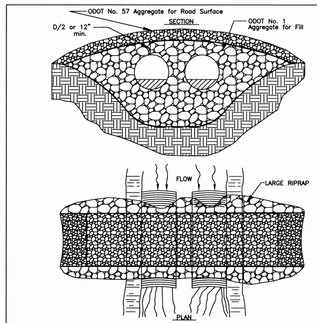

7 TEMPORARY STREAM CROSSING

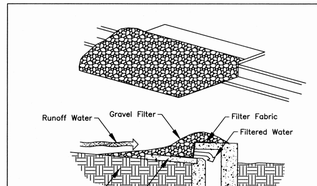

SPECIFIC APPLICATION

This method of inlet protection is applicable at curb inlets where ponding in front of the structure is not likely to cause inconvenience or damage to adjacent structures and unprotected areas.

8 GRAVEL CURB INLET SEDIMENT FILTER

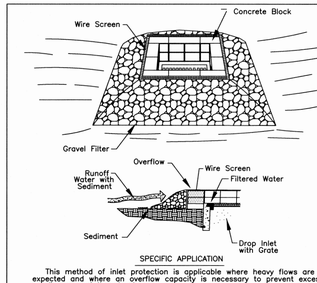

SPECIFIC APPLICATION

This method of inlet protection is applicable where heavy flows are expected and where an overflow capacity is necessary to prevent excessive ponding around the structure.

9 BLOCK AND DROP INLET SEDIMENT FILTER

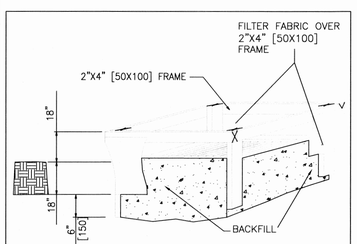

1. Inlet protection shall be constructed either before upslope land disturbance begins of before the storm drain becomes operational.
2. The Earth around the inlet shal be excavated completely to a depth at least 18 in.
3. The wooden frame shall be constructed of 2–by–4–in. constuction–grade lumber. the 2–by–4in. Posts shall be driven 1 ft. into the ground at four corners of the inlet and the top portion of the 2–by–4–in. frame assembled using the overlap joint shown. The top of the frame shall be at least 6–in. below adjacent roadsif ponded water pose a safety hazard to traffic.
4. Wire mesh shall be of sufficient strength to support fabric with water fully impounded against it. It shall be stretched tightly around the frame and fastened securely to the frame.
5. Geotextile shall have an equivalent opening size of 20–40 sieve and be resistant to sunlight. It shall be stretched tightly around the frame and fastened securely. It shall extend from the top of the frame to 18 in. below the inlet notch elevation. The geotextile shall overlap across one side of the inlet so the ends of the cloth are not fastened to the same post.
6. Backfill shall be placed around the inlet in compacted 6–in. layers until the earth is even with notch elevation on ends and top elevation on sides.
7. A compacte earth dike or a check dam shall be constructed in the ditch line below the inlet if the inlet is not in a depression and if runoff bypassing the inlet will not flow to a settling pond. The top of earth dikes shall be at least 6 in. higher than the top of the frame.

9 GEOTEXTILE INLET PROTECTION IN SWALES, DITCH LINES OR YARD INLETS

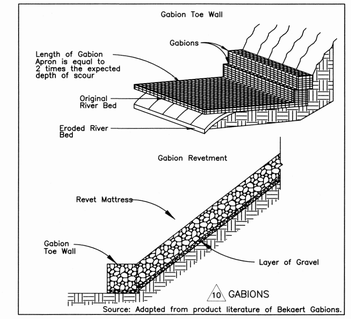

10 GABIONS

Source: Adapted from product literature of Bekaert Gabions.

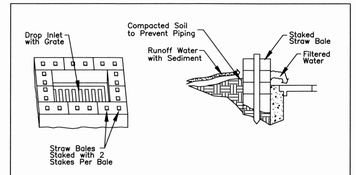

SPECIFIC APPLICATION

This method of inlet protection is applicable where the inlet drains a relatively flat area (slope no greater than 5 percent) where sheet or overland flows not exceeding 0.5 cfs) are typical.

11 STRAW BALE DROP INLET SEDIMENT FILTER

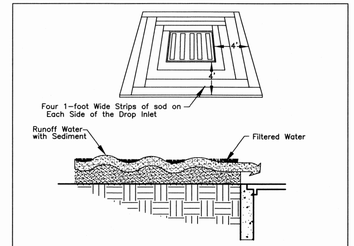

SPECIFIC APPLICATION

This method of inlet protection is applicable only at the time of permanent seeding, to protect the inlet from sediment and mulch materials until permanent vegetation has become established.

12 SOD DROP INLET SEDIMENT FILTER

INLET PROTECTION DETAILS

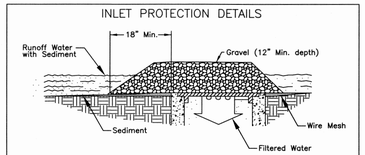

Specific Application

This method of inlet protection is applicable where heavy concetrated flows are expected, but not where ponding around the structure might cause excessive inconvenience or damage to adjacent structures and unprotected areas.

13 GRAVEL AND WIRE MESH DROP INLET SEDIMENT FILTER

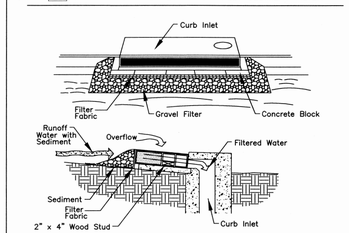

SPECIFIC APPLICATION

This method of inlet protection is applicable at curb inlets where an overflow capability is necessary to prevent excessive ponding in front of the structure.

14 BLOCK AND GRAVEL CURB INLET SEDIMENT FILTER

SEDIMENT TRAPS & DAMS

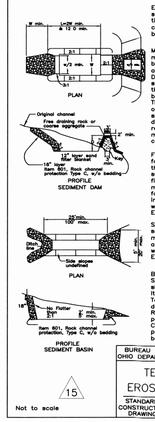

EMBANKMENT for sediment basin construction shall be as 203 compacted as directed by the Engineer.

MAINTENANCE: Sediment pits, dams and basins shall be acceptably maintained. Deposited sediment shall be removed when the initial volume has been reduced one–half. If more frequent removal is required, basins shall be replaced when deposited sediment is removed. The cost of maintenance shall be covered by item 207.

FILTERS: Plastic filter fabric, as approved by the engineer, may be substituted for the sand filter blanket on sediment dams. Plastic filter fabric may be used in lieu of replacement, when approved by the Engineer.

SIZE: A series of smaller basins or dams may be substituted for a longer basin or dam when approved by the Engineer.

BASIS OF PAYMENT: Sediment Dams and Basins shall be paid for under item 207 Cubic Yard Temporary benches, dikes, dams and sediment basins. Rock required shall be paid for under item 601, Cubic Yard, Rock channel protection, Type C, w/o bedding.

BUREAU OF LOCATION AND DESIGN
OHIO DEPARTMENT OF TRANSPORTATION

TEMPORARY EROSION CONTROL

STANDARD CONSTRUCTION DRAWING MC–11

Not to scale

15

DIKES AND SLOPE PROTECTION

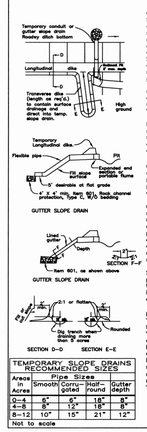

TEMPORARY SLOPE DRAINS RECOMMENDED SIZES				
Areas in Acres	Pipe Sizes Smooth	Corrugated	Half–round	Gutter depth
0–4	6"	6"	18"	8"
4–8	8"	12"	18"	8"
8–12	10"	15"	21"	12"

Not to scale

General: Dikes & drains Shown shall be used when earthwork operations on embankments are suspended for three days or more less/or as directed by the Engineer Smaller dikes used at the end of a day's operation shall be considered as part of the earthwork. Temporary slope drains shall be suitably positioned and or anchored to prevent movement or undermining, as directed by the Engineer.

LONGITUDINAL DIKES shall be constructed of suitable 203 material and compacted to 85% maximum density.

CONDUITS for slope drains shall be corrugated steel pipe, corrugated or smooth plastic pipe, rubber conduit, or an approved equal.

GUTTERS for slope drains shall be lined with Type C rock channel protection, crushed aggregate slope protection, portland cement concrete, bituminous concrete, plastic sheeting (on slopes 4:1 max.), portal pipe section or approved equal.

SEDIMENT PITS shall be provided where directed by the Engineer and their cost included in the price bid for adjacent 207 items.

BASIS OF PAYMENT: Temporary dikes shall be paid for under item 207 Cubic Yard, Temporary benches, dikes, dams and sediment basins. Temporary slope drains shall be paid for under Item 207, Linear foot, Temporary slope drains. Rock required shall be paid for under item 601, rock channel protection, Type C, w/o bedding.

16

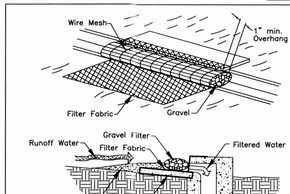

Specific Application

This method of inlet protection is applicable at curb inlets where ponding in front of the structure is not likely to cause inconvenience or damage to adjacent structures and unprotected areas.

17 WRAPPED GRATE, ROLLED GRAVEL CURB INLET FILTER

18 CHECK DAM DETAILS

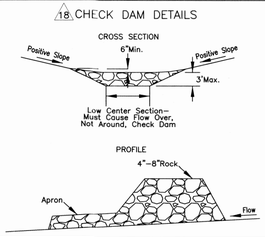

Check Dam Spacing				
Dam Height (ft.)	Channel Slope < 5%	5–10%	10–15%	15–20%
1	65 ft.	30 ft.	20 ft.	15 ft.
2	130 ft.	65 ft.	40 ft.	30 ft.
3	200 ft.	100 ft.	65 ft.	50 ft.

CHECK DAMS

1. The check dam shall be constructed of 4 to 8 inch diameter stone, placed so that it completely covers the width of the channel.

2. The top of the check dam shall be constructed so that the center is approximately 6 inches lower than the outer edges so water will flow across the center and not around the ends.

3. The maximum height of the check dam at the center of the weir shall not exceed 3 ft.

4. Spacing between dams shall be as shown by the check dam spacing table.

DESCRIPTION

Check dams are small rock dams constructed in swales, grassed waterways or diversions. They reduce the velocity of concentrated flows, thereby reducing erosion within the swale or waterway. While this practice often traps some sediment, its trapping efficiency is extremely poor, thus, it should not be used as a sediment trapping practice.

CONDITIONS

This practice is limited to use in small open channels where it is necessary to slow the velocity of flows in order to prevent erosion. Applications include temporary swales which, because of their short length of service, are not practical to receive a nonerodible lining or swales which need protection during the establishment of grass linings, See specifications for rock check and gravel riffle for larger channels and streams.

DESIGN LIMITS

Check dams must not be relied upon to remove sediment from runoff flowing through a channel but rather are used to reduce erosion of the channel itself. However, innovative applications may produce effective ponding areas behind check dam or silt fence structures adequate to trap sediment from sites with very little slope and very little drainage area, less than 2 % slope and less than 2 ac. drainage area.

SPLASH APRON

Where check dams are expected to be in use for an extended period of time, a stone apron may be constructed immediately downstream of the check dam to prevent flows from undercutting the structure. The apron should be 6 inches thick and its length two times the height of the dam.

19 TEMPORARY DETENTION SEDIMENT FILTER

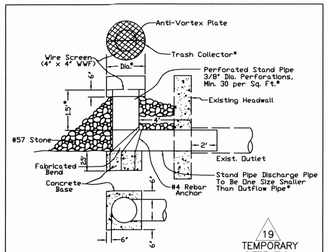

*For more details see pages 98–110 of Rainwater and Land Development; Ohio's Standards for Stormwater Management. Prepared by the Ohio Department of Natural Resources, Division of Soil and Water Conservation.

20 DANDY BAG®/BEAVER DAM

Installation and Maintenance Guidelines

Installation: The empty Beaver Dam should be placed over the grate as the grate stands on end. If using optional oil absorbents; place absorbent pillow on pouch, on the bottom (below–grade side) of the unit. Attach absorbent pillow to tether loop. Tuck the enclosure flap inside to completely enclose the grate. Holding the lifting devices (do not rely on lifting devices to support the entire weight of the grate), place the grate into its frame (street side first), then lower back edge with dam into place. The Beaver Dam should be partially blocking the curb hood when installed properly.

Maintenance: Remove all accumulated sediment and debris from surface and vicinity of unit after each storm event. Remove sediment that has accumulated within the containment area of the Beaver Dam as needed. If using optional oil absorbents; remove and replace absorbent pillow when near saturation.

BEAVER DAM

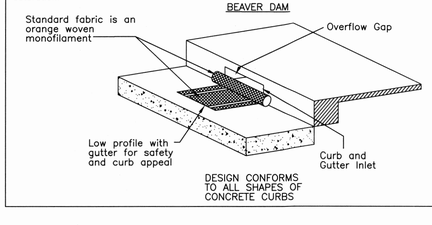

DESIGN CONFORMS TO ALL SHAPES OF CONCRETE CURBS

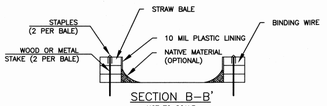

SECTION B–B'
NOT TO SCALE

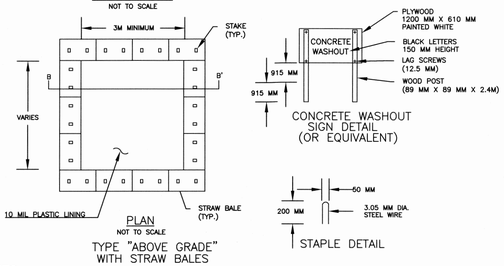

PLAN
NOT TO SCALE

CONCRETE WASHOUT SIGN DETAIL (OR EQUIVALENT)

TYPE "ABOVE GRADE" WITH STRAW BALES

STAPLE DETAIL

NOTES:

1. ACTUAL LAYOUT DETERMINED IN THE FIELD.
2. THE CONCRETE WASHOUT SIGN (SEE FIG. 4–15) SHALL BE INSTALLED WITHIN 10 M OF THE TEMPORARY CONCRETE WASHOUT FACILITY.

22 CONCRETE WASHOUT AREA

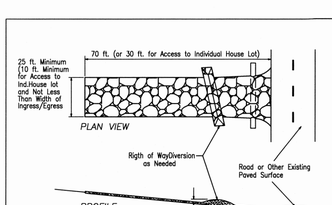

1. Stone Size — Two–inch stone shall be used, or recycled concrete equivalent.
2. Length — The construction entrance shall be as long as required to stabilize high traffic areas but not less than 70 ft. (except on single residence lots where a 30–ft. minimum length applies.
3. Thickness — The stone layer shall be at least 6 in. thick.
4. Width — The entrance shall be at least 25 ft. wide, (10 ft. wide for access to individual house lots) but not less than the full width at points where ingress or egress occurs.
5. Bedding — A geotextile shall be placed over the entire area prior to placing stone. It shall have a Grab Tensile Strength of at least 200 lb. and a Mullen Burst Strength of at least 190 lb.
6. Culvert — A pipe or culvert shall be constructed under the entrance if needed to prevent surface water flowing across the entrance from being directed out onto paved surfaces.
7. Water Bar — A water bar shall be constructed as part of the construction entrance if needed to prevent surface runoff from flowing the length of the construction entrance and out onto paved surfaces.
8. Maintenance — Top dressing of additional stone shall be applied as conditions demand. Mud spilled, dropped, washed or tracked onto public roads, or any surface where runoff is not checked by sediment controls, shall be removed immediately. Removal shall be accomplished by scraping or sweeping.
9. Construction entrances shall not be relied upon to remove mud from vehicles and prevent off–site tracking. Vehicles that enter and leave the construction site shall be restricted from muddy areas.

21 CONSTRUCTION ENTRANCE

Item	Revision Description	Date	Drwn:	Chk:

EROSION & SEDIMENT CONTROLS

bayer becker
www.bayerbecker.com
6900 Tylersville Road, Suite A
Mason, OH 45040 • 513.336.6600

Drawing:

SOIL

Drawn by:

Checked By:

Issue Date:

Sheet:

15/15

Plot time: Jan 24, 2018 – 2:23pm
Drawing name: K:\–FF\BLOCKS\DETAILS\SOILEROS\SOIL.DWG – Layout Tab: Layout1