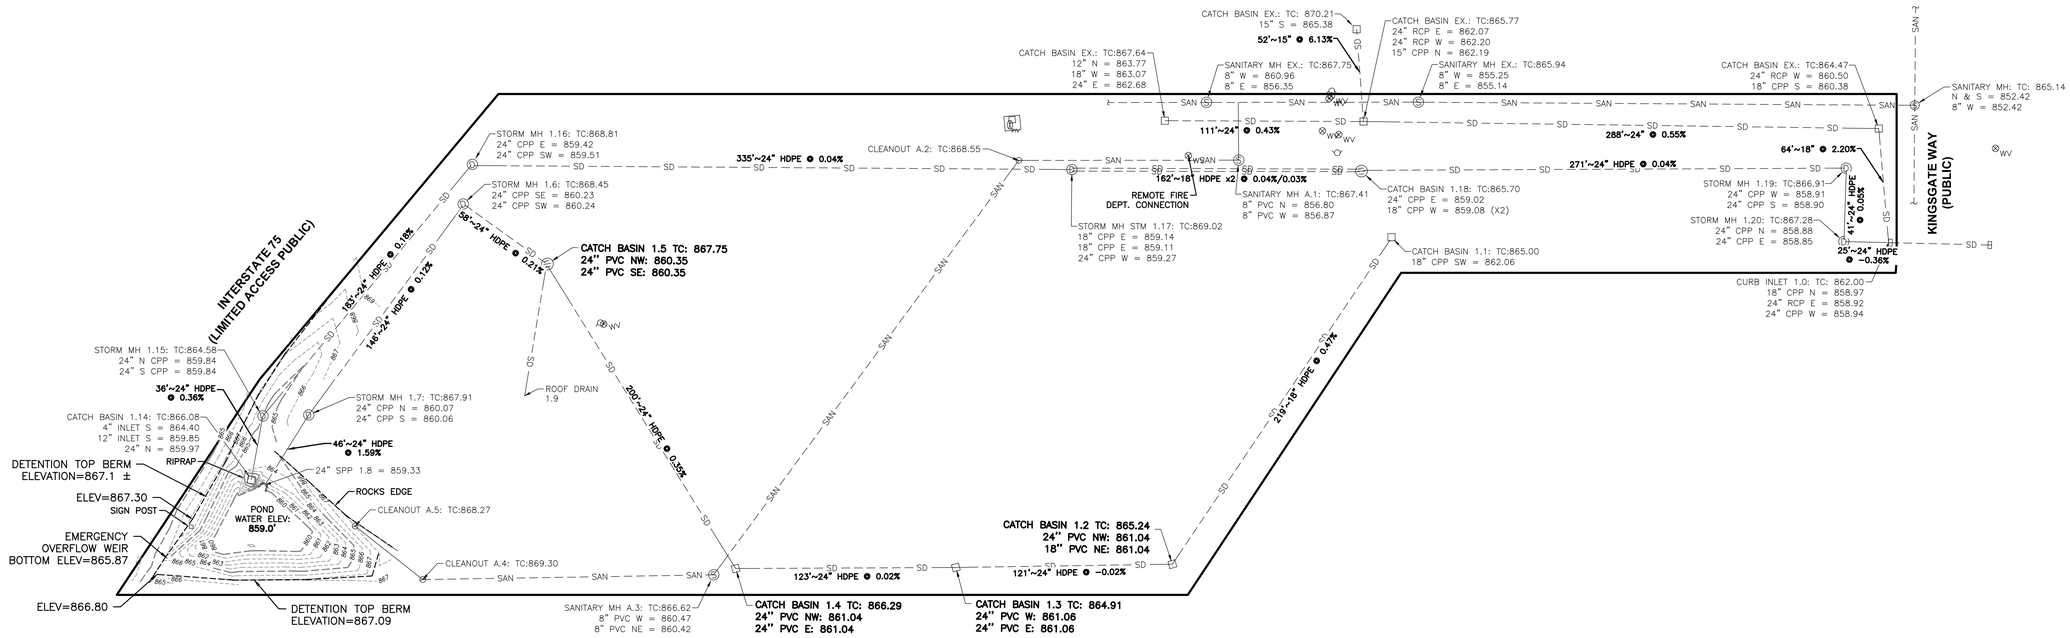


SURVEYOR'S CERTIFICATE

I HEREBY CERTIFY THAT THIS ASBUILT SURVEY IS A CORRECT REPRESENTATION OF A FIELD SURVEY PERFORMED BY WOOLPERT INC. ON JULY 14, 2017. THE POND WAS RE-SURVEYED ON JULY 19, 2017. SITE CONDITIONS MAY VARY BEYOND THIS DATE.

STATE OF OHIO
CODY SCHNEIDER
S-8670
REGISTERED
PROFESSIONAL SURVEYOR

CODY J. SCHNEIDER
OHIO REGISTERED SURVEYOR NO. 8670
LICENSE EXPIRES 12/31/17

DATE: 07/21/17

WOOLPERT, INC.

No.	DATE	REVISION
3.	07/21/17	REVISED PER FIELD WORK
2.	07/19/17	POND REVISED PER 07/19/17 FIELD DATA
1.	07/14/17	UPDATED PER FIELDWORK

SEAL

PROJECT No: 75566
DATE 07/07/2017
DES. ____
DR. TC
CKD. CS

4454 Idea Center Blvd
Dayton, OH
45430-1500
937.461.5660
FAX: 937.461.0743

WOOLPERT
ARCHITECTURE | ENGINEERING | GEOSPATIAL

TEXAS ROADHOUSE

7309 KINGSGATE WAY
TOWNSHIP OF WEST CHESTER, BUTLER COUNTY, OHIO

STORM AND SANITARY AS-BUILT SURVEY

SHEET NO.

1 OF 1

Layout Tab Name: Layout1, Images: CodysSign.jpg; CodysSignature.jpg; , Xrefs:
Last Saved By:Kaczmarzyk, 7/21/2017 2:12:59 PM
G:\GS\Projects\Various\75566 - Texas Roadhouse West Chester OH\Drawings\75566 - AsBuilt Survey 20170721.dwg Plotted By:Kaczmarzyk, Pawel Plotted:July 21, 2017, 3:20:04 PM