
NORTH

20 0 20

GRAPHIC SCALE (IN FEET)

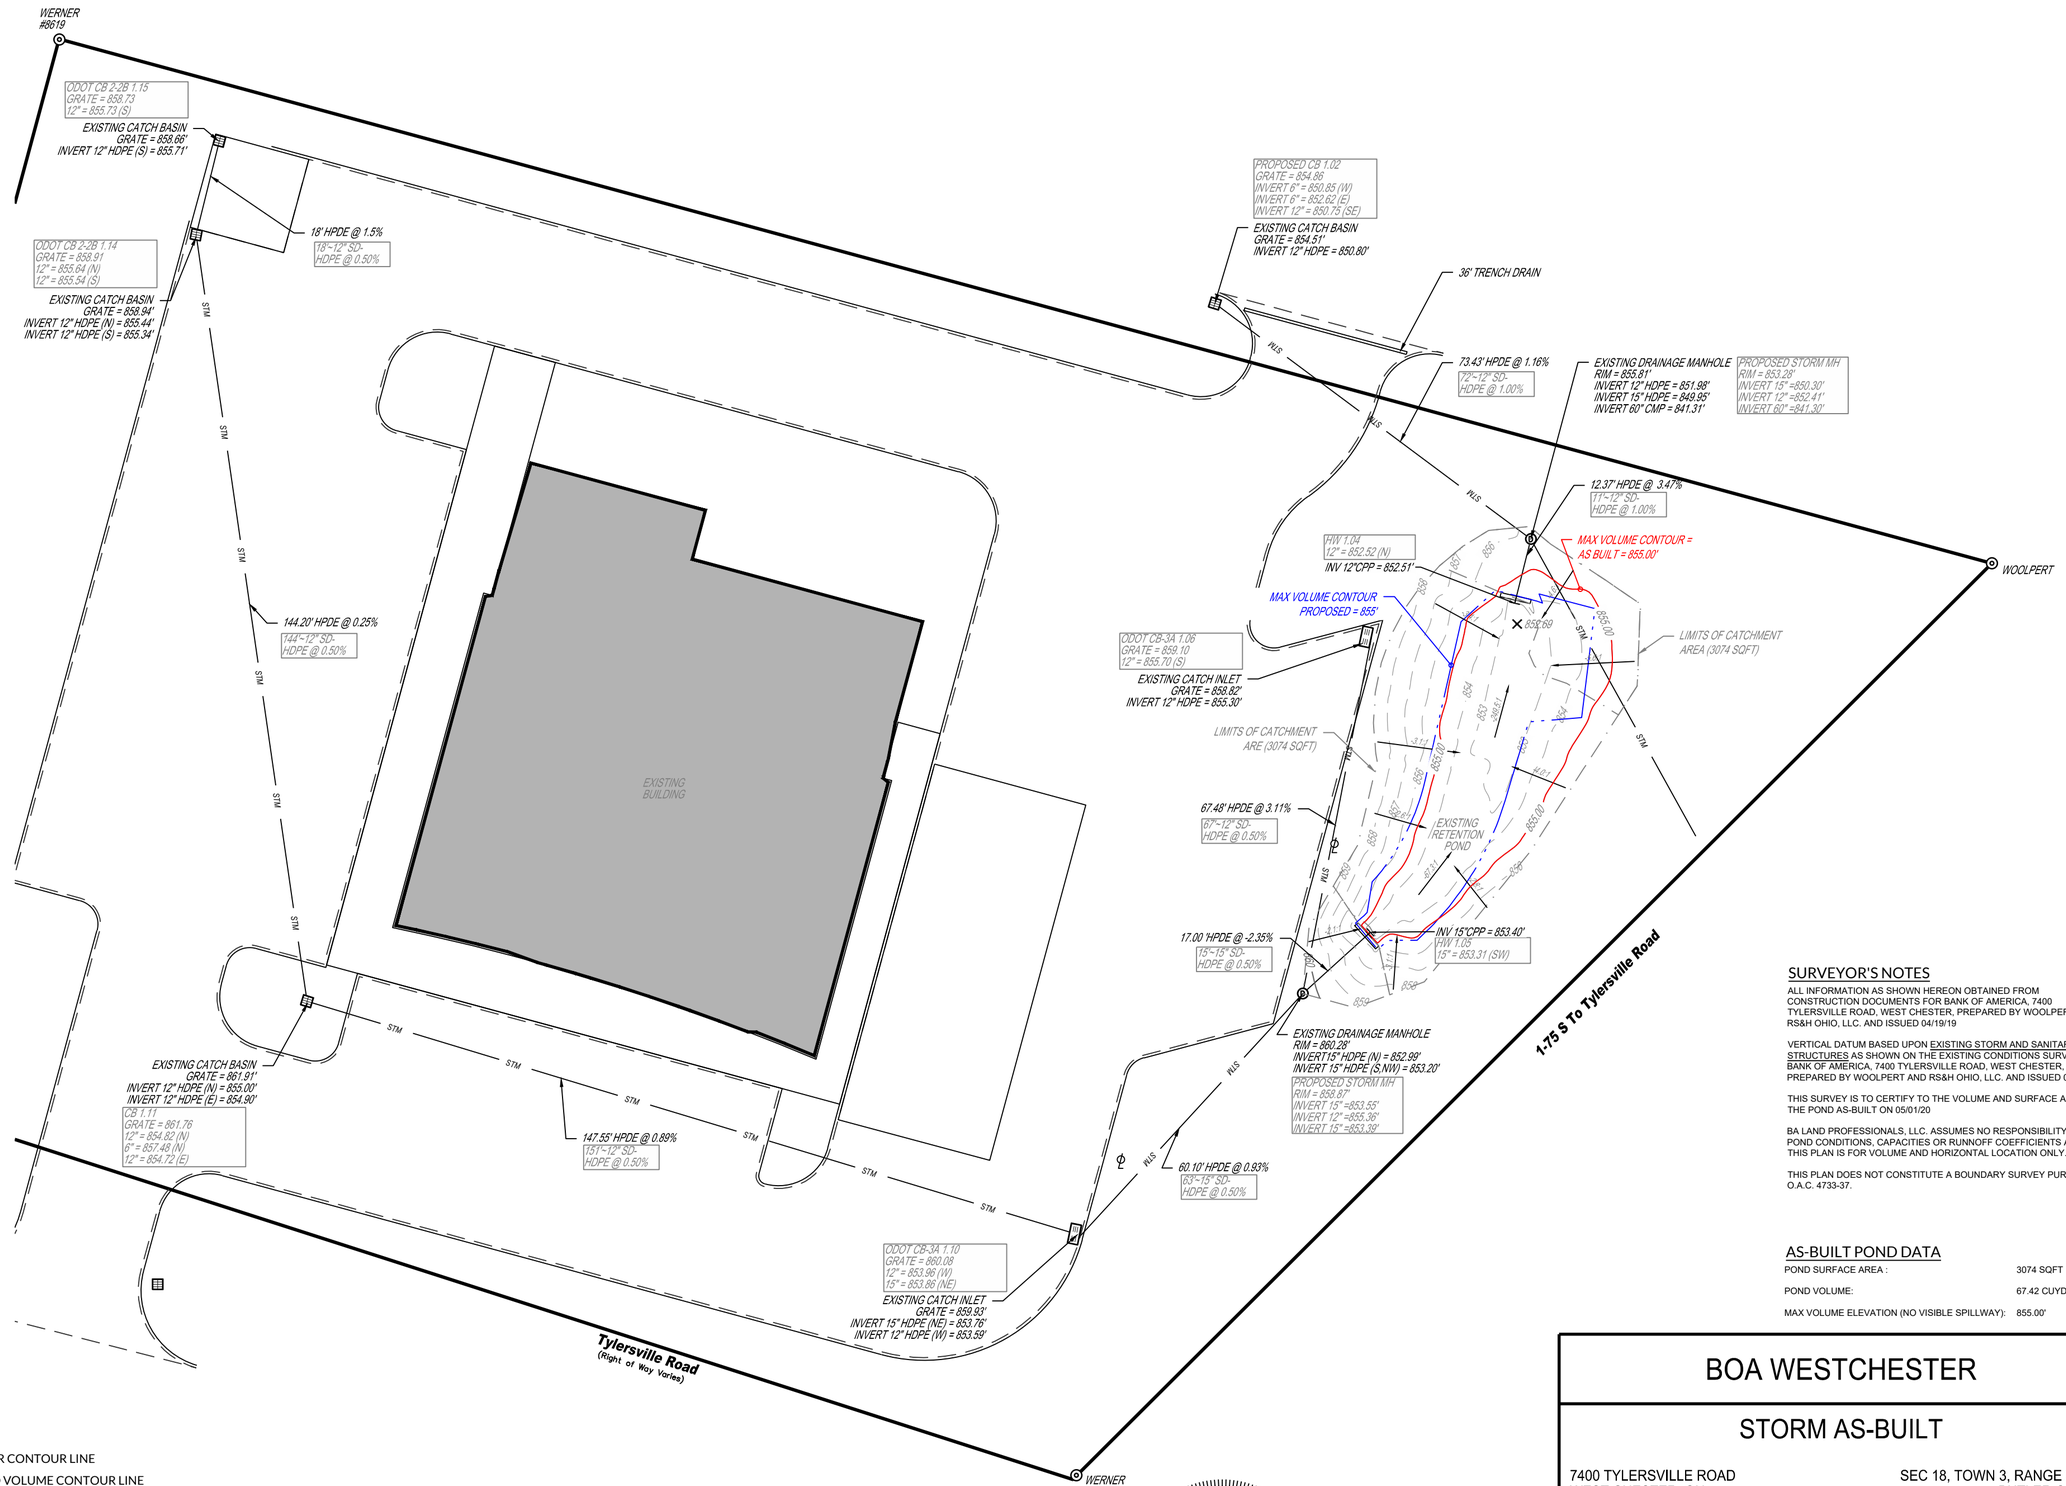

MAP LEGEND

- SQUARE CATCH BASIN
- CURB INLET
- STORM LINE
- AS-BUILT MAJOR CONTOUR LINE
- MAX PROPOSED VOLUME CONTOUR LINE
- AS-BUILT MINOR CONTOUR LINE
- MAX AS-BUILT VOLUME CONTOUR LINE
- HW 1.05 / 15" = 853.31 (SW) — PROPOSED STRUCTURE INFO / PIPE INFO

SURVEYOR'S NOTES

ALL INFORMATION AS SHOWN HEREON OBTAINED FROM CONSTRUCTION DOCUMENTS FOR BANK OF AMERICA, 7400 TYLERSVILLE ROAD, WEST CHESTER, PREPARED BY WOOLPERT AND RS&H OHIO, LLC. AND ISSUED 04/19/19

VERTICAL DATUM BASED UPON EXISTING STORM AND SANITARY STRUCTURES AS SHOWN ON THE EXISTING CONDITIONS SURVEY FOR BANK OF AMERICA, 7400 TYLERSVILLE ROAD, WEST CHESTER, PREPARED BY WOOLPERT AND RS&H OHIO, LLC. AND ISSUED 04/19/19

THIS SURVEY IS TO CERTIFY TO THE VOLUME AND SURFACE AREA OF THE POND AS-BUILT ON 05/01/20

BA LAND PROFESSIONALS, LLC. ASSUMES NO RESPONSIBILITY FOR POND CONDITIONS, CAPACITIES OR RUNNOFF COEFFICIENTS AND THIS PLAN IS FOR VOLUME AND HORIZONTAL LOCATION ONLY.

THIS PLAN DOES NOT CONSTITUTE A BOUNDARY SURVEY PURSUANT O.A.C. 4733-37.

AS-BUILT POND DATA

POND SURFACE AREA :	3074 SQFT
POND VOLUME:	67.42 CUYD
MAX VOLUME ELEVATION (NO VISIBLE SPILLWAY):	855.00'

STATE OF OHIO
BRYANT ABT
S-8593
REGISTERED PROFESSIONAL SURVEYOR

SURVEYOR

J. BRYANT ABT, PS
OHIO P.S. # 8593
BA LAND PROFESSIONALS, LLC
8534 YANKEE STREET
DAYTON, OH 45458
937.535.0855
WWW.BALANDPROFESSIONALS.COM
ABT@BALANDPROFESSIONALS.COM

BOA WESTCHESTER

STORM AS-BUILT

7400 TYLERSVILLE ROAD
WEST CHESTER, OH

SEC 18, TOWN 3, RANGE 2 M.Rs.
BUTLER COUNTY

SCALE: 1" = 10'	DATE: 05/04/20
DESIGN: N/A	JOB NO.: 19-0136
DRAWN: JBA	SHEET NO.: 1 OF 1
CHECKED: DPB	

BA LAND PROFESSIONALS