INTERSTATE COMMERCE CENTER I

SECTION 9, TOWN 2, RANGE 2
WEST CHESTER TOWNSHIP, BUTLER COUNTY, OHIO


INDEX OF SHEETS

SHEET NO.	DRAWING TITLE	PERMIT SET	BULLETIN C1	BULLETIN C2	BULLETIN C3	BULLETIN C4	BULLETIN C5	BULLETIN C6	BULLETIN C7	BULLETIN C8
C1	CIVIL TITLE SHEET	06-04-07	06-07-07	06-25-07	07-10-07	07-20-07	08-07-07	08-09-07	09-06-07	10-03-07
C2	GENERAL NOTES	06-04-07							09-06-07	10-03-07
C3	SCHEMATIC PLAN	06-04-07		06-25-07	07-10-07				09-06-07	10-03-07
C4	LAYOUT PLAN	06-04-07		06-25-07	07-10-07	07-20-07			09-06-07	10-03-07
C5	LAYOUT PLAN	06-04-07		06-25-07					09-06-07	10-03-07
C6	UTILITY PLAN	06-04-07	06-07-07	06-25-07	07-10-07	07-20-07	08-07-07	08-09-07	09-06-07	10-03-07
C7	UTILITY PLAN	06-04-07	06-07-07	06-25-07	07-10-07	07-20-07	08-07-07	08-09-07	09-06-07	
C8	GRADING & EROSION CONTROL PLAN	06-04-07	06-07-07	06-25-07	07-10-07				09-06-07	10-03-07
C9	GRADING & EROSION CONTROL PLAN	06-04-07	06-07-07	06-25-07		07-20-07	08-07-07		09-06-07	10-03-07
C10	DRAINAGE PLAN	06-04-07	06-07-07	06-25-07		07-20-07				
C11	SANITARY & WATER DETAILS	06-04-07	06-07-07			07-20-07				
C12	EROSION CONTROL DETAILS	06-04-07								
L1.0	DETAILED PLANTING PLAN			06-26-07						

STM SEWER AS-BUILT 10-01-07

SYMBOL LEGEND

EXISTING	PROPOSED	DESCRIPTION
		BENCHMARK
x x	o o	FENCE
		FLAG POLE
		HANDICAP SYMBOL
		MAILBOX
		SIGN
		SURVEY MONUMENTATION
		TRAFFIC BOX
		TRAFFIC SIGNAL POLE
		TREE
		VEGETATION LINE
		CABLE BOX
EX UC	UC	UNDERGROUND CABLE
		ANCHOR
		ELECTRICAL BOX
		ELECTRICAL TRANSFORMER
		LIGHT POLE
EX OHE	OHE	OVERHEAD ELECTRIC
EX UE	UE	UNDERGROUND ELECTRIC
		UTILITY POLE
EX G	G	GAS LINE
		GAS METER
		GAS VALVE
		CONTROL/SAMPLING MANHOLE
EX SL EX SL	SL	SANITARY LATERAL
		SANITARY MANHOLE
EX S	S	SANITARY SEWER
		CATCH BASIN
		HEADWALL
EX 12" STM	12" STM	STORM SEWER
		TELEPHONE BOX
EX T	UT	UNDERGROUND TELEPHONE
		FIRE HYDRANT
		PURITY TEST STATION
EX W	W	WATER MAIN
		WATER METER
EX WS EX WS	WS	WATER SERVICE
		WATER VALVE

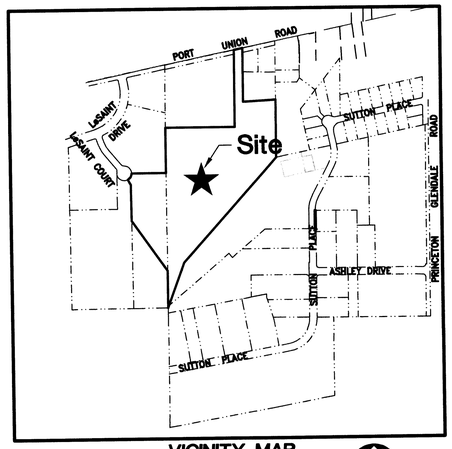

VICINITY MAP
NO SCALE

ZONING=M-2
FLOOD ZONE=A

SITE ADDRESS
4520 LESAINT COURT
FAIRFIELD, OHIO 45014

SCALE IN FEET
Plan Horizontal
0 40 80
SCALE: 1" = 40'

PROJECT DESCRIPTION
CONSTRUCTION OF A FUTURE, 298,650 S.F., INDUSTRIAL WAREHOUSING BUILDING, WITH TRUCK DOCKS AND PARKING LOTS, FOR ONE OR MORE TENANTS.

DEVELOPER
MIDD CITIES
7811 LAUREL AVENUE
CINCINNATI, OHIO 45243
PHONE: (513) 271-0624
FAX: (866) 855-6332

ABBREVIATION LEGEND

ABBREVIATION	DESCRIPTION
AC	ACRES
B/C	BACK OF CURB
BL	BUILDING SETBACK LINE
CB	CATCH BASIN
E	EAST/EASTING
EASE	EASEMENT
ELEC	ELECTRIC
ELEV	ELEVATION
E/P	EDGE OF PAVEMENT
EX	EXISTING
FF	FINISHED FLOOR
FH	FIRE HYDRANT
G	GAS
ICW	INTEGRAL CURB AND WALK
IP	IRON PIN
INV	INVERT
MH	MANHOLE
MED	MEDIUM
MON	MONUMENT
N	NORTH/NORTHING
PG	PERFORMANCE GRADE
R/W	RIGHT OF WAY
SAN	SANITARY
SF	SQUARE FEET
SL	SANITARY LATERAL
STM	STORM
TBR	TO BE REMOVED
T/GR	TOP OF GRATE
T/RIM	TOP OF RIM
TYP	TYPICAL
UC	UNDERGROUND CABLE
UE	UTILITY EASEMENT
UT	UNDERGROUND TELEPHONE
VOL	VOLUME
W	WATER
WM	WATER MAIN
WS	WATER SERVICE


UNDERGROUND UTILITIES
2 WORKING DAYS
BEFORE YOU DIG
Call 1-800-362-2764
OHIO UTILITY
PROTECTION SERVICE
NON MEMBERS
MUST BE CALLED DIRECTLY

LOCATION OF ALL EXISTING UTILITIES TO BE DETERMINED IN THE FIELD PRIOR TO CONSTRUCTION.


O.D.O.T. STANDARD CONSTRUCTION DRAWINGS

DRAWING NO.	DATE	DRAWING NO.	DATE
BP-5.1	07-28-00	DM-4.2	01-21-05
BP-7.1	01-19-07	DM-4.3	07-19-02
CB-1.1	07-15-05	DM-4.4	07-19-02
CB-1.2	07-15-05	GR-1.1	07-16-04
CB-1.3	07-15-05	GR-2.1	01-16-04
CB-2.1	07-15-05	GR-4.2	01-19-07
CB-3.1	07-15-05	HW-1.1	01-21-05
CB-3.2	07-15-05	MH-1.1	07-19-02
DM-1.2	10-21-05	MH-1.2	01-20-06
DM-1.4	04-21-06	WQ-1.1	04-16-04
DM-2.1	07-20-01	WQ-1.2	04-21-06

BENCHMARK
EX PK NAIL LOCATED AT THE CENTER OF THE CUL-DE-SAC OF LESAINT COURT
N=487284.0680
E=1403528.4830
ELEV=652.64

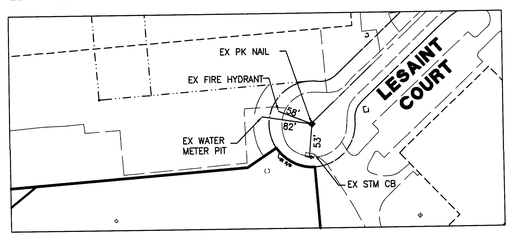

CONTROL POINT
EX MAG NAIL LOCATED FROM THE CENTERLINE INTERSECTION OF LESAINT DR AND UNION CENTRE BOULEVARD EAST 1206' ALONG UNION CENTRE BOUELVARD CENTERLINE AND THEN NORTH 30' FROM THE SAID CENTERLINE
N=488497.7045
E=1404684.9463

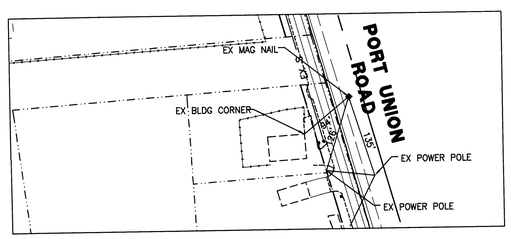

STORM DRAIN AS-BUILTS
CO HOLD RELEASED 12-5-07

Item	Revision Description	Date	Drwn	Chk
	ISSUED FOR PERMIT	06-04-07	JLR	RWB
1	BULLETIN C1: UPDATE INDEX	06-07-07	JLR	RWB
2	BULLETIN C2: PER WEST CHESTER, BCEO, & CONTRACTOR	06-25-07	JLR	RWB
3	BULLETIN C3: PER BCEO'S	07-10-07	JLR	RWB
4	BULLETIN C4: UPDATE INDEX	07-20-07	MAL	RWB
5	BULLETIN C5: REVISED STORM PRY FIELD	08-07-07	MAL	RWB
6	BULLETIN C6: REVISED STORMWATER PER EPA	08-09-07	JLR	RWB
7	BULLETIN C7: REVISED INDEX OF SHEETS	09-06-07	ELB	RWB
8	BULLETIN C8: REVISED INDEX OF SHEETS	10-03-07	JLR	RWB

Robert W. Becker 11-30-07

INTERSTATE COMMERCE CENTER I
4520 LeSAINT COURT
FAIRFIELD, OHIO 45014
WEST CHESTER TOWNSHIP, BUTLER COUNTY, OHIO
SECTION 9, TOWN 2, RANGE 2
CIVIL TITLE SHEET

bayer becker
www.bayerbecker.com
700 Nilles Road
Fairfield, OH 45014 - 513.829.2149

Drawing: 06F070ST
Drawn by: JLR
Checked By: RWB
Issue Date: 06-04-07
Sheet: C1

THIS DRAWING AND ALL RELATED DETAIL DRAWINGS, SPECIFICATIONS, AND ELECTRONIC MEDIA PREPARED OR FURNISHED BY BAYER BECKER ARE INSTRUMENTS OF BBI PROFESSIONAL SERVICE AND AS THE EXCLUSIVE PROPERTY OF BBI, NO DISCLOSURE, REPRODUCTION OR DUPLICATION IN WHOLE OR IN PART, MAY BE MADE WITHOUT WRITTEN PERMISSION OF BBI AND IS TO BE RETURNED UPON REQUEST. ALL RIGHTS RESERVED

Plot time: Oct 15, 2007 - 5:12pm
Drawing name: J:\2006\06F070-000\CA\DWG\06F070ST.dwg - Layout Tab: C01 CIVIL TITLE ICC

UTILITY PLAN

INTERSTATE COMMERCE CENTER I

4520 LeSAINT COURT
FAIRFIELD OHIO 45014
WEST CHESTER TOWNSHIP BUTLER COUNTY OHIO
SECTION 8, TOWN 2, RANGE 2

SCALE: 1" = 40'

MATCHLINE (SEE SHEET C7)

PROPOSED LESAINT EAST BUILDING
285'X1050'
298,650 S.F.
FF=634.20
29.828 Ac.

LeSAINT COURT

APPROXIMATE LOCATION OF EX 8" SAN

APPROXIMATE LOCATION OF EX 10" WATER MAIN

EX FH

WATER METER PIT WITH 2" DOMESTIC METER & OSTORTZ CONNECTION (SEE DETAIL SHT C10)

CONTRACTOR TO REMOVE EXISTING BEND AND CONNECT TO EXISTING 10" LATERAL. CONNECT AT MAIN WITH TAPPING VALVE AND SLEEVE IF LATERAL HAS NOT BEEN INSTALLED. EXISTING CURB AND PAVEMENT TO BE REPLACED IF DAMAGED BY CONSTRUCTION.

PROP 10" WM

EX 10" LATERAL

EX R/W

STM 1
REPLACE EX CB WITH CB-3 WITH NEENAH R-3382 GRATE OR EQUAL
T/GR=~~650.84~~ 650.94
12" INV=~~647.07~~ 646.94

12"Inv.=644.59

Ex.12"STM

STM 1.5
STM MH
CONNECT TO
EX 12" STM
RIM=~~647.35~~ 647.19
EX INV=~~644.59~~ 643.84
PROP INV=~~636.71~~ 636.59

18"Inv.=645.85

Ex.18"STM

6-45° BENDS

STM 0.5
STM MH
CONNECT TO
EX 18"STM
RIM=~~652.31~~
EX INV=~~646.70~~ 646.40
PROP INV=~~633.41~~ 637.96

(123)-18"STM @ 1.43%

TO BE REMOVED

(123)-24"STM @ 0.64%

STM 2
CB-2-4
T/GR=~~640.64~~ 640.55
18" INV=~~636.50~~ 636.20
12" INV=~~636.00~~ 636.05
24" INV=~~636.00~~ 635.90

POWER POLE #55BT2052E (FIELD LOCATED)

3-22.5° BENDS

STM 5
CB 2-3
T/GR=~~628.88~~ 628.82
12" INV=~~624.86~~ 624.92
15" INV=~~624.63~~ 624.92
24" INV=~~624.63~~ 624.77

STM 2.5
CB 2-3
T/GR=~~636.02~~ 635.94
INV=~~629.60~~ 629.44

POWER POLE BY OTHERS

3" DOMESTIC

4" FIRE

10" FIRE

OHE

UE

(2)-5" PRIMARY ELECTRIC

POWER POLE #55BT2053E (FIELD LOCATED)

LOWER WATER UNDER STORM

10"X10"X6" TEE

FH & VALVE

(46)-24" STM @ ~~1.20%~~ 1.12%

(46)-36" STM @ ~~1.00%~~ 1.13%

(46)-36" STM @ ~~0.65%~~ 0.77%

(46)-42" STM @ ~~0.60%~~ 0.51%

(46)-42" STM @ ~~0.70%~~ 0.82%

(41)-42" STM @ ~~0.80%~~ 0.89%

STM 9
CB 2-4
T/GR=~~628.88~~ 629.08
12" INV=~~621.42~~ 621.38
36" INV=~~621.42~~ 621.38

STM 11
CB 2-4
T/GR=~~628.88~~ 628.85
12" INV=~~621.41~~ 620.75
36" INV=~~620.47~~ 620.25
42" INV=~~620.47~~ 620.25

STM 13
CB 2-4
T/GR=~~628.88~~ 628.75
12" INV=~~621.41~~ 621.15
42" INV=~~619.50~~ 619.50

STM 15
CB 2-4
T/GR=~~628.88~~ 628.90
12" INV=~~621.35~~ 621.20
42" INV=~~618.67~~ 618.80

STM 3
CB 2-2-B
T/GR=~~634.66~~ 634.63
15" INV=~~630.70~~ 630.83

(54)-15" STM @ ~~4.00%~~ 3.64%

8"INV=626.36
10"INV=626.19

2-45° BENDS

STM 7
CB 2-4
T/GR=~~628.88~~ 628.98
12" INV=~~624.84~~ 624.58
24" INV=~~622.88~~ 623.13
36" INV=~~622.88~~ 623.03

10"X10"X10" TEE

STM 4
CLEAN OUT
T/GR=630.08
8" INV=626.35
10" INV=625.70
12"INV=625.52

STM 8
CLEAN OUT
T/GR=630.08
8"INV=625.86
10"INV=625.69
12"INV=622.08

STM 10
CLEAN OUT
T/GR=630.08
8" INV=625.85
10" INV=625.68
12" INV=622.08

STM 12
CLEAN OUT
T/GR=630.08
8" INV=625.86
10" INV=625.69
12" INV=622.08

STM 14
CLEAN OUT
T/GR=630.08
4" INV=626.18
8" INV=625.85
10" INV=625.68
12" INV=622.08

STM 16
CLEAN OUT
T/GR=630.08
8" INV=626.35
10" INV=625.70
12" INV=622.08

8" FIRE

67'-12" STM @ 1.00%

70'-12" STM @ 1.00%

10"X10"X8" TEE

LOWER WATER UNDER STORM

25.00'

A. 47'-8" STM @ 1.00%
B. 7'-8" STM @ 6.70%
C. 2'-10" STM @ 1.00%
D. 7'-4" STM @ 7.15%
E. 48'-10" STM @ 1.00%
F. 7'-8" STM @ 6.86%

G. 59'-8" STM @ 1.00%
H. 10'-8" STM @ 5.90%
I. 39'-10" STM @ 1.00%
J. 10'-4" STM @ 8.30%
K. 7'-8" STM @ 11.71%

L. 59'-8" STM @ 1.00%
M. 10'-8" STM @ 5.90%
N. 38'-10" STM @ 1.00%
O. 7'-8" STM @ 13.86%

P. 59'-8" STM @ 1.00%
Q. 10'-8" STM @ 5.90%
R. 27'-10" STM @ 1.00%
S. 10'-4" STM @ 8.70%
T. 12'-10" STM @ 1.00%
U. 7'-8" STM @ 14.00%

V. 59'-8" STM @ 1.00%
W. 10'-8" STM @ 5.90%
X. 38'-10" STM @ 1.00%
Y. 7'-8" STM @ 13.86%

Z. 59'-8" STM @ 1.00%
AA. 10'-8" STM @ 5.90%
BB. 39'-10" STM @ 1.00%
CC. 10'-4" STM @ 9.90%
DD. 7'-8" STM @ 14.00%

EE.
FF.
GG.
HH.
II.
JJ.
KK.

POWER POLE (FIELD LOCATED)

POWER POLE BY OTHERS

ELECTRIC BY OTHERS

Ex.CB #4-6.43 Ex. 8" INV=~~6.43~~

Ex.CB #4-6.43 Ex. 8" INV=~~6.43~~

STM 26
CLEAN OUT
T/GR=633.96
8" INV=628.35
15" (E)INV=627.77
15" (S)INV=625.73

45° BEND

8"X8"X6" TEE

11'-6" SAN @ 3.50%

55'-15" STM @ 3.00%

FH & VALVE

SAN CONTROL MH C
T/RIM=633.89
INV=624.73

SAN MH A
WITH OUTSIDE DROP ASSEMBLY
T/RIM=632.57
INV=623.50 (N)
INV=613.32 (S)

SANITARY AS-BUILT LOCATION

STM 27
KENTUCKY STD HW
RDH-110-02
INV=~~625.18~~ 624.66

STORM OUTLET SPREADER
6'X10'X18"
RCP TYPE C
SEE DETAIL SHEET C9

POWER POLE #55BT2055E (FIELD LOCATED)

345'-8" S SAN LAT @1.97% PROFILE A (SEE SHEET C7)

STM 28
CLEAN OUT
T/GR=633.96
8" INV=628.85
15" INV(W)=628.27
15" INV(S)=625.73

STM 29
KENTUCKY STD HW
RDH-110-02
INV=~~624.89~~ 624.74

84'-15" STM @ 1.00%

8"X8"X6" TEE

STORM OUTLET SPREADER
6'X10'X18"
RCP TYPE C
SEE DETAIL SHEET C9

STM 30
CLEAN OUT
T/GR=633.96
8" INV=630.48
15" (W)INV=628.27
15" (S)INV=625.73

STM 31
KENTUCKY STD HW
RDH-110-02
INV=~~625.18~~ 624.99

STORM OUTLET SPREADER
6'X10'X18"
RCP TYPE C
SEE DETAIL SHEET C9

STM 32
CB 2-2-B
T/GR=633.96
8" INV=630.48
15" (E)INV=628.26
15" (S)INV=625.73

STM 33
KENTUCKY STD HW
RDH-110-02
INV=~~625.18~~ 625.14

STORM OUTLET SPREADER
6'X10'X18"
RCP TYPE C
SEE DETAIL SHEET C9

55'-15" STM @ 1.00%

22.5° BE

PRECAST MANHOLE SECTION JOINTS SHALL BE FORMED ENTIRELY OF CONCRETE EMPLOYING A ROUND, WEDGE SHAPED PROFILE GASKET, PRESS SEAL TYPE TP OR EQUAL, AND WHEN ASSEMBLED SHALL BE SELF CENTERING AND MAKE A UNIFORM WATERTIGHT JOINT CONFORMING TO ASTM C 443. THE JOINT SHALL ALSO BE SEALED WITH A BITUMINOUS MASTIC JOINT SEALING COMPOUND SUCH AS CONCRETE SEALANTS, INC. "CON SEAL", OR EQUAL.

THE MANHOLE FRAME AND COVER SHALL BE OF HEAVY DUTY, WATERTIGHT TYPE WITH GASKET SEAL AND BOLTED LID WITH STAINLESS STEEL BOLTS. THE LID SHALL HAVE A CONCEALED PICKHOLE. THE MANHOLE FRAME SHALL BE ANCHORED THROUGH THE ANCHOR BASE FLANGE TO THE MANHOLE CONE SECTION WITH FOUR ¾" X 9" STAINLESS STEEL ANCHOR BOLTS. WATERTIGHT MANHOLE FRAMES AND COVERS SHALL BE NEENAH R-1916-F, EAST JORDAN 1040-PT, OR EQUAL.

SAN MH E
(SEE NOTES LEFT)
T/RIM=614.00
INV=606.52

62'-5" LAT @2.25% SAN

CONNECT TO EX. SANITARY 6" INV=604.94 30" INV=602.94

Ex.San.M.H. Inv.=601.27

Ex.30"San

Ex.30"San @0.46%

Ex.30"San @0.47%

Ex.30"San @0.50%

Ex.10'S.S.E.

EX SAN MH
EX 30" INV=598.43
(NOT FIELD INV)

EX S

EX OHE

OHE

S


Item	Revision Description	Date	Dwn'd	Chk'd
1	ISSUED FOR PERMIT	06-04-07	JLR	RWB
2	BULLETIN C1: REVISED PER INTERNAL	06-07-07	JLR	RWB
3	BULLETIN C2: PER WEST CHESTER, BOC'S & CONTRACTOR	06-25-07	JLR	RWB
4	BULLETIN C5: PER BOCES	07-10-07	JLR	RWB
5	BULLETIN C4: REVISED WATERMAIN PER BOCES	07-20-07	JLR	RWB
6	BULLETIN C6: REVISED STORM PER FIELD	08-09-07	JLR	RWB
7	BULLETIN C7: REVISED SANITARY	08-16-07	JLR	RWB
8	BULLETIN C8: ADD ELECTRIC AND CABLE	10-03-07	JLR	RWB
9				

THESE DRAWINGS ARE THE PROPERTY OF BAYER BECKER AND ARE NOT TO BE USED IN WHOLE OR IN PART, AND ARE NOT TO BE LOANED, COPIED OR REPRODUCED WITHOUT WRITTEN PERMISSION OF BBE. AND IS DONE SO AT USER'S SOLE RISK. COPYRIGHT ALL RIGHTS RESERVED

bayer becker
www.bayerbecker.com
710 Nilles Road
Fairfield, OH 45014 513.829.2149

Drawing: 06F070ST
Drawn by: JLR
Checked By: RWB
Issue Date: 06-04-07
Sheet: C6

Plot time: Oct 15, 2007 - 5:12pm
Drawing name: J:\2006\06F070-000\CIV\DWG\06F070ST.dwg - Layout Tab: C06 UTILITY CC

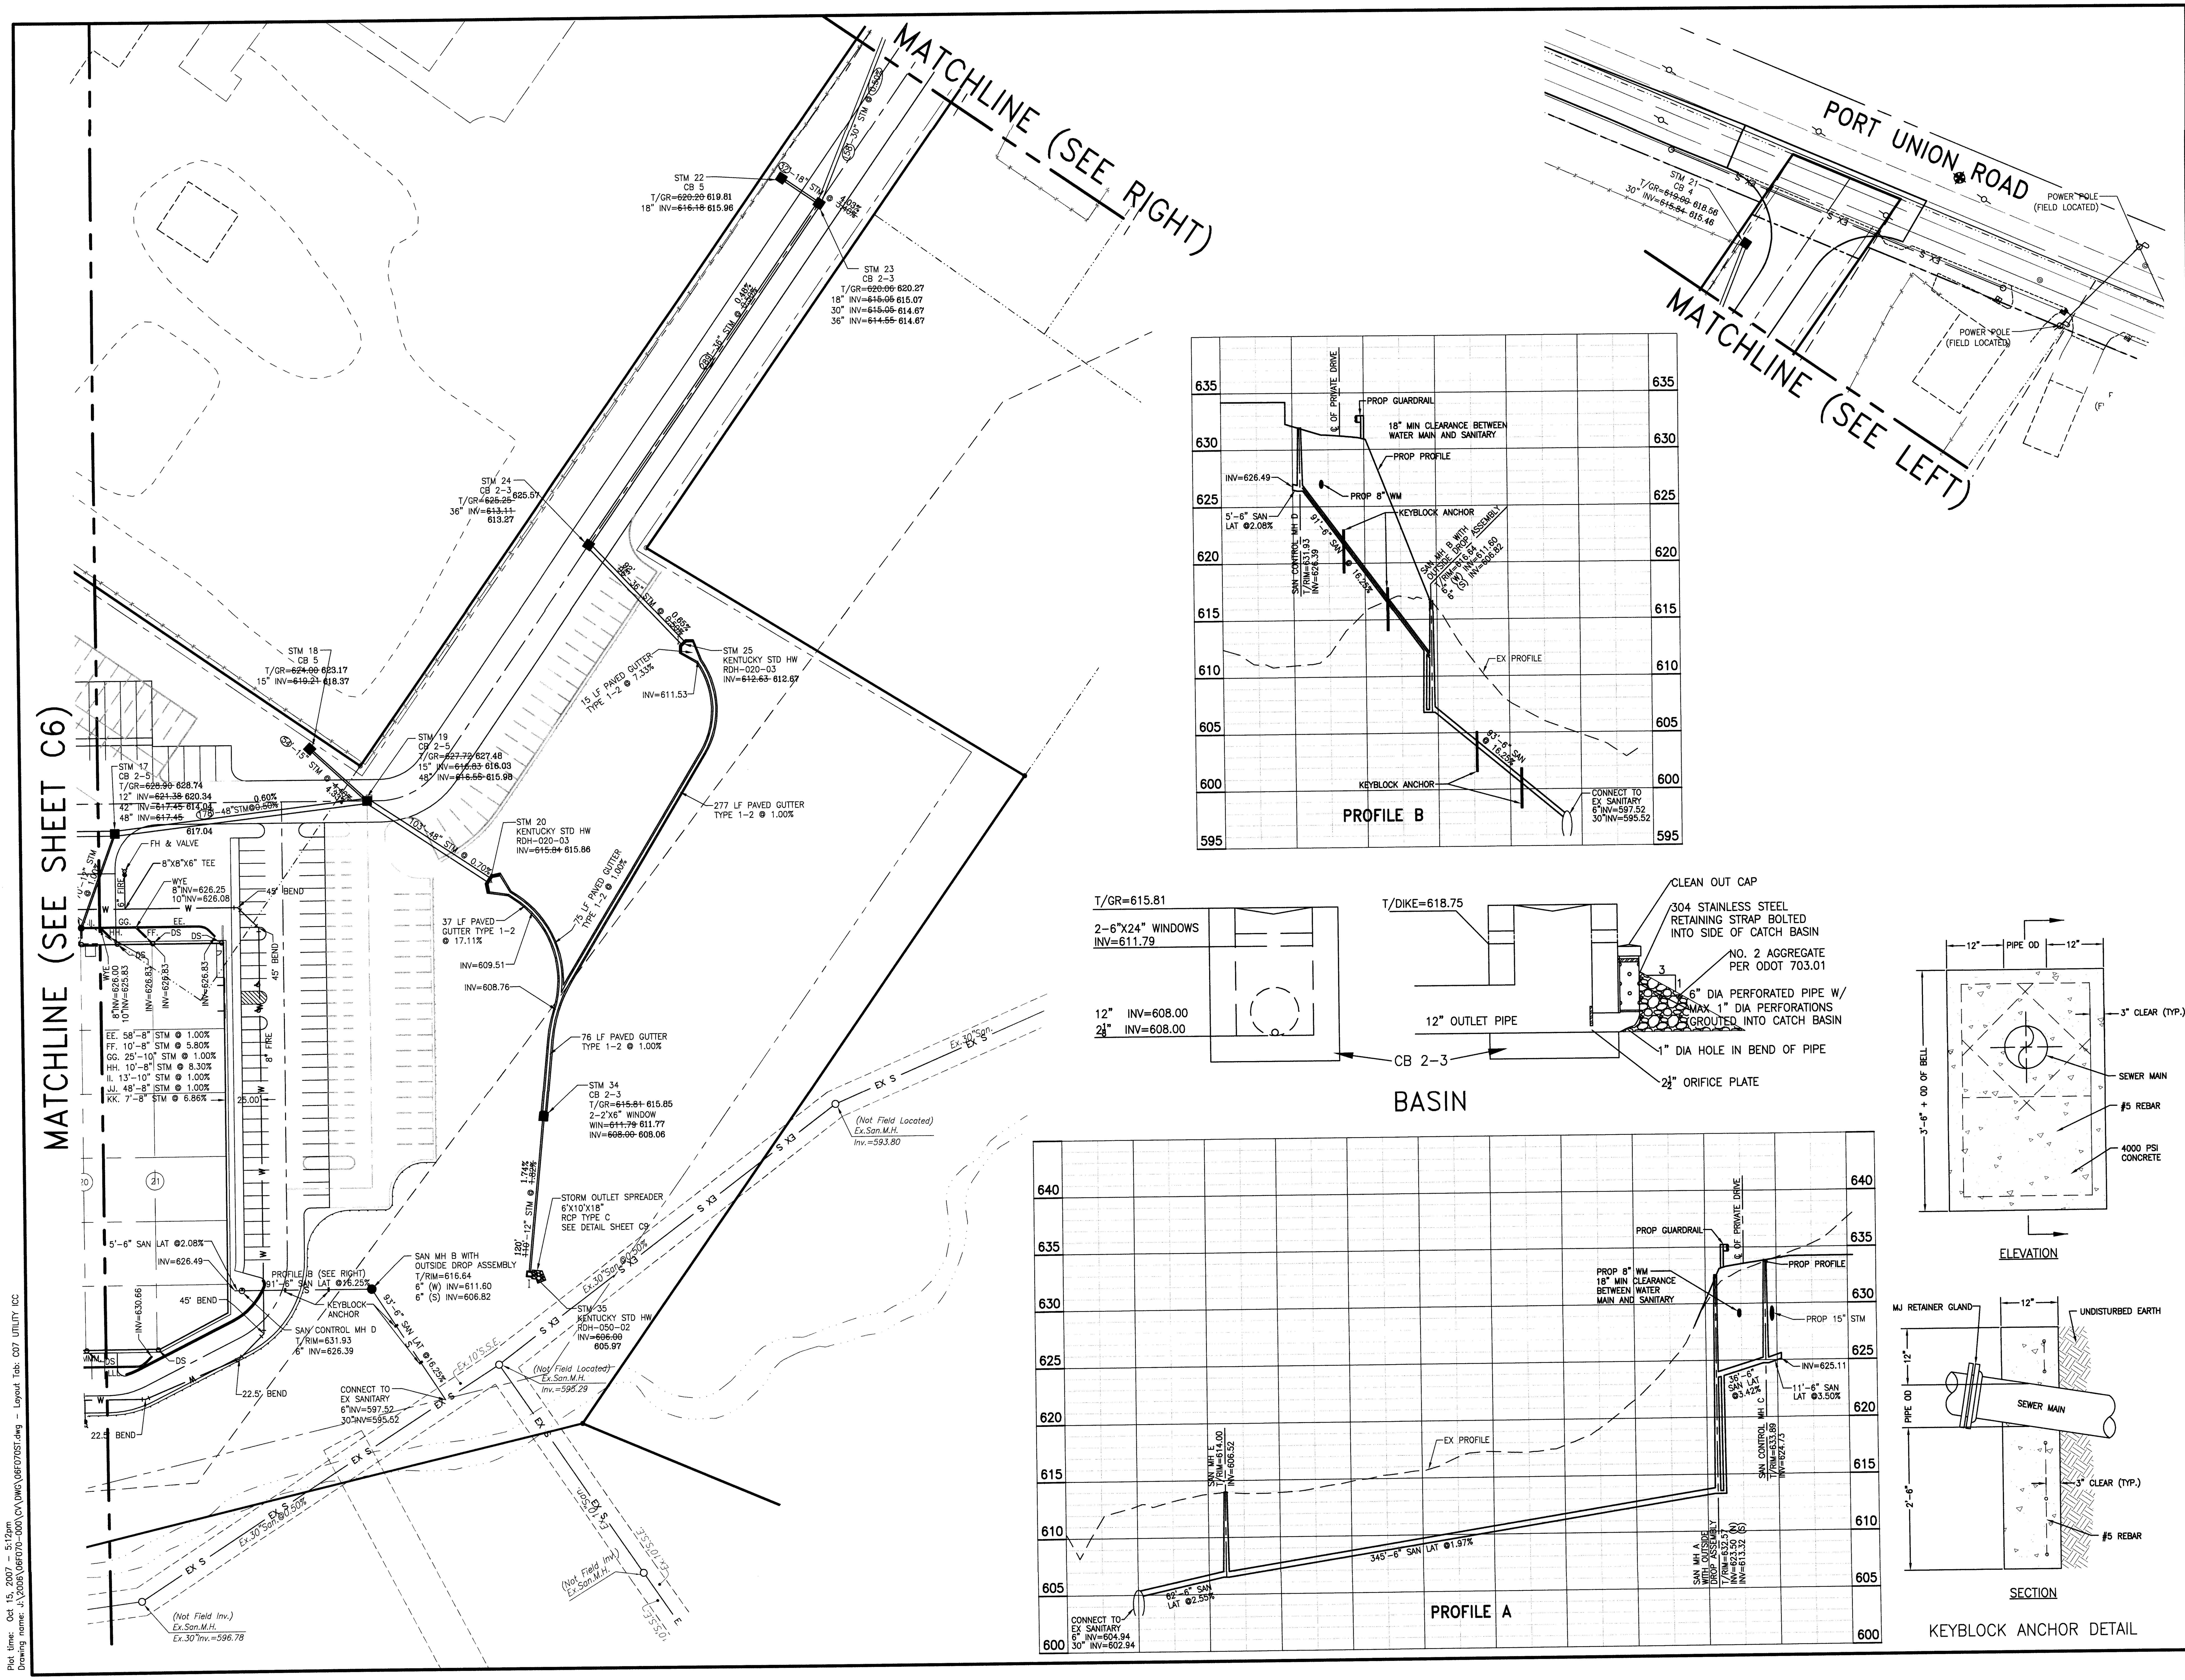

Robert W. Bailey 11-30-07

Item	Revision Description	Date	Drwn:	Chk:
1	ISSUED FOR PERMIT	06-04-07	JLR	RWB
2	BULLETIN C1: REVISED PER INTERNAL	06-07-07	JLR	RWB
3	BULLETIN C2: PER WEST CHESTER, BCEO, & CONTRACTOR	06-25-07	JLR	RWB
4	BULLETIN C3: PER BCDES	07-10-07	JLR	RWB
5	BULLETIN C4: REVISE STORM AND ADD PAVED GUTTER	07-20-07	JLR	RWB
6	BULLETIN C5: REVISED STORM PER FIELD	08-07-07	MJL	RWB
7	BULLETIN C6: REVISED SANITARY PER EPA	08-09-07	JLR	RWB
8	BULLETIN C7: REVISED PROFILE A PER SANITARY REVISIONS	09-06-07	JLR	RWB
9				

INTERSTATE COMMERCE CENTER I
4520 LeSANT COURT
FAIRFIELD OHIO 45014
WEST CHESTER TOWNSHIP, BUTLER COUNTY OHIO
SECTION 9, TOWN 2, RANGE 2


UTILITY PLAN


bayer becker
www.bayerbecker.com
700 Nilles Road
Fairfield, OH 45014 - 513.829.2149

Drawing: 06F070ST
Drawn by: JLR
Checked By: RWB
Issue Date: 06-04-07
Sheet: C7

THIS DOCUMENT AND ALL RELATED DETAIL DRAWINGS, SPECIFICATIONS, AND ELECTRONIC MEDIA PREPARED OR FURNISHED BY BAYER BECKER (BB), ARE INSTRUMENTS OF BB'S PROFESSIONAL SERVICE, AND IS THE EXCLUSIVE PROPERTY OF BB. NO DISCLOSURE, USE, REPRODUCTION, OR DUPLICATION IN WHOLE, OR IN PART, MAY BE MADE WITHOUT WRITTEN PERMISSION OF BB, AND IS DONE SO AT USER'S SOLE RISK. COPYRIGHT - ALL RIGHTS RESERVED.

Plot time: Oct 15, 2007 - 5:12pm
Drawing name: J:\2006\06F070-000\CV\DWG\06F070ST.dwg - Layout Tab: C07 UTILITY ICC

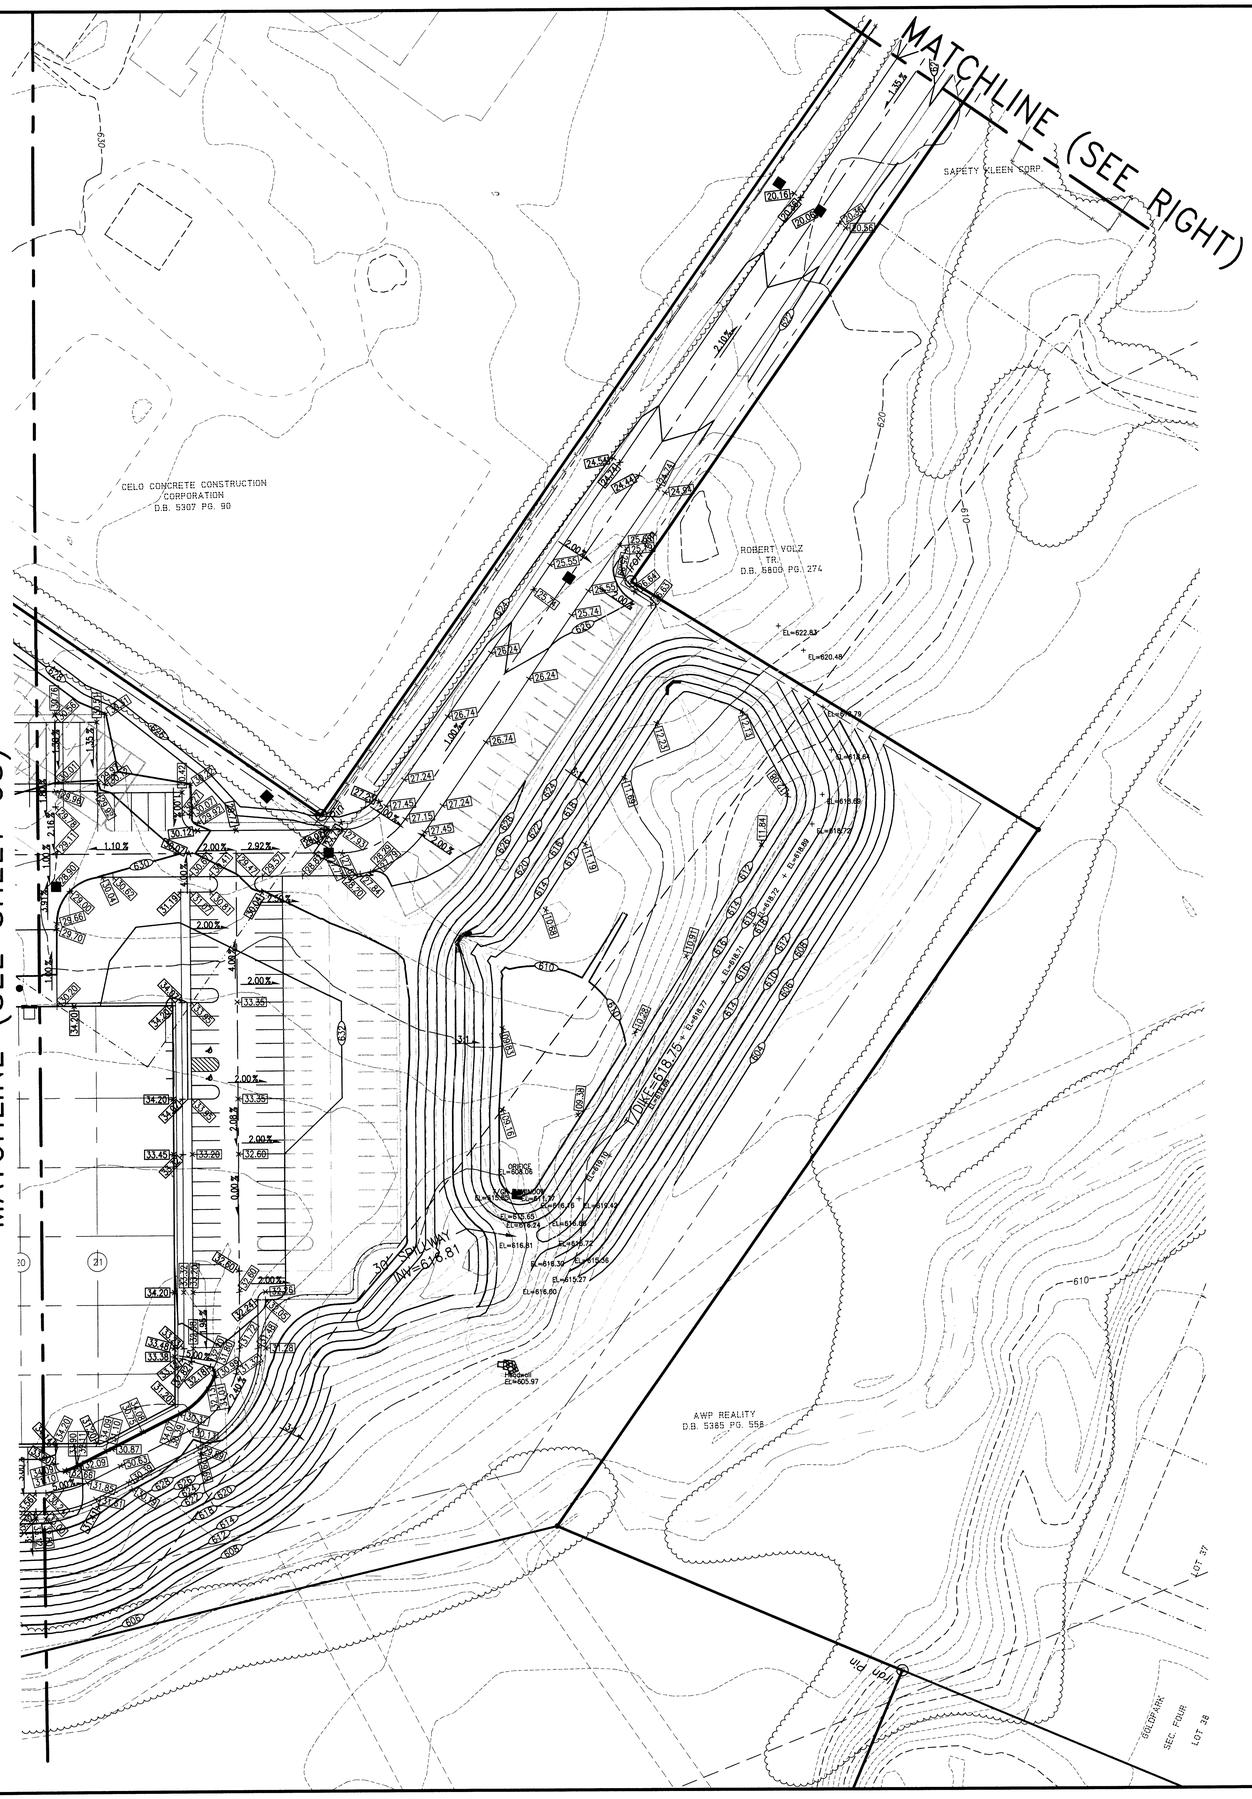

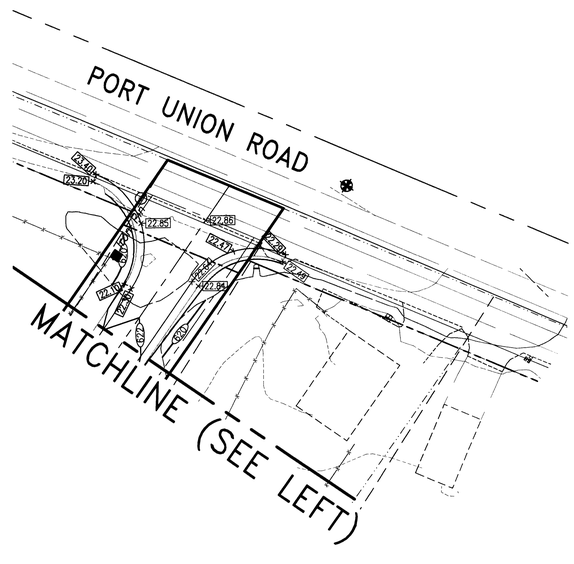


EROSION CONTROL NOTES

1. SEEDING AND MULCHING
3. PRESERVE EXISTING VEGETATION
5. SILT FENCE
19. CHECK DAMS
21. CONSTRUCTION ENTRANCE
25. DANDY BAG

SEE EROSION CONTROL DETAIL SHEET FOR EROSION CONTROL DETAILS

NOTE:
FOR HEADWALLS #27, 29, & 35
EROSION CONTROL MAT SHALL BE INSTALLED IF GROUND SURFACE DOWNSTREAM OF HEADWALL AND ROCK CHANNEL PROTECTION IS DISTURBED AND/OR THE EXISTING VEGETATION IS NOT EFFECTIVE FOR MAINTAINING THE SLOPE. IF EROSION CONTROL MAT IS NOT INSTALLED, IT WILL BE OBSERVED FOR A PERIOD OF NOT LESS THAN ONE YEAR FROM COMPLETION OF CONSTRUCTION, AND IF EROSION DOES BEGIN TO OCCUR THEN EROSION CONTROL MAT SHALL BE INSTALLED WHERE EROSION IS TAKING PLACE.

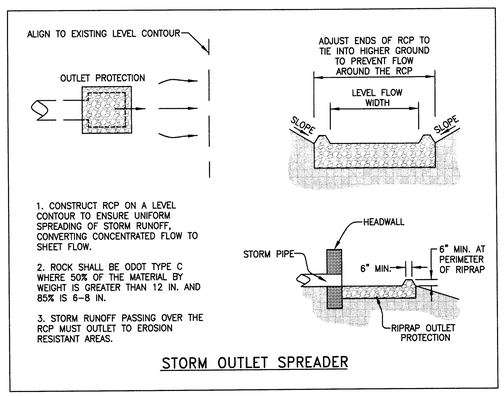

STORM OUTLET SPREADER

SCALE: 1" = 40'

Robert W. Becker 11-30-07

Item	Revision Description	Date	Dwn.	Chk.
1	ISSUED FOR PERMIT	06-04-07	JLR	RWB
2	BULLETIN C1: REVISED PER INTERNAL	06-07-07	JLR	RWB
3	BULLETIN C2: PER WEST CHESTER, BCED, & CONTRACTOR	06-25-07	JLR	RWB
4	BULLETIN C4: REVISE GRADING IN DETENTION BASIN FOR PAVED GUTTER	07-26-07	JLR	RWB
5	BULLETIN C5: REVISE GRADING IN DETENTION BASIN FOR PAVED GUTTER	08-07-07	JLR	RWB
6	BULLETIN C7: REVISE TRACTOR PARKING LOT, NEW LAYOUT	09-04-07	JLR	RWB
7	BULLETIN C8: REVISE GRADING, LOT GRADING	10-05-07	JLR	RWB
8	DETENTION BASIN AS-BUILT	10-19-07	JLR	RWB
9				

INTERSTATE COMMERCE CENTER I

4520 LeSAINT COURT
FAIRFIELD, OHIO 45014
WEST CHESTER TOWNSHIP BUTLER COUNTY OHIO
SECTION 09, TOWN 2, RANGE 2


GRADING & EROSION CONTROL PLAN

bayer becker
www.bayerbecker.com
700 Nilles Road
Fairfield, OH 45014 513.829.2149

Drawing: 06F070EXFLOODPLAIN
Drawn by: JLR
Checked By: RWB
Issue Date: 06-04-07
Sheet: C9

THIS DOCUMENT AND ALL THE IDEAS, DRAWINGS, SPECIFICATIONS, AND ELECTRONIC MEDIA PREPARED BY BAYER BECKER (DBA) ARE INSTRUMENTS OF BAYER BECKER'S PROFESSIONAL SERVICE AND IS THE EXCLUSIVE PROPERTY OF BB. NO DISCLOSURE, USE, REPRODUCTION OR PUBLICATION IN WHOLE OR IN PART, MAY BE MADE WITHOUT WRITTEN PERMISSION OF BB AND IS NOT TO BE USED AT OTHER SITES. ©2007 ALL RIGHTS RESERVED

Plot time: Oct 19, 2007 – 11:23am
Drawing name: J:\2006\06F070-000\CV\DWG\Support\06F070EXFLOODPLAIN.dwg – Layout Tab: DETASB ICC

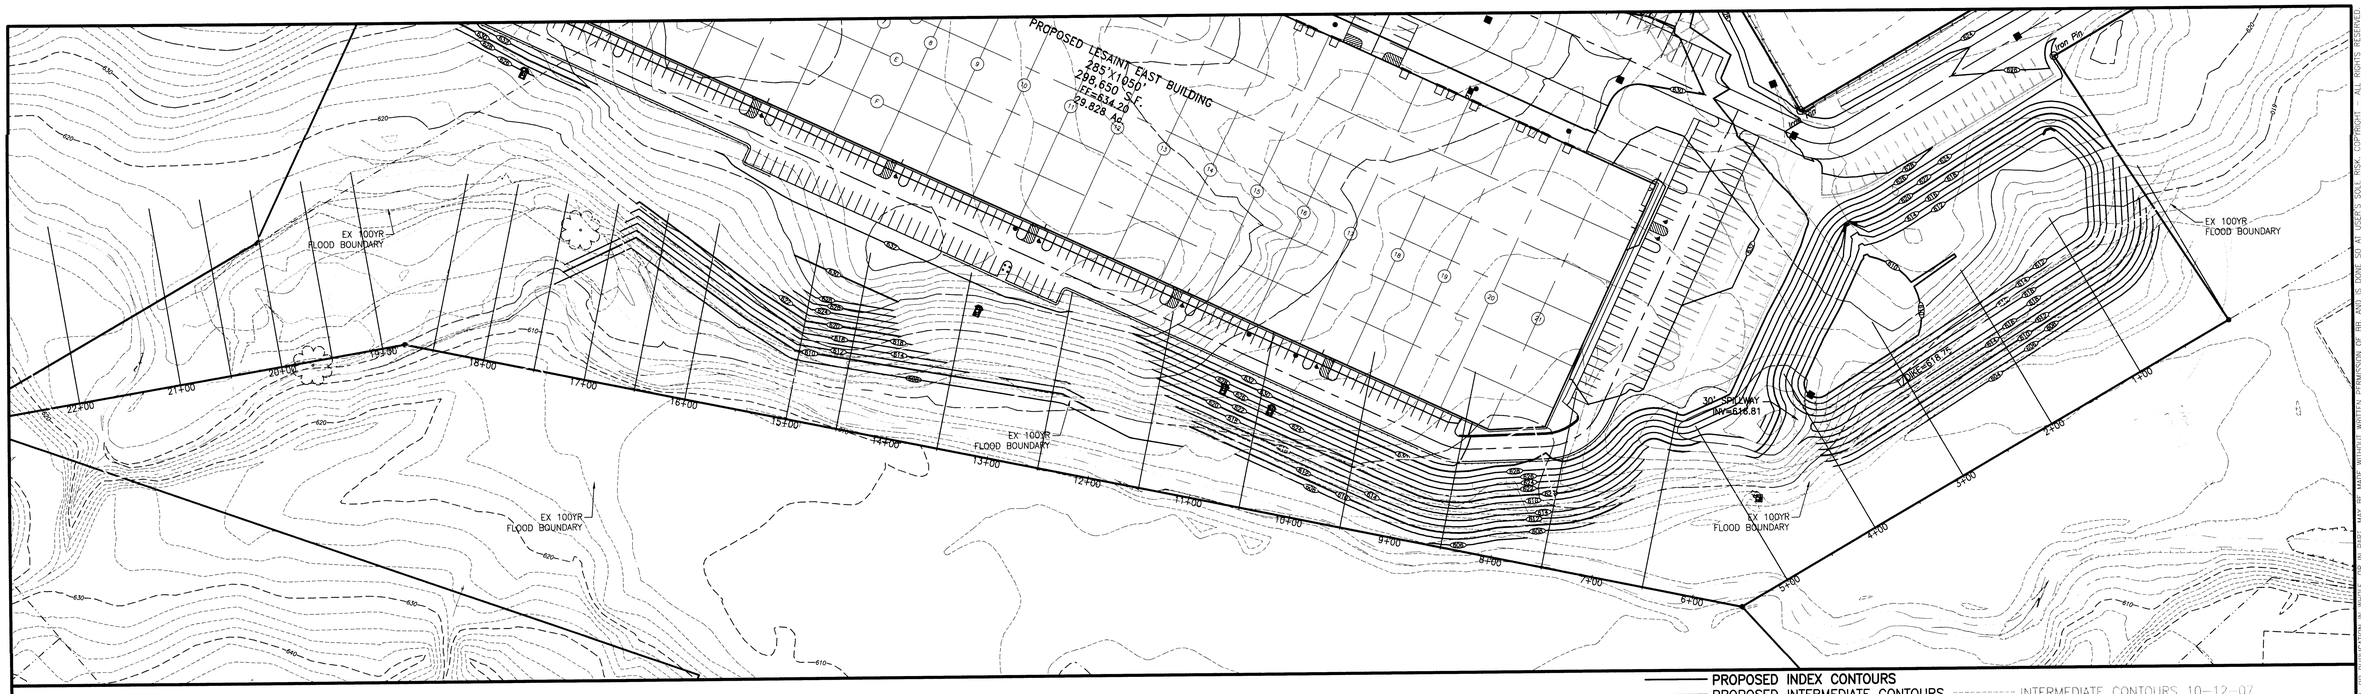

H SCALE: 1" = 60'

— — — BASE MAP

——— AS-BUILT 10-12-07

——— AS-BUILT 11-20-07

▨ FILL IN FLOOD PLAIN

▨ CUT IN FLOOD PLAIN 11-20-07

——— PROPOSED INDEX CONTOURS

——— PROPOSED INTERMEDIATE CONTOURS


– – – – EXISTING INTERMEDIATE CONTOURS


– – – – EXISTING INDEX CONTOURS


· · · · · · INTERMEDIATE CONTOURS 10-12-07

· · · · · · INTERMEDIATE CONTOURS 10-12-07

V SCALE: 1" = 5'

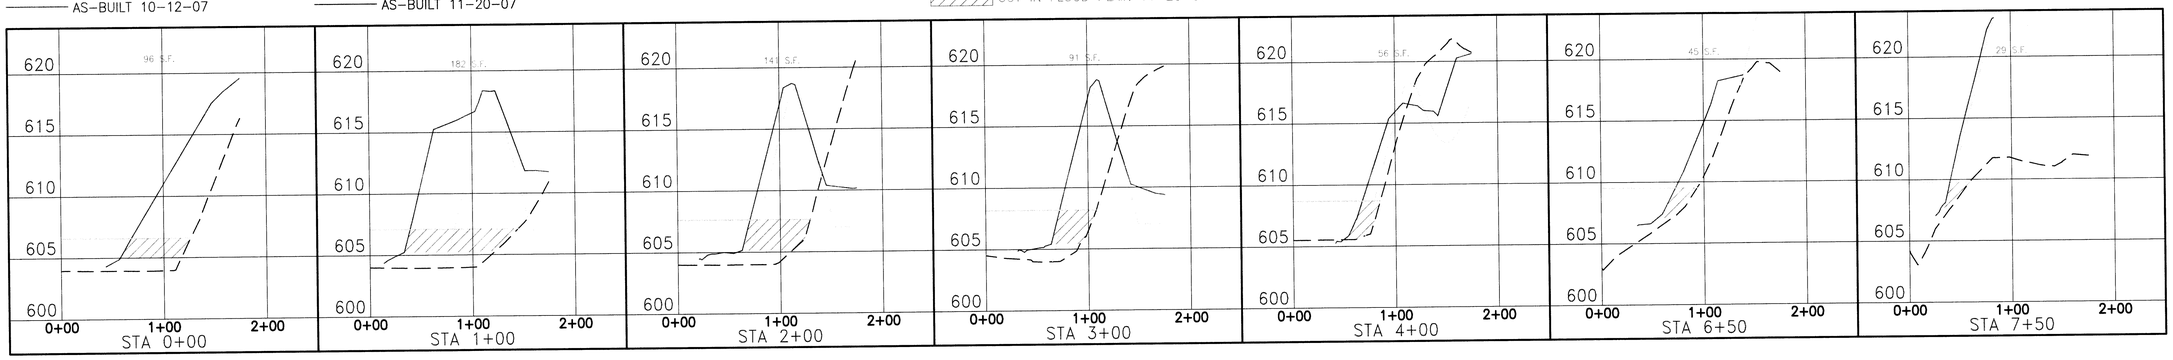

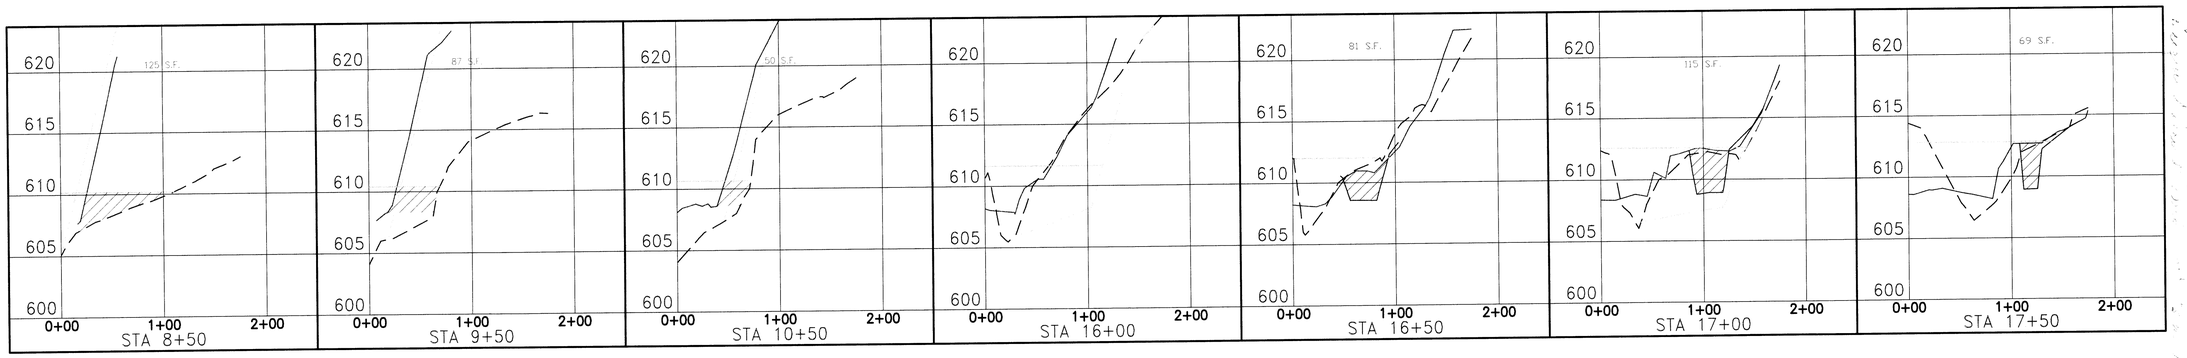

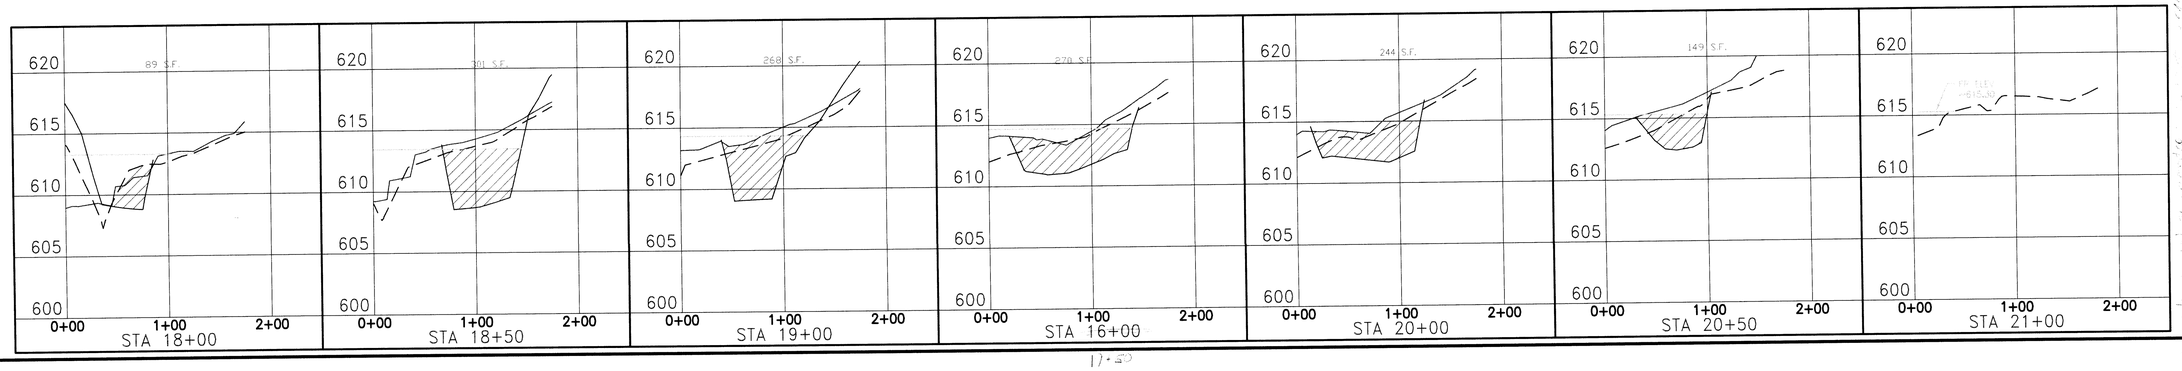

Item	Revision Description	Date	Drwn	Chk
1	TOPO TO DATE	10-18-07	MJL	RWB
2	AS-BUILT DRAWINGS	11-28-07	MJL	RWB
3				
4				
5				
6				
7				
8				
9				

INTERSTATE COMMERCE CENTER I

4520 LeSAINT COURT
FAIRFIELD, OHIO 45014
WEST CHESTER TOWNSHIP, BUTLER COUNTY, OHIO
SECTION 9, TOWN 2, RANGE 2

CUT FILL IN FLOODPLAIN

bayer becker
www.bayerbecker.com
700 Nilles Road
Fairfield, OH 45014 • 513.829.2149

Drawing: 06F070EXFLOODPLAIN
Drawn by: MJL
Checked by: RWB
Issue Date: 10-17-07
Sheet: EX-1

THIS DOCUMENT AND ALL RELATED DETAIL DRAWINGS, SPECIFICATIONS, AND ELECTRONIC MEDIA PREPARED BY OR FURNISHED BY BAYER BECKER (BB), ARE INSTRUMENTS OF BB'S PROFESSIONAL SERVICE AND IS THE EXCLUSIVE PROPERTY OF BB. NO DISCLOSURE, USE, REPRODUCTION OR PUBLICATION IN WHOLE OR IN PART, MAY BE MADE WITHOUT WRITTEN PERMISSION OF BB. ANY & SOME RIGHTS RESERVED

Robert J. Becker 11-30-07

Plot time: Nov. 30, 2007 - 9:01am
Drawing name: J:\2006\06F070-000\CV\DWG\Support\06F070EXFLOODPLAIN.dwg - Layout Tab: EX-1 CUTFILL ICC