

INSPIRED PEOPLE ▲ TRANSFORMING COMMUNITIES


INSPIRED PEOPLE ▲ CREATIVE DESIGN

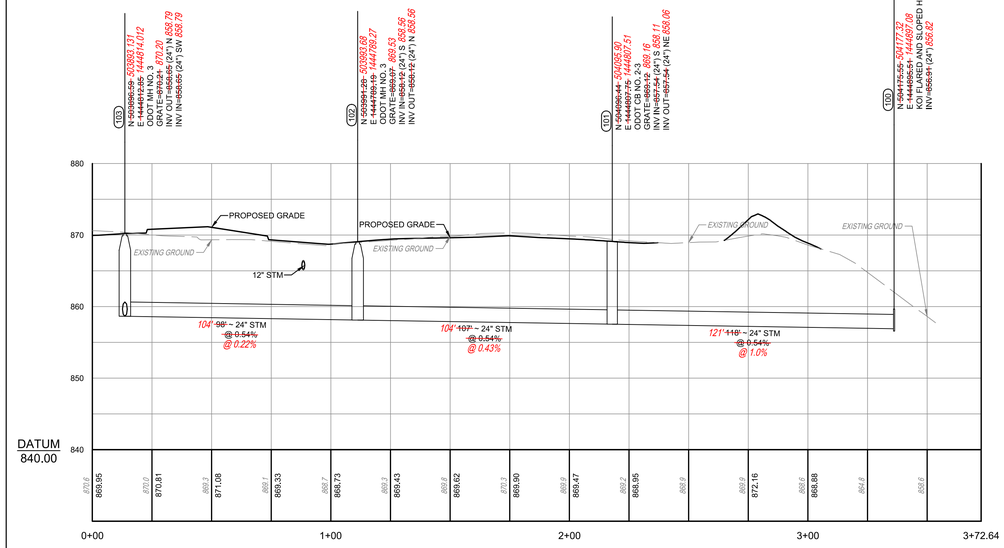


1 C141 MH-103 TO MH-100

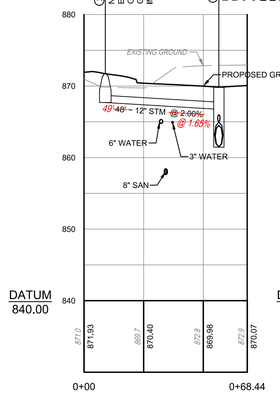


2 C141 CB-204 TO CB-203

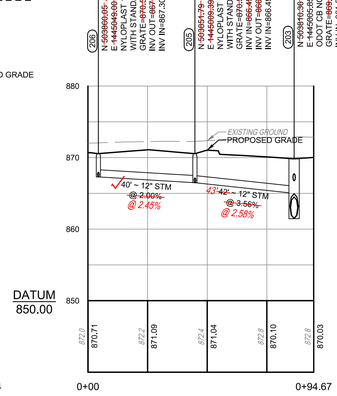


3 C141 YD-206 TO CB-203

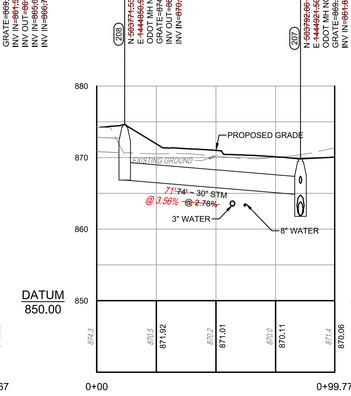


4 C141 MH 208 TO MH-207

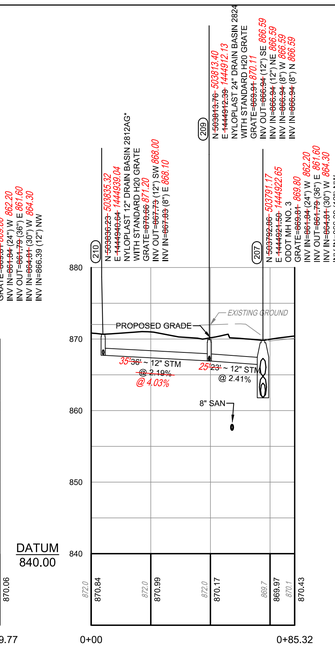


5 C141 YD-210 TO MH-207

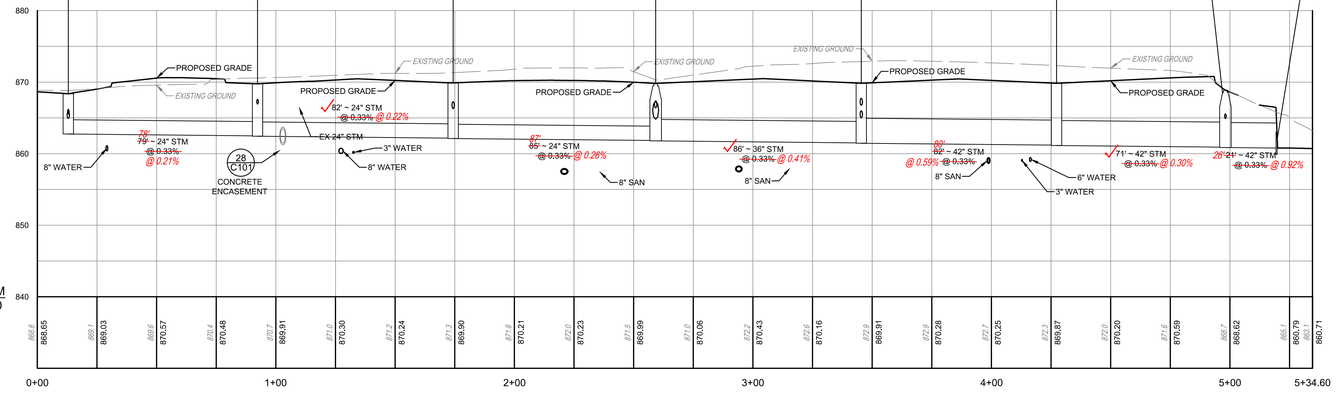

6 C141 CB-214 TO HW-200

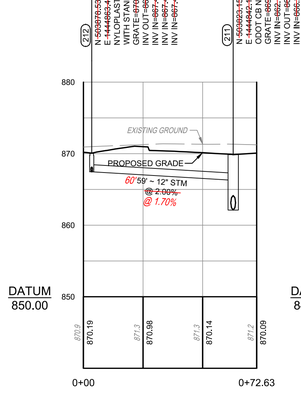

7 C141 YD-212 TO CB-211

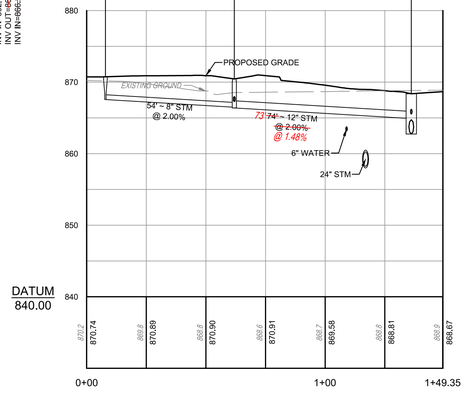

5 C141 CO-216 TO CB-214

*OR APPROVED EQUAL

Know what's below. Call before you dig. 811

OHIO Utilities Protection SERVICE 811 or 1-800-362-2764 Call Before You Dig

THE KLEINGERS GROUP

CIVIL ENGINEERING
SURVEYING
LANDSCAPE ARCHITECTURE

www.kleingers.com
6305 Centre Park Dr.
West Chester, OH 45069
513.779.7851

SEAL:

STATE OF OHIO
STEVEN R. KORTE
E-61033
REGISTERED PROFESSIONAL ENGINEER

NO.	DATE	DESCRIPTION
1	6/12/2015	PRELIMINARY P.U.D. - MAJOR MOD.
2	8/14/2015	FINAL P.U.D.
3	4/03/2017	AS BUILTS - NSB

FINAL P.U.D.

CLARITY POINTE MEMORY CARE

SECTION 7, TOWN 3, RANGE 3
LIBERTY TOWNSHIP
BUTLER COUNTY, OHIO
FOR: HERITAGE DEVELOPMENT PARTNERS, LLC

PROJECT NO: 150275.000

DATE: 8/14/15

SCALE: H: 1" = 30' V: 1" = 10'
V 0 5 10 20
H 0 15 30 60

SHEET NAME:

STORM SEWER PROFILES

SHEET NO.

C141

H:\2015\150275\DWG\800\150275HM800 SEWER AS BUILTS - C141-43 UTILITY PLAN.dwg, 4/14/2017 10:19:25 AM, rbenke