

Storm As Built 10-28-05

ETTA M. REED E-61609 REGISTERED PROFESSIONAL ENGINEER STATE OF OHIO

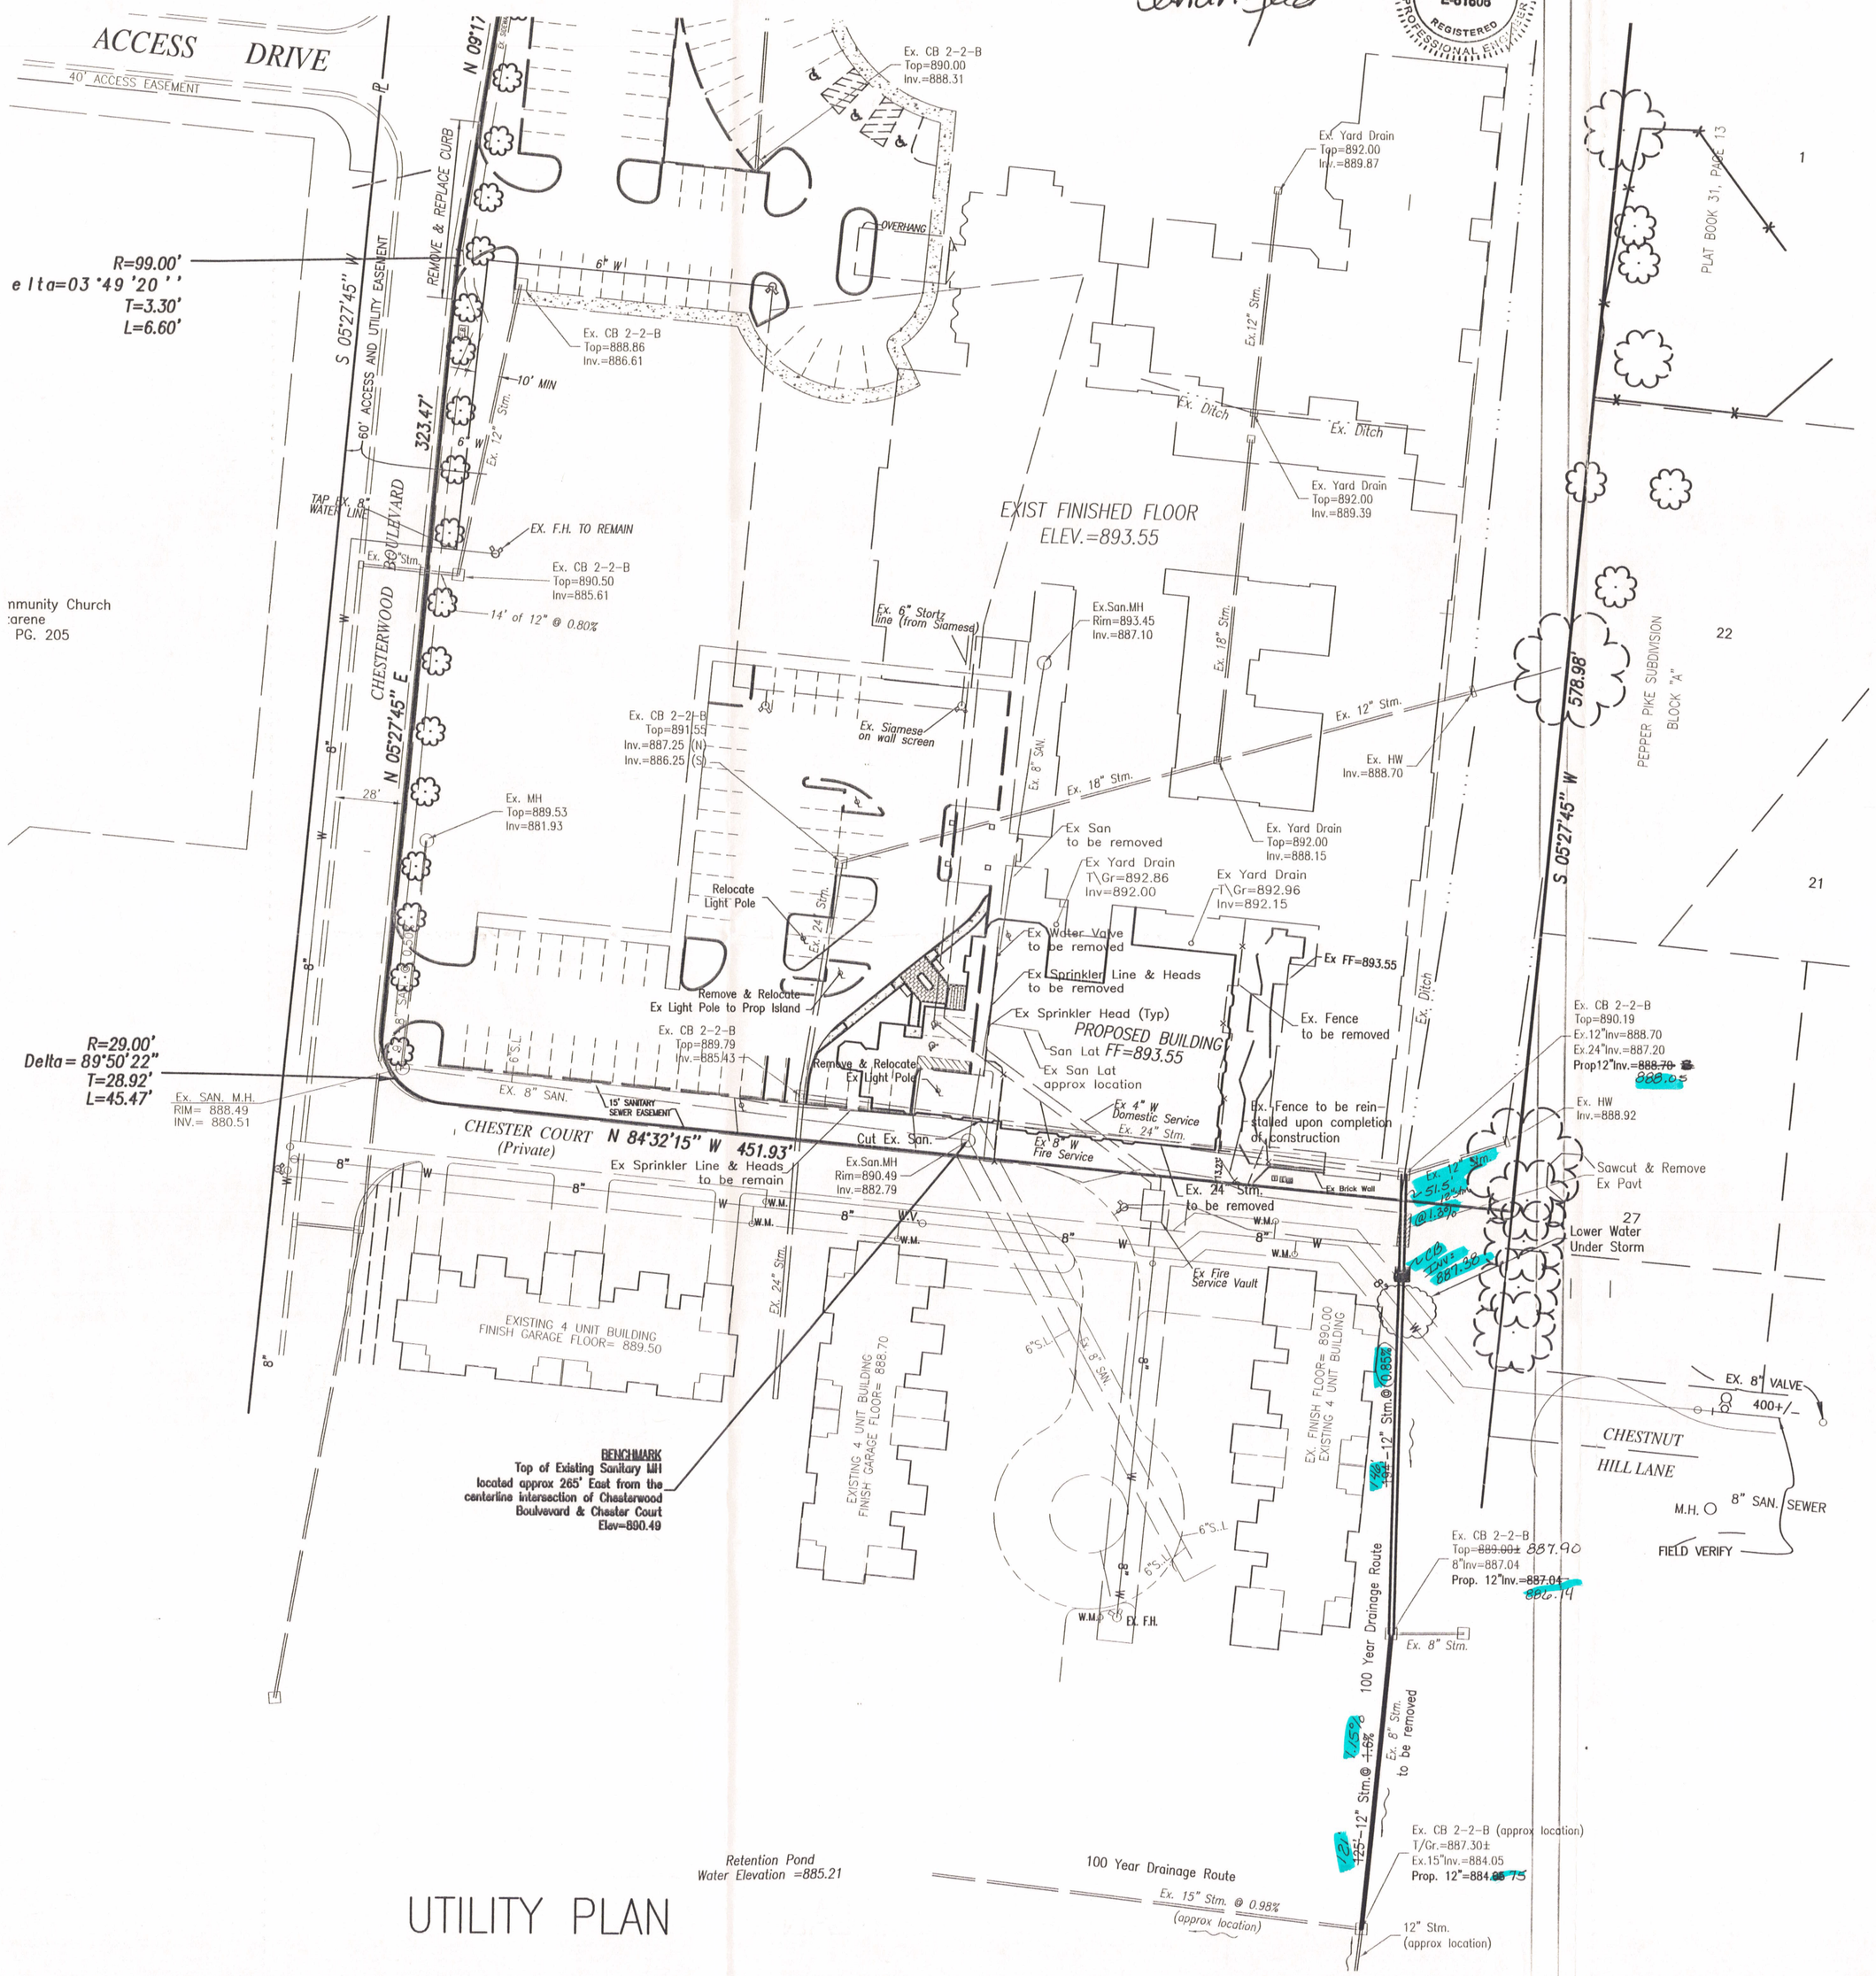

UTILITY PLAN

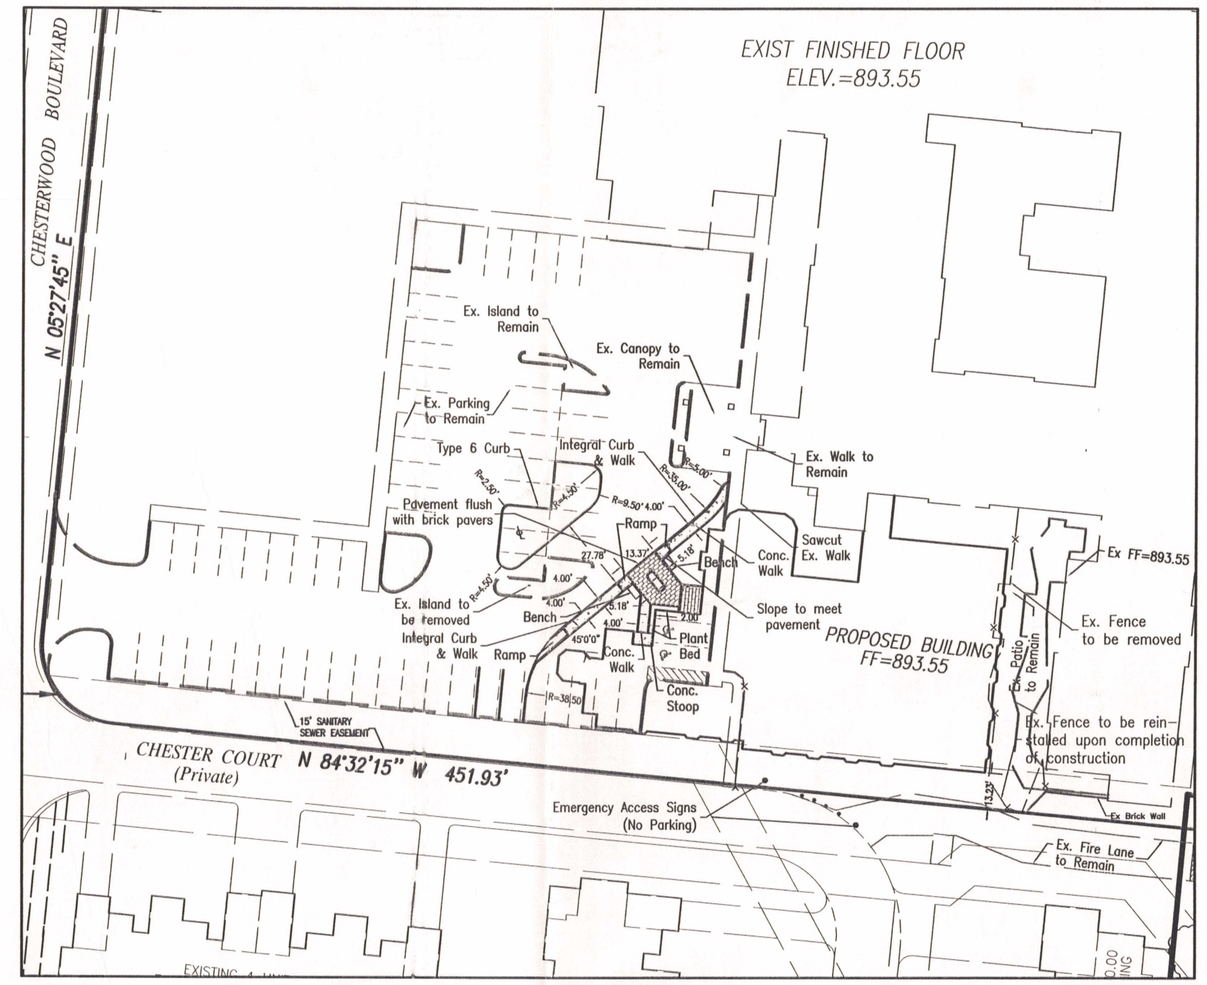


SITE PLAN


EROSION CONTROL LEGEND

1. SEEDING AND MULCHING
2. SEEDING
3. PRESERVING EXISTING VEGETATION
4. STRAW BALE
5. SILT FENCE
9. BLOCK & GRAVEL DROP INLET SEDIMENT FILTER

"All sediment and erosion control measures must be visually inspected and the appropriate maintenance and repair actions taken whenever precipitation exceeds 1/2 inch in any 24 hour period."

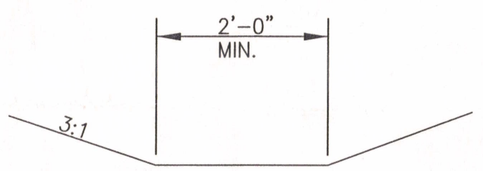

TYPICAL DITCH SECTION

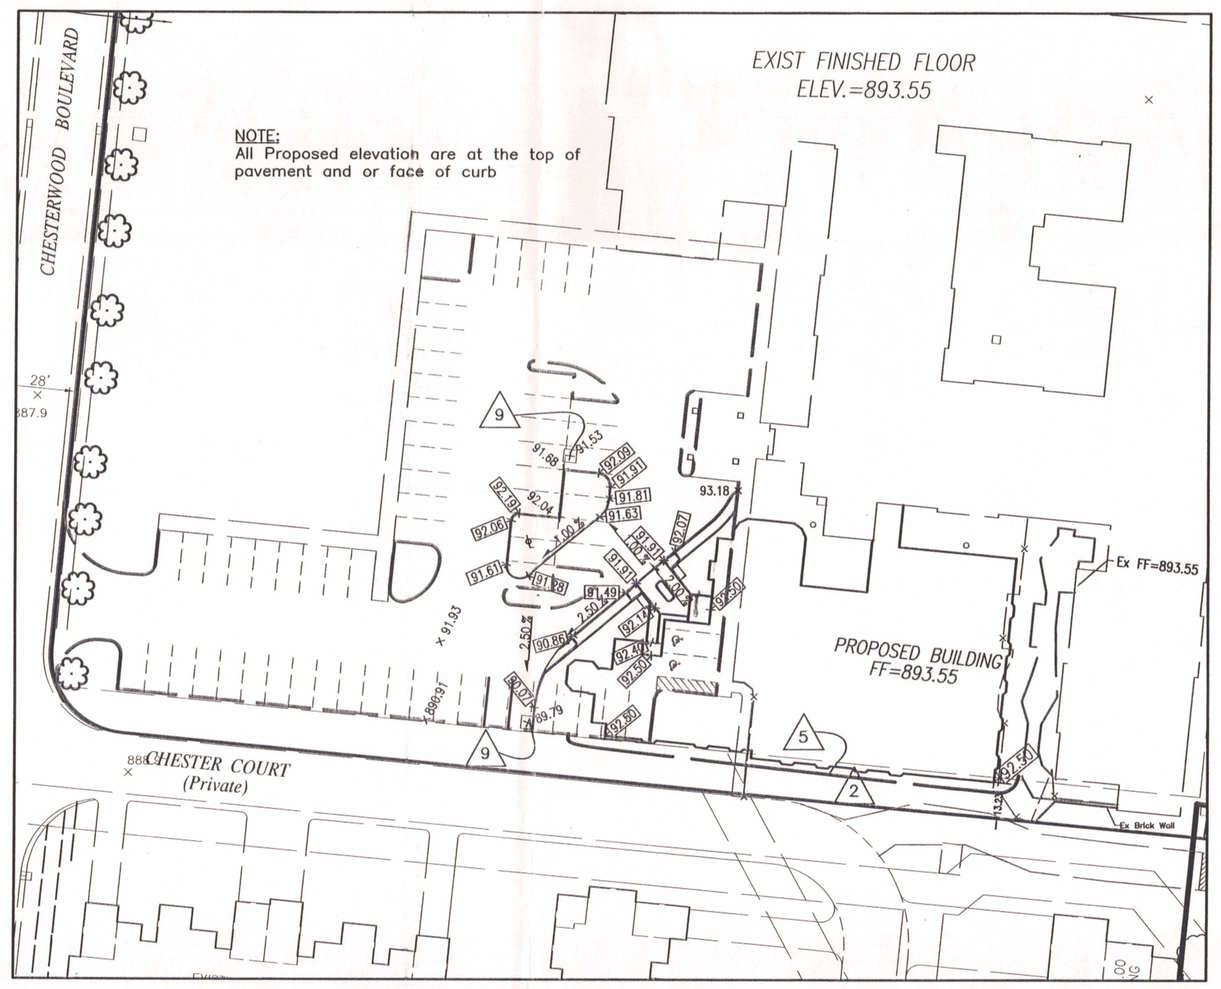

GRADING PLAN

engineers planners architects surveyors
bayer becker
700 Nilles Rd. Fairfield, OH 45014 513-829-8149

SCALE: 1" = 40'

NO.	REVISION	DATE
1	Per Butler County Comments	5-02-03
2		
3		
4		
5		
6		
7		

CHESTERWOOD VILLAGE ASSIST. LIVING ADDITION

WEST CHESTER TOWNSHIP, BUTLER COUNTY OHIO

SITE, UTILITY & GRADING PLAN

DRAWN BY:	ELB
CHECKED BY:	RWB
JOB NO.:	02167
FILE NAME:	M02167.dwg
ISSUE DATE:	12/20/02

DRAWING NO:

C100