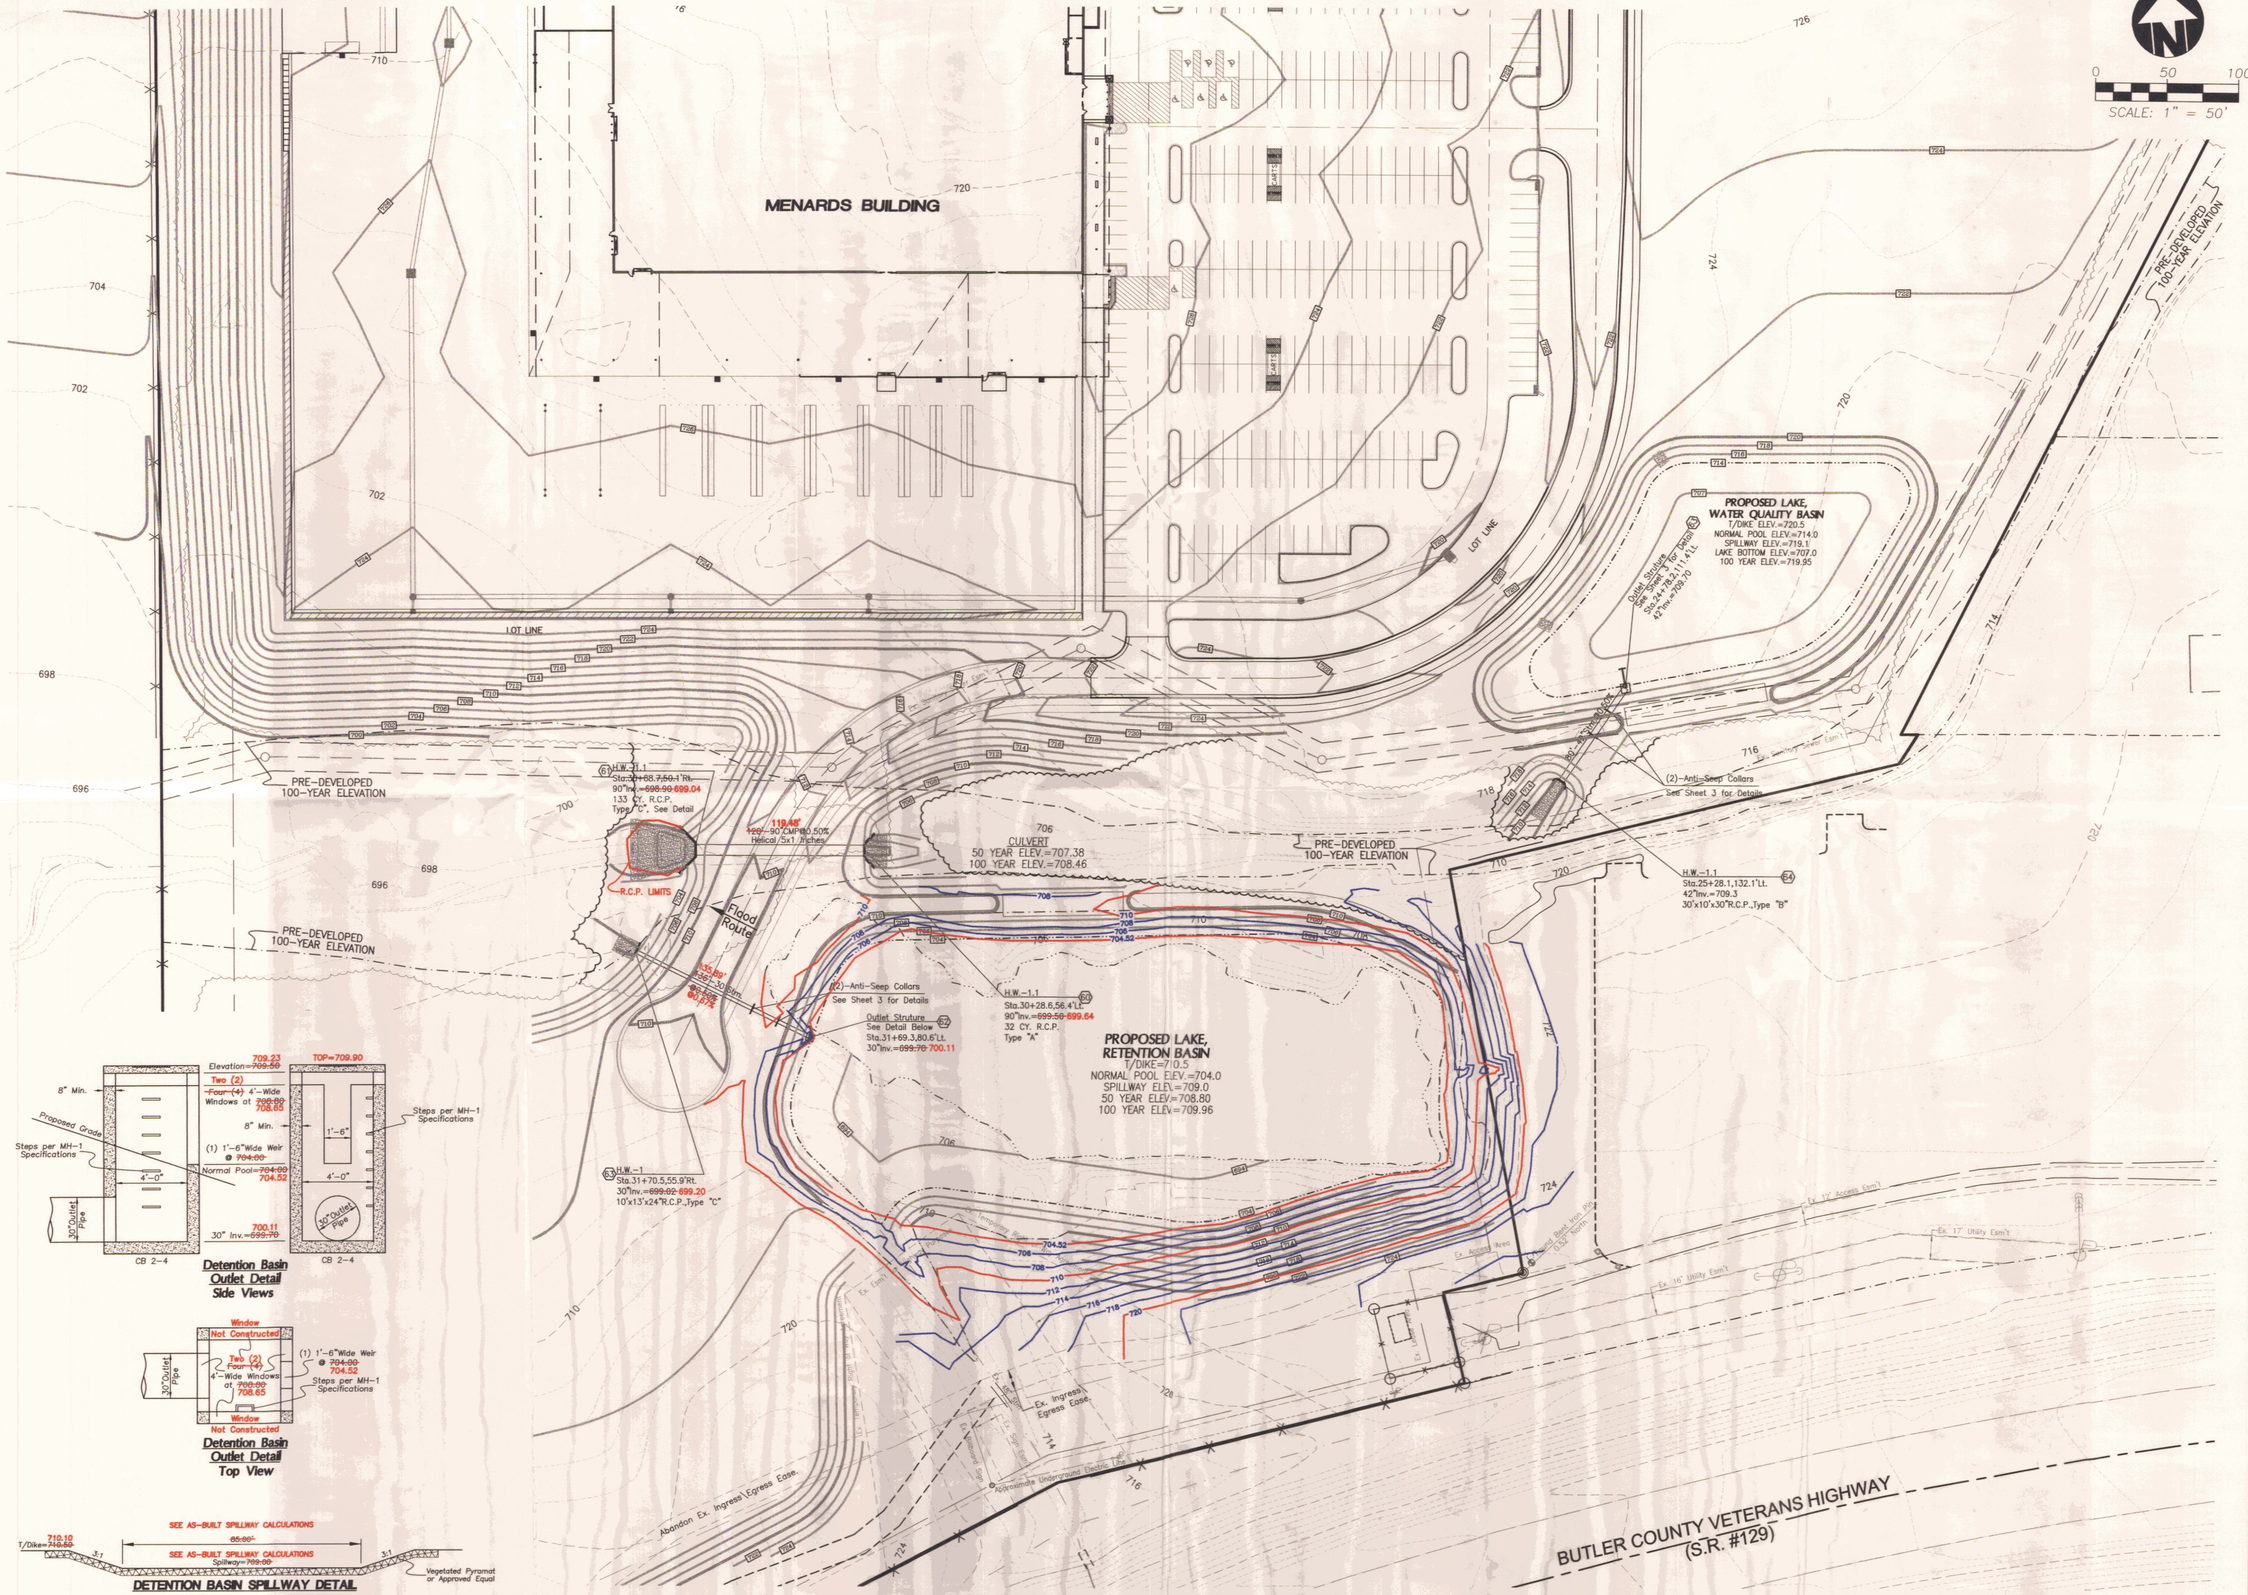

DETENTION BASIN & CULVERT AS-BUILTS

THE FOUNTAINS OF FAIRFIELD TOWNSHIP

SECTION 25, TOWN 2, RANGE 3
FAIRFIELD TOWNSHIP
BUTLER COUNTY OHIO

DETENTION BASIN & CULVERT AS-BUILTS

bayer becker
www.bayerbecker.com
6900 Tylersville Road, Suite A
Mason, OH 45040 - 513.336.6600

Item	Revision Description	Date	Drwn:	Chk:

Drawing: 07M097-000 GRADING
Drawn by: GJK
Checked By:
Issue Date: 8-09-10
Sheet: 1 of 1

IS DOCUMENT AND ALL RELATED DETAIL DRAWINGS, SPECIFICATIONS, AND ELECTRONIC MEDIA PREPARED OR FURNISHED BY BAYER BECKER (BB), ARE INSTRUMENTS OF BB'S PROFESSIONAL SERVICE, AND IS THE EXCLUSIVE PROPERTY OF BB. NO DISCLOSURE, USE, REPRODUCTION, OR DUPLICATION IN WHOLE, OR IN PART, MAY BE MADE WITHOUT WRITTEN PERMISSION OF BB, AND IS DONE SO AT USER'S SOLE RISK. COPYRIGHT - ALL RIGHTS RESERVED.

Plot time: Aug 09, 2010 - 3:17pm
Drawing name: J:\2007\07M097-000\CV\DWG\07M097-000 GRADING.dwg - Layout Tab: Basin As-Builts